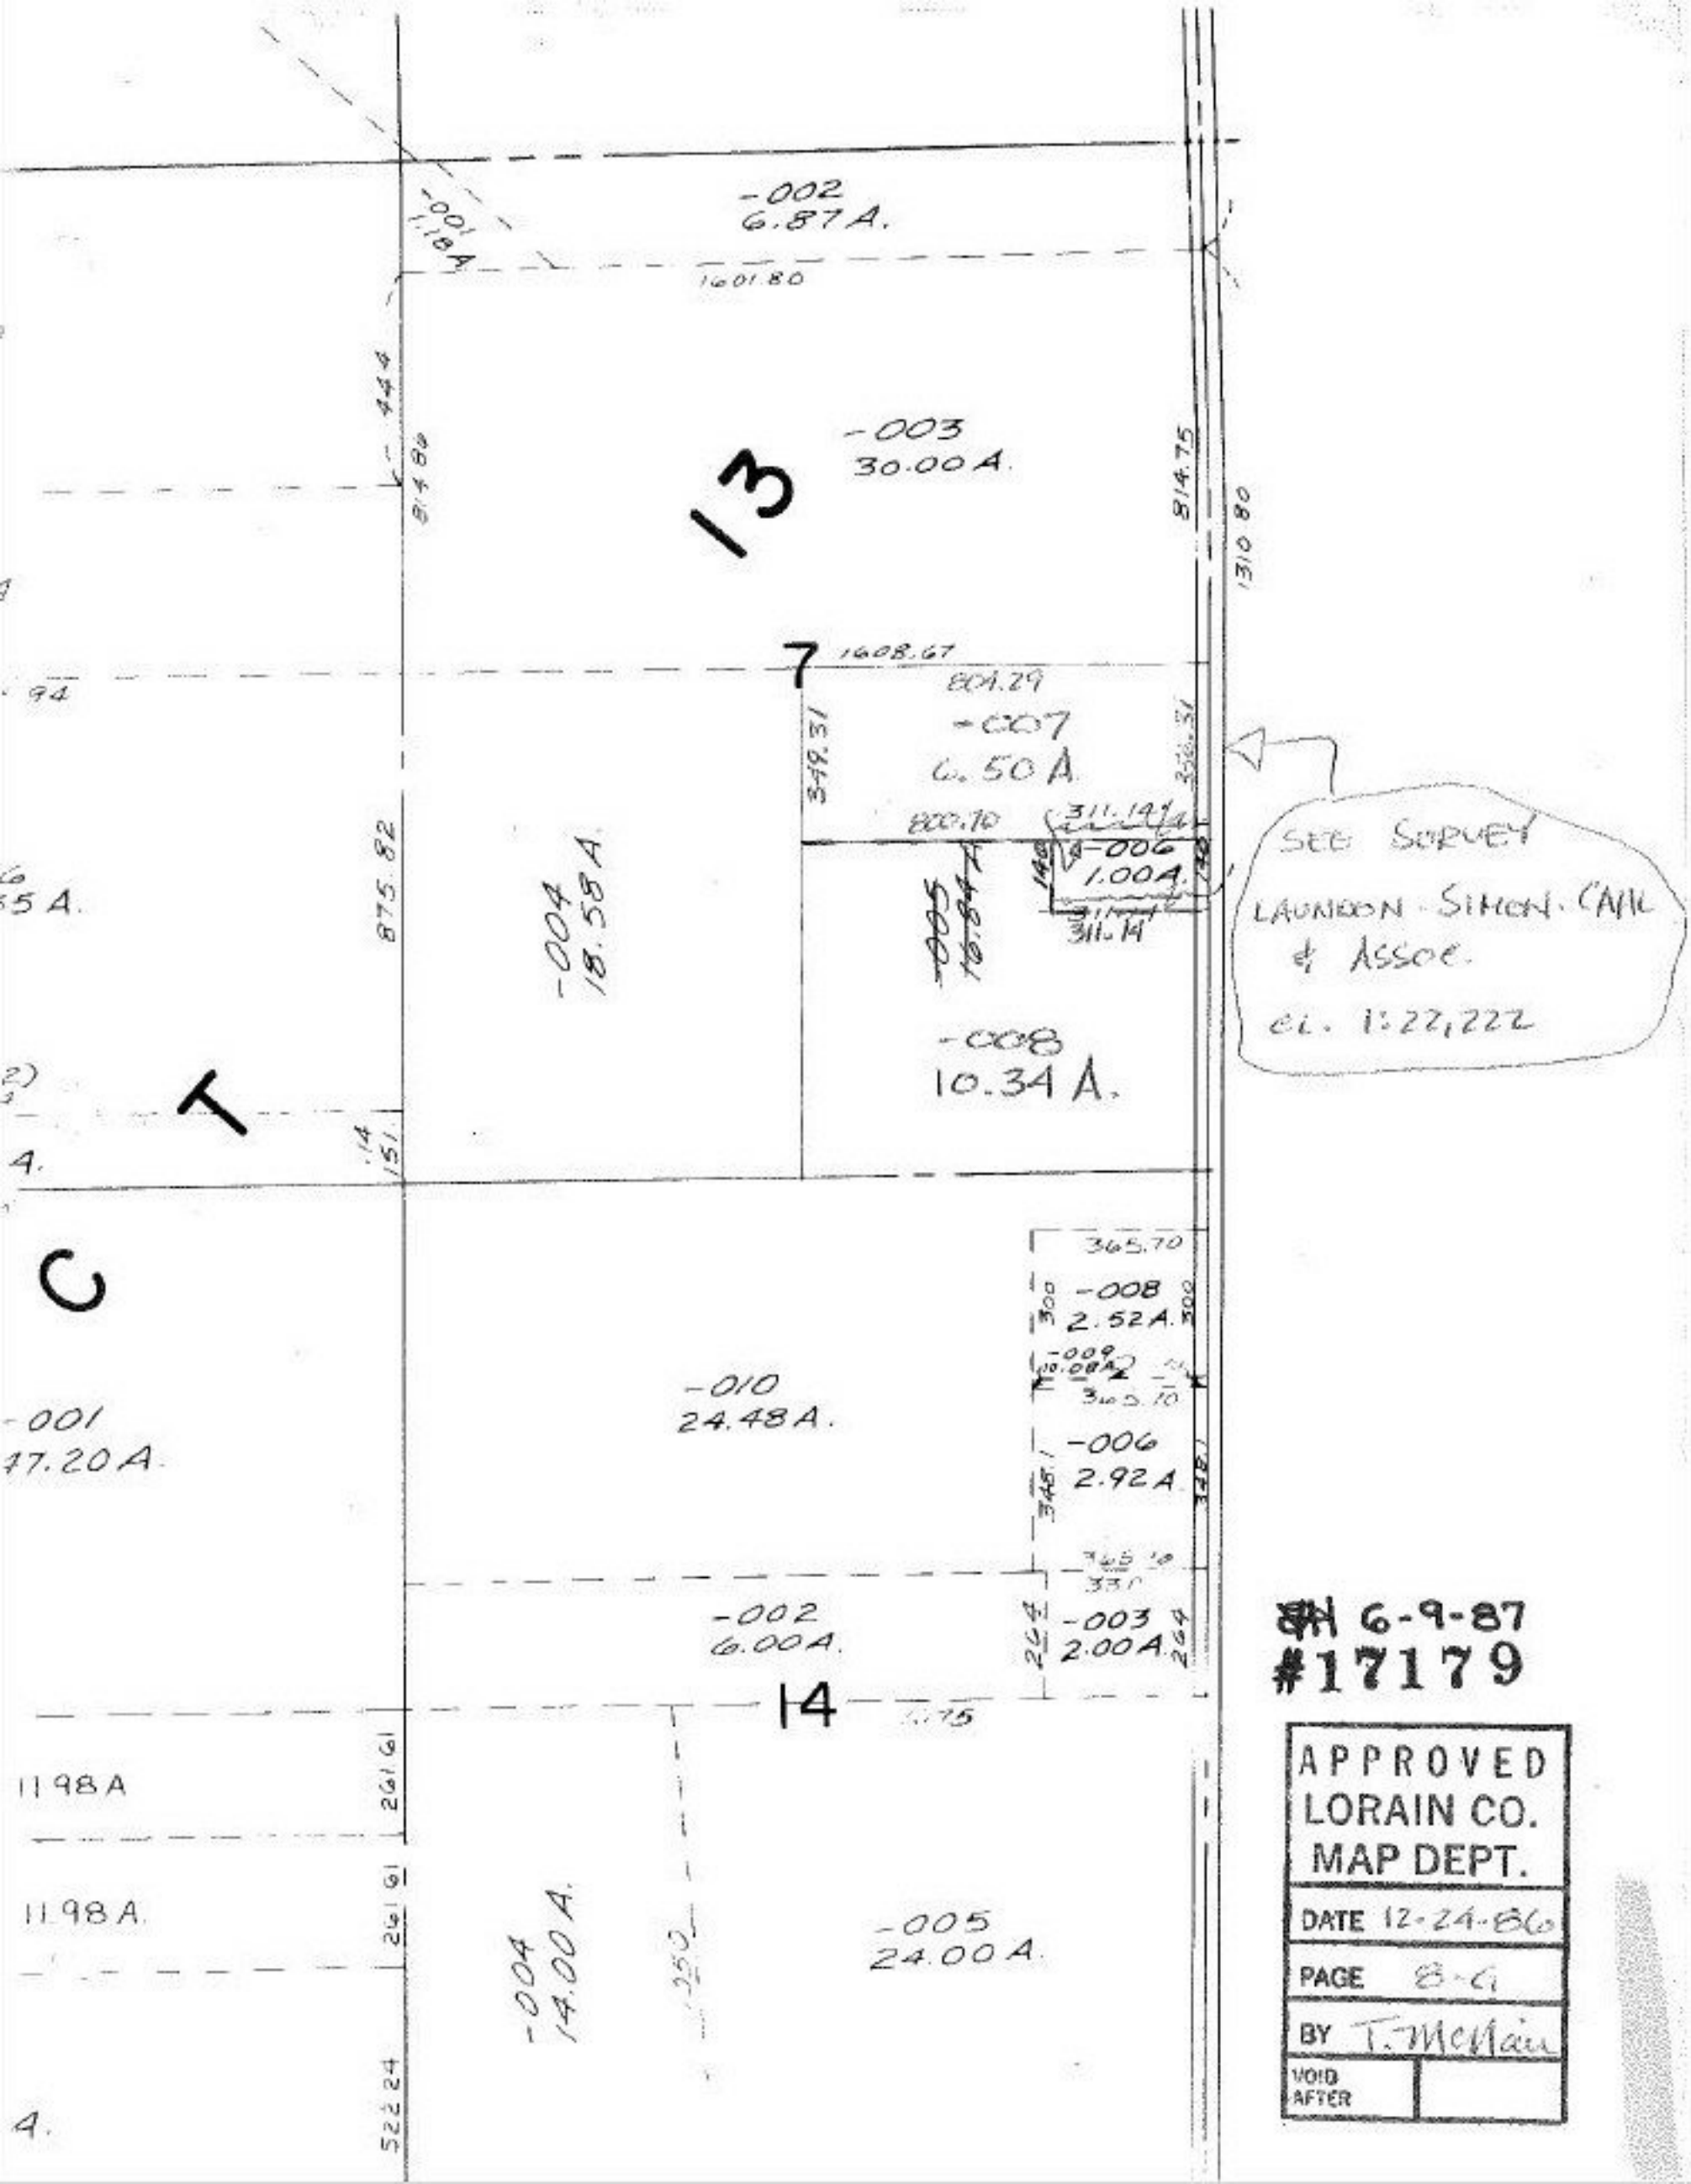
-002
6.87 A.
-001
1.18 A
1601.80
-003
30.00 A.
13
814.75
1310.80
7
1608.67
804.29
-007
6.50 A.
349.31
800.70
311.14
-006
1.00 A.
311.14
-004
18.58 A
875.82
-008
10.34 A.
SEE SURVEY
LAUNDON - SIMON - CAHL
& ASSOC.
CL. 1:22,222
C
-001
47.20 A.
-010
24.48 A.
365.70
-008
2.52 A.
-006
2.92 A.
-002
6.00 A.
-003
2.00 A.
14
11.98 A
11.98 A.
-004
14.00 A.
-005
24.00 A.
6-9-87
#17179
APPROVED
LORAIN CO.
MAP DEPT.
DATE 12-24-86
PAGE 8-G
BY T. McNair
VOID AFTER