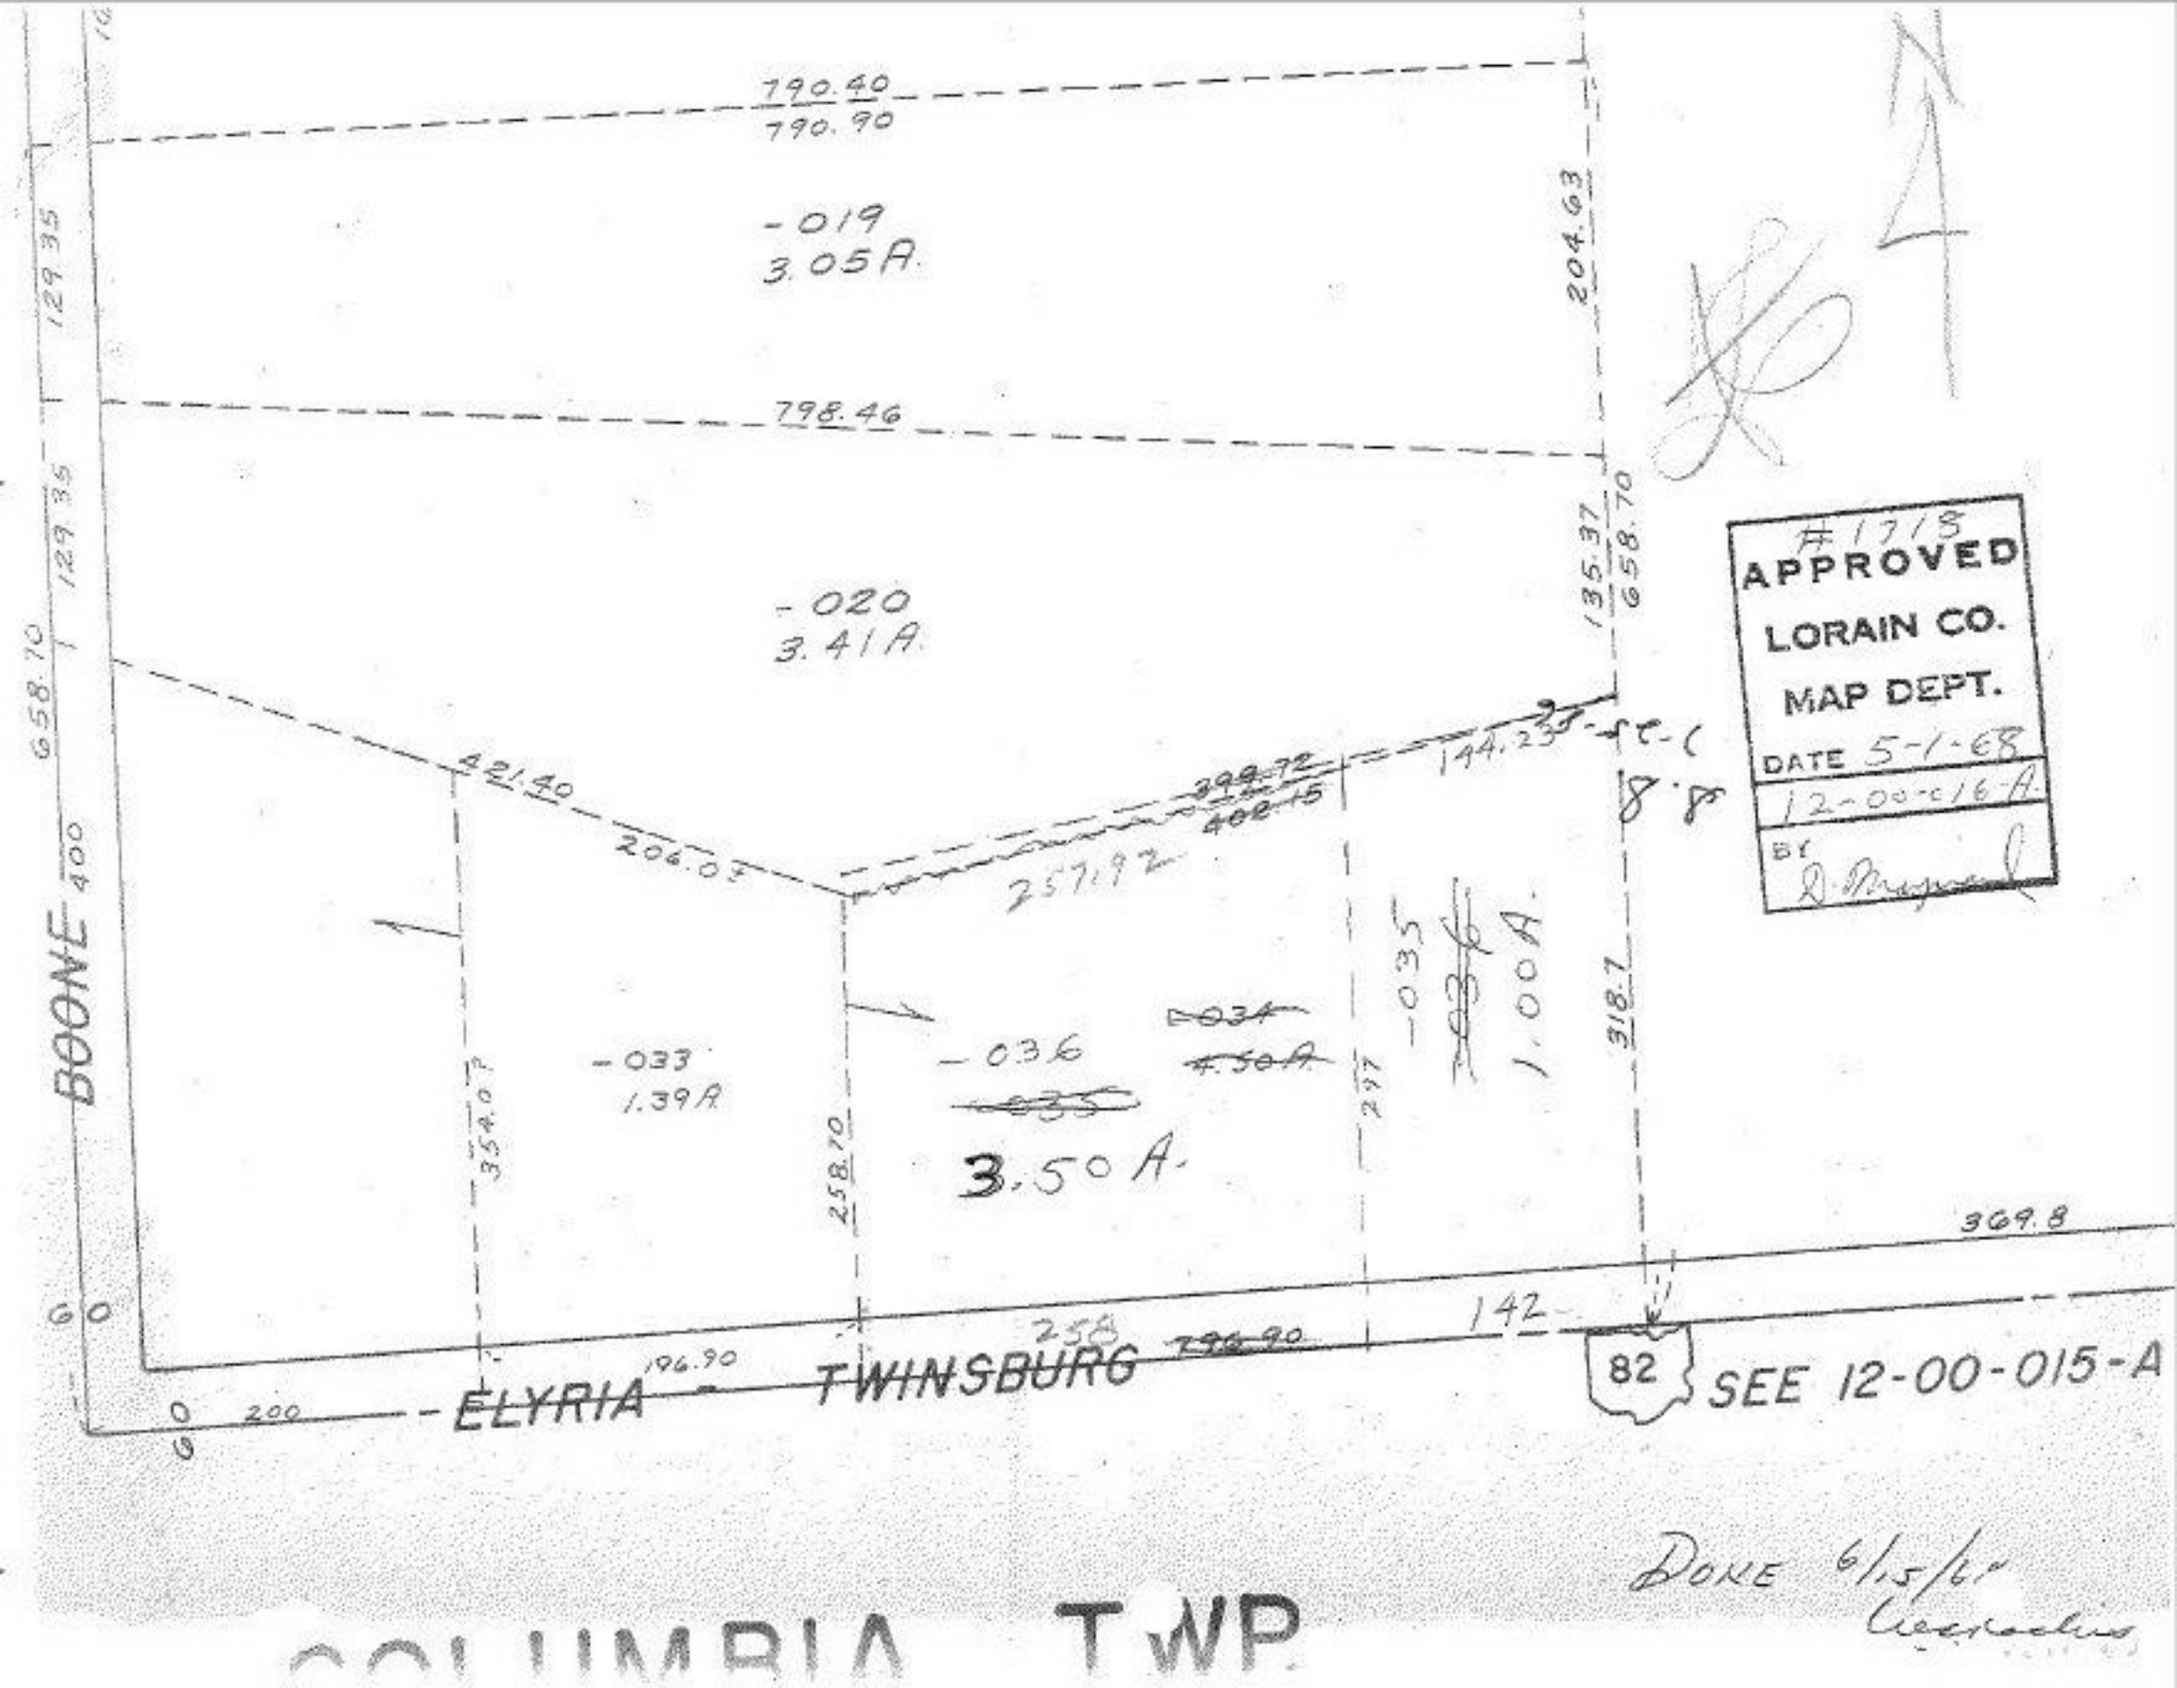
790.40
790.90
-019
3.05A.
204.63
129.35
798.46
-020
3.41A.
135.37
658.70
#1718
APPROVED
LORAIN CO.
MAP DEPT.
DATE 5-1-68
12-00-016-A
BY
421.40
206.07
257.92
144.23
-033
1.39A.
354.07
-036
3.50A.
258.10
-035
1.00A.
318.7
297
369.8
142
258
196.90
BOONE
ELYRIA
TWINSBURG
82
SEE 12-00-015-A
DONE 6/15/68
COLUMBIA TWP.