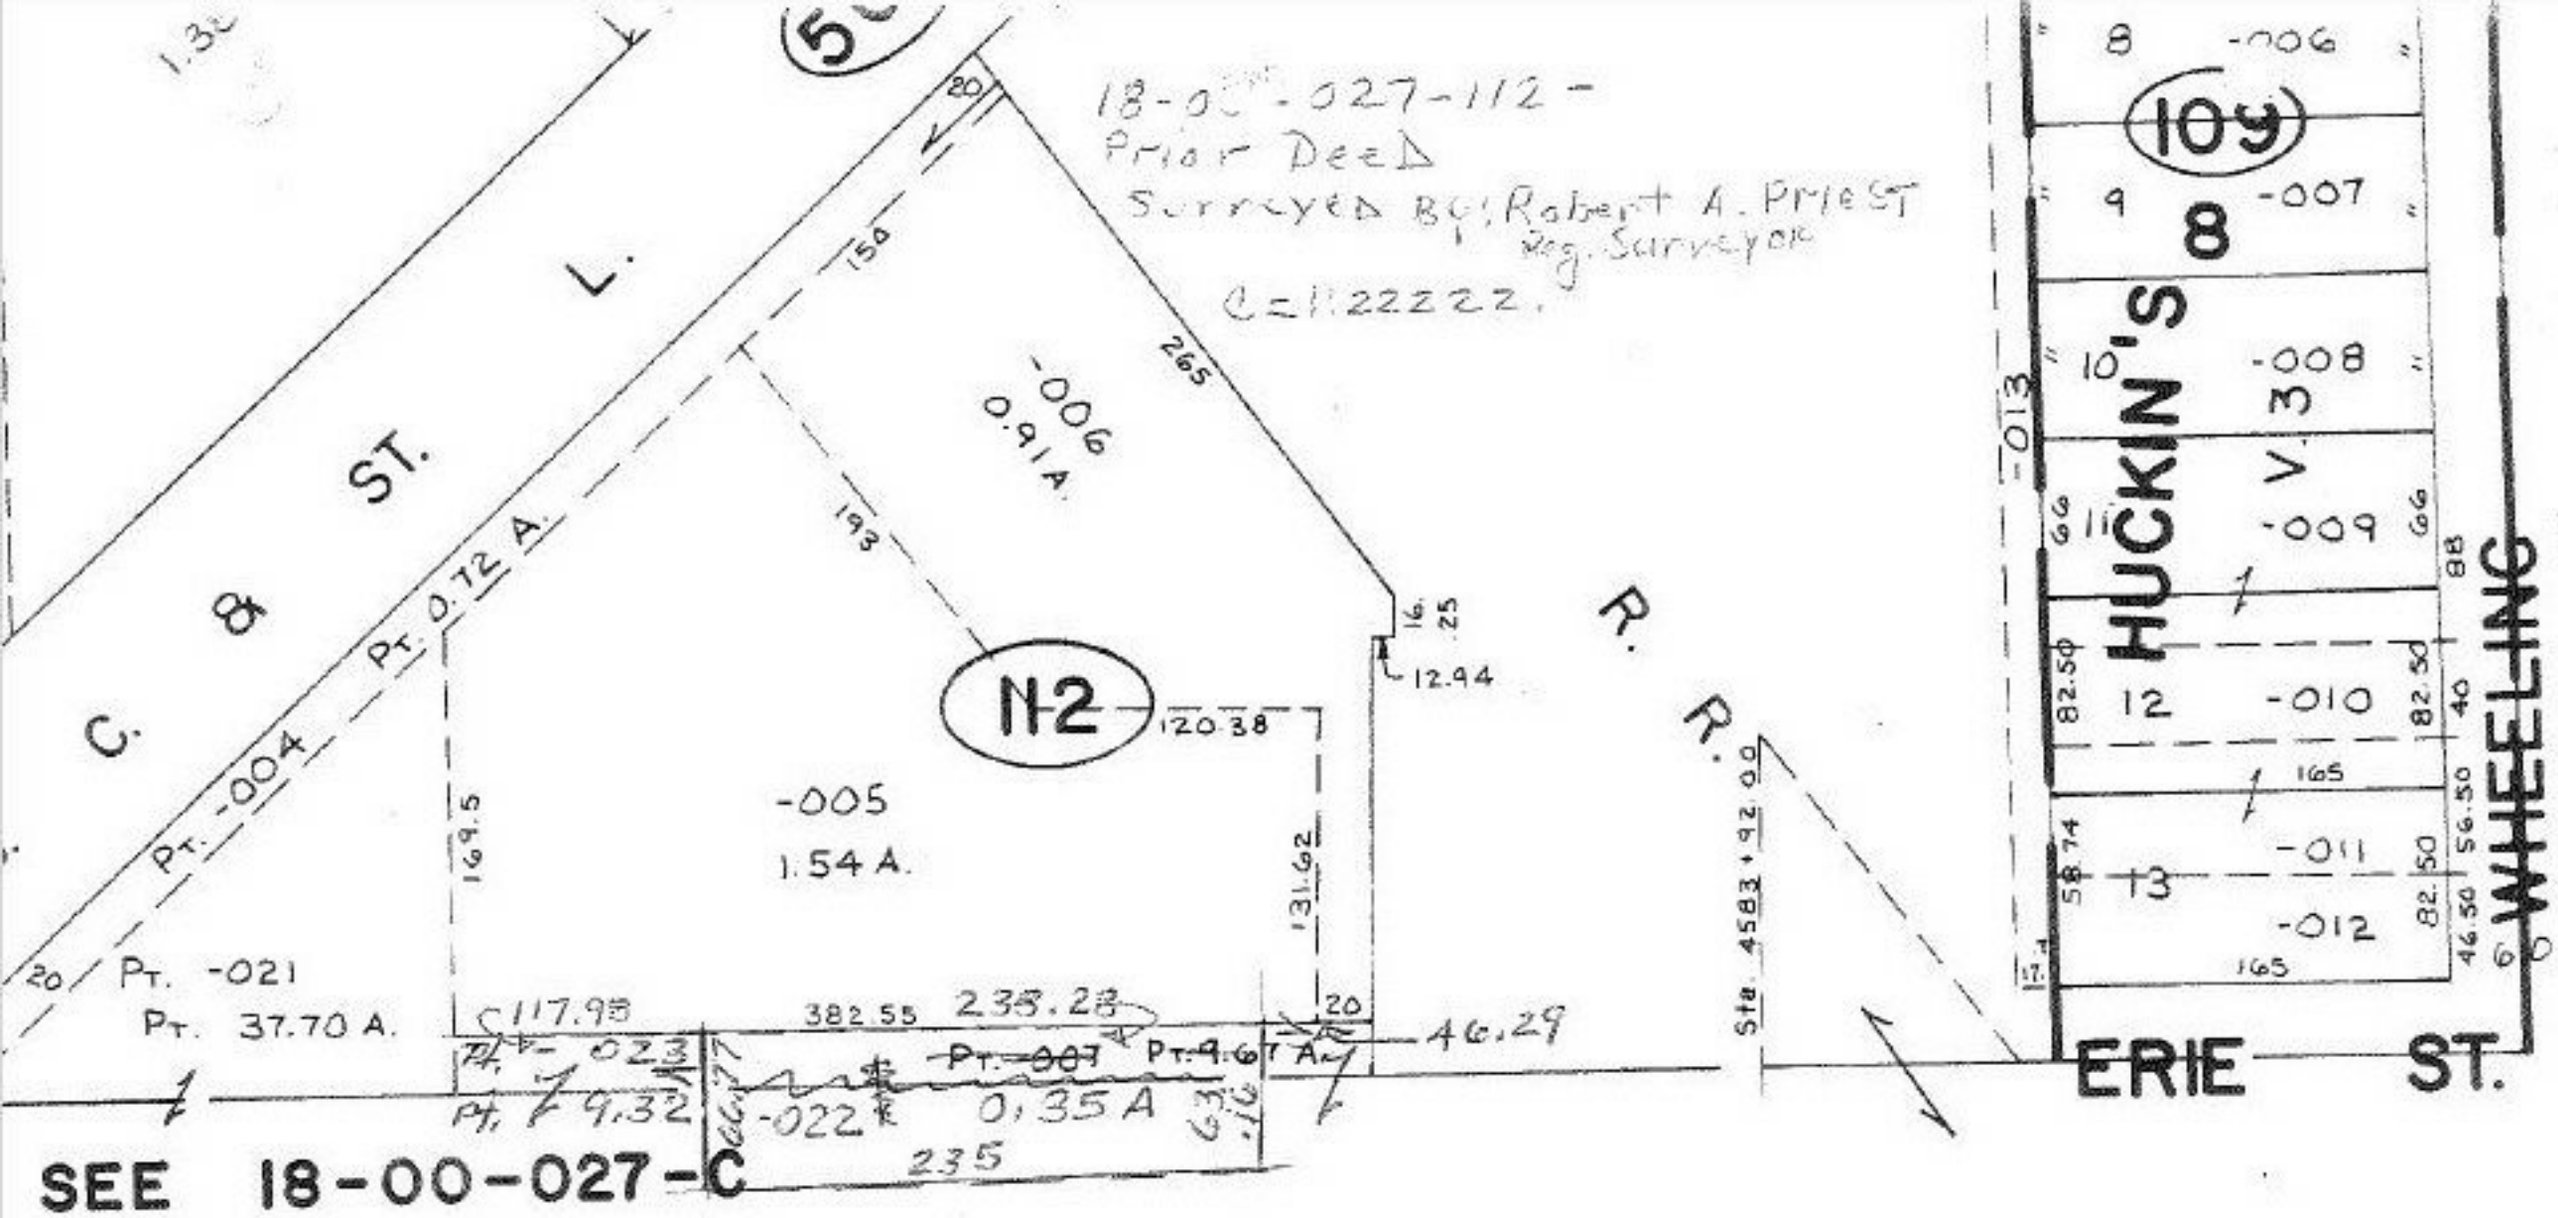

17188
2-23-87

APPROVED
LORAIN CO.
MAP DEPT.
DATE 12-30-86
PAGE 18-00-027-A
BY C. FRANCIS
VOID AFTER 17188

WELLINGTON TWP.

SCALE: 1" = 100'