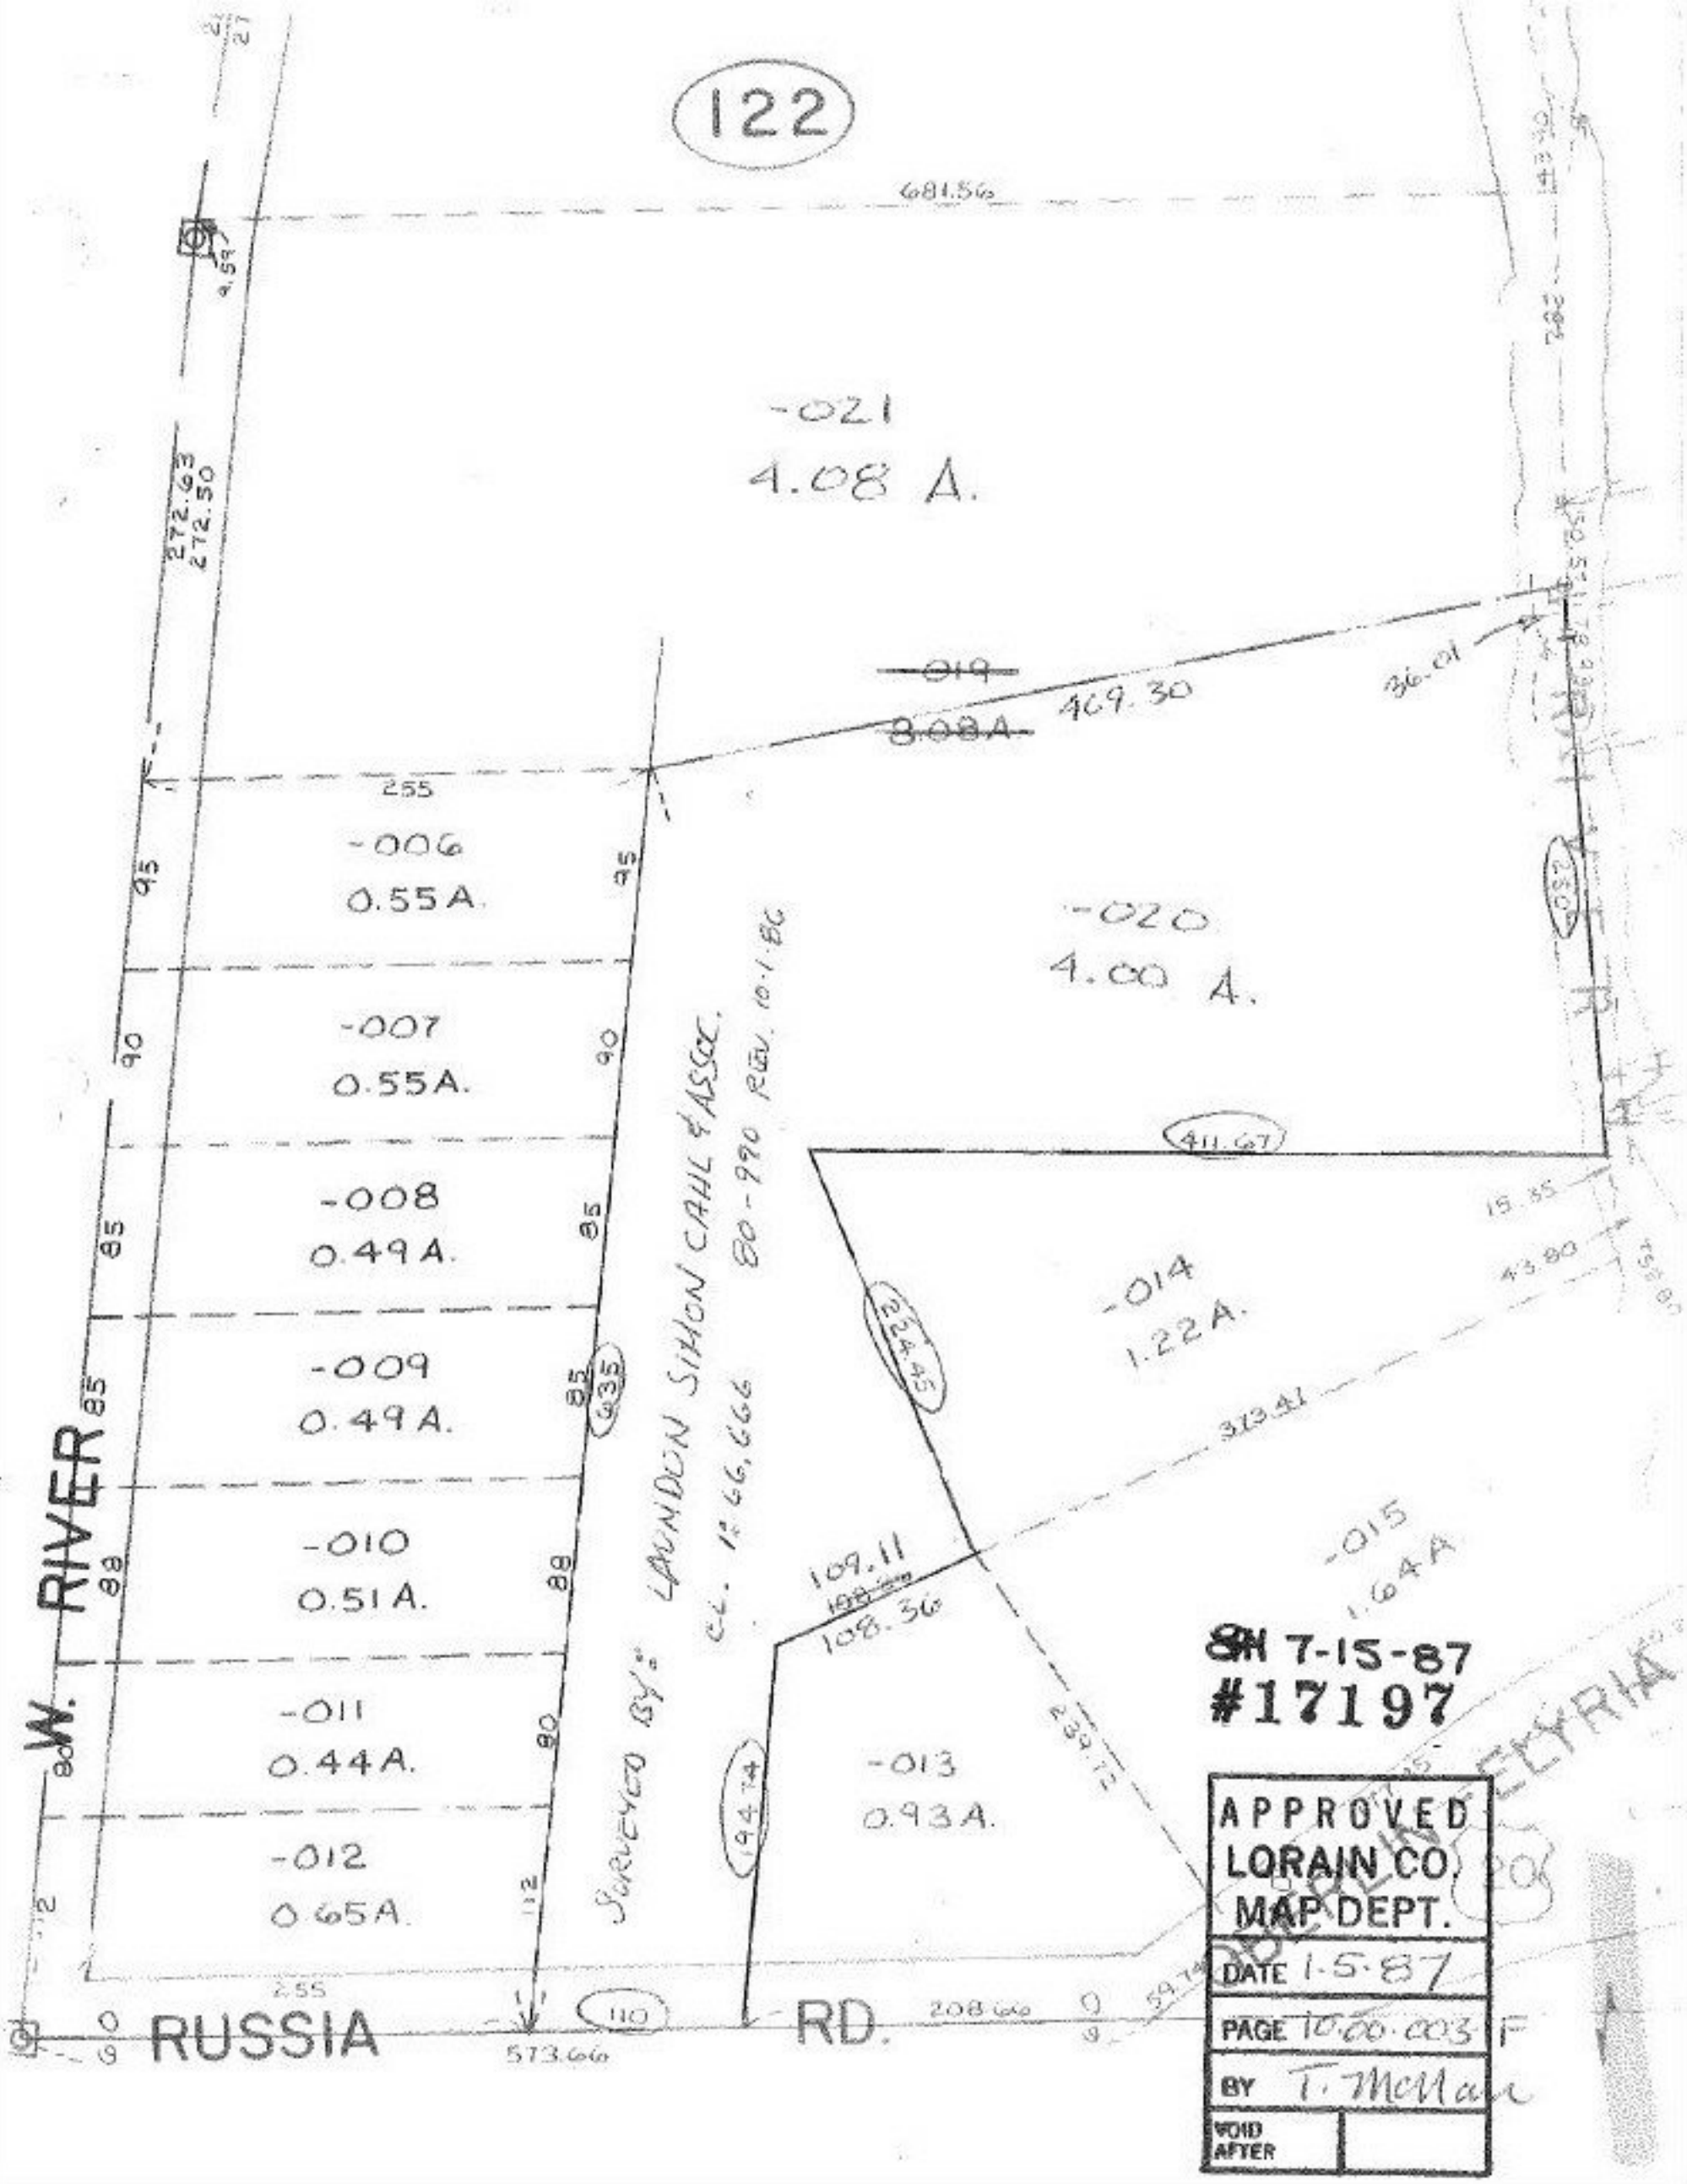

122
681.56
-021
4.08 A.
272.63
272.50
~~-019~~
~~8.08A~~
469.30
36.01
255
-006
0.55A.
-007
0.55A.
-008
0.49A.
-009
0.49A.
-010
0.51A.
-011
0.44A.
-012
0.65A.
-020
4.00 A.
411.67
-014
1.22A.
224.45
373.41
-015
1.64A
109.11
108.36
-013
0.93A.
194.74
239.72
LAUNDON SIMON CAHL & ASSOC.
80-990 REV. 10-1-86
SURVEYED BY:
CL. 1:66,666
W. RIVER
RUSSIA RD.
573.66
208.66
110
SH 7-15-87
#17197
APPROVED
LORAIN CO.
MAP DEPT.
DATE 1-5-87
PAGE 10.00.003 F
BY T. McMan
VOID AFTER