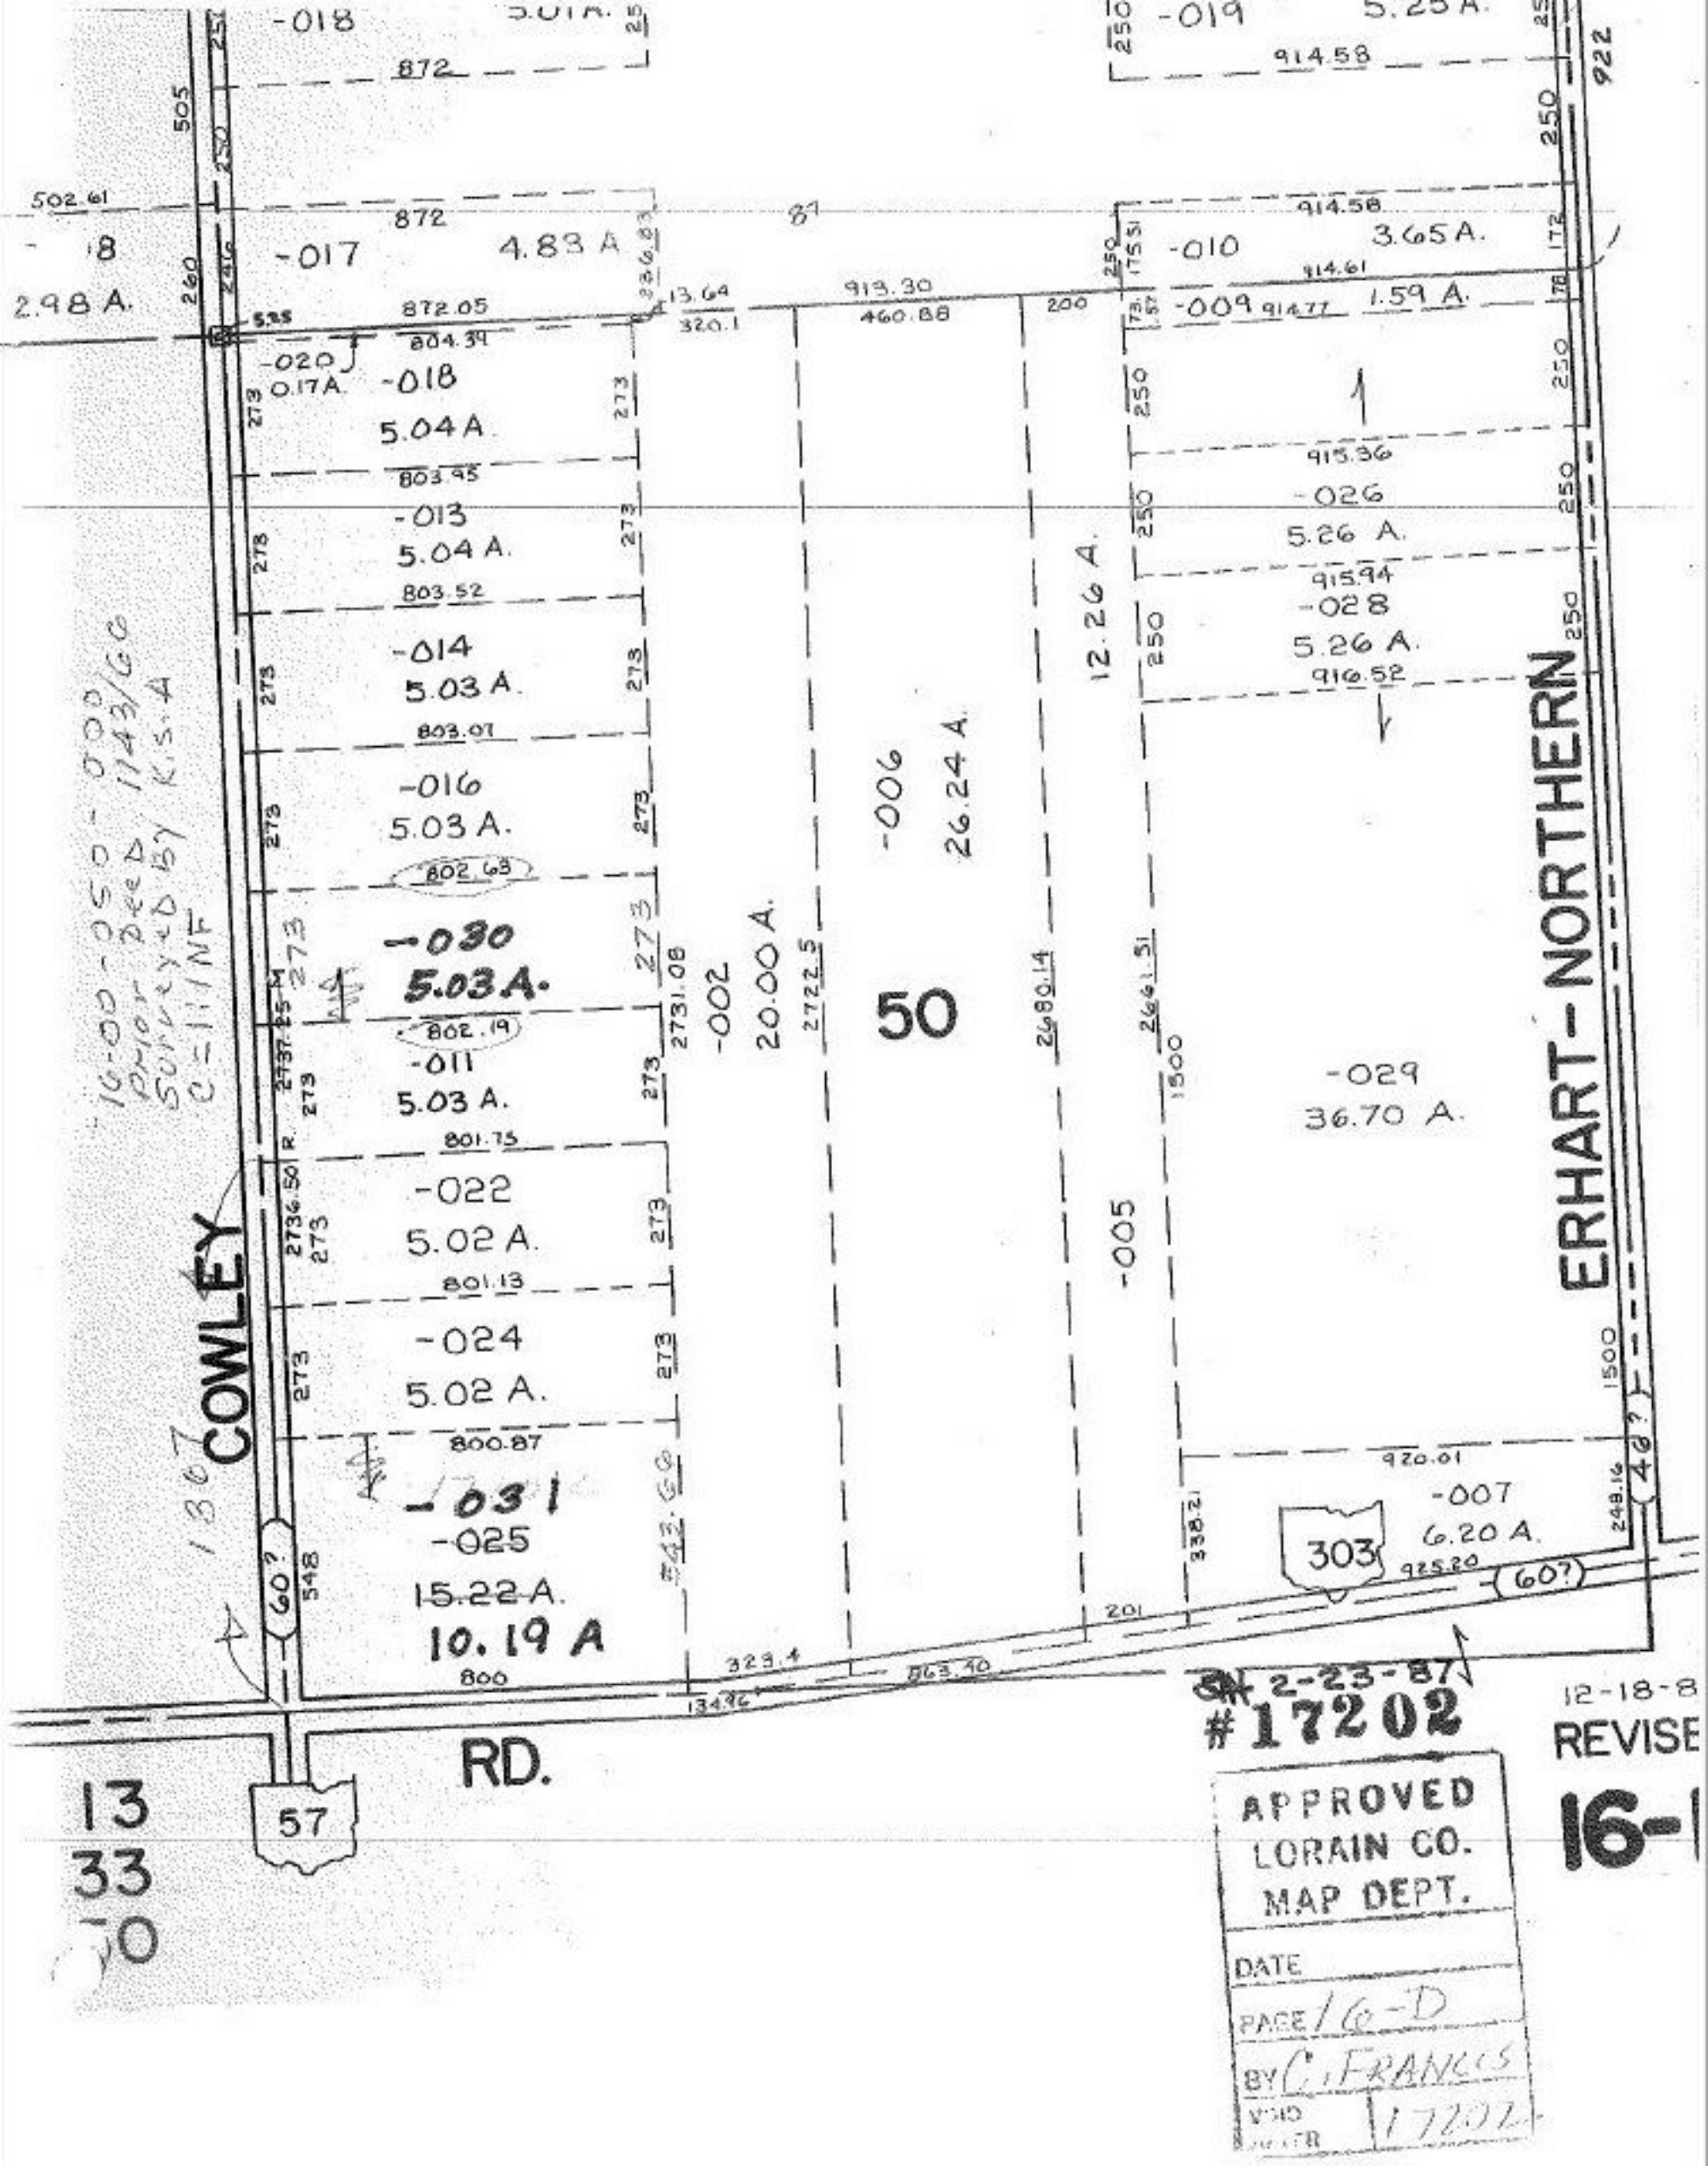

-018
5.01 A.
872
-019
5.25 A.
914.58
922
502.61
872
-017
4.83 A
914.58
-010
3.65 A.
2.98 A.
872.05
13.64
913.30
460.88
-009
914.77
1.59 A.
804.39
-020
0.17 A.
-018
5.04 A.
803.95
-013
5.04 A.
803.52
-014
5.03 A.
803.07
-016
5.03 A.
802.63
-030
5.03 A.
802.19
-011
5.03 A.
801.75
-022
5.02 A.
801.13
-024
5.02 A.
800.87
-031
-025
15.22 A.
10.19 A
800
-006
26.24 A.
12.26 A.
-002
20.00 A.
50
-005
915.36
-026
5.26 A.
915.94
-028
5.26 A.
916.52
-029
36.70 A.
-007
6.20 A.
925.20
303
COWLEY
ERHART-NORTHERN
RD.
57
60?
46?
16-00-050-000
Prior Deed 1743/66
Surveyed By K.S.A
C=1:1NF
13
33
50
2-23-87
#17202
12-18-8
REVISE
16-
APPROVED
LORAIN CO.
MAP DEPT.
DATE
PAGE 16-D
BY C. FRANCIS
VOID
17202