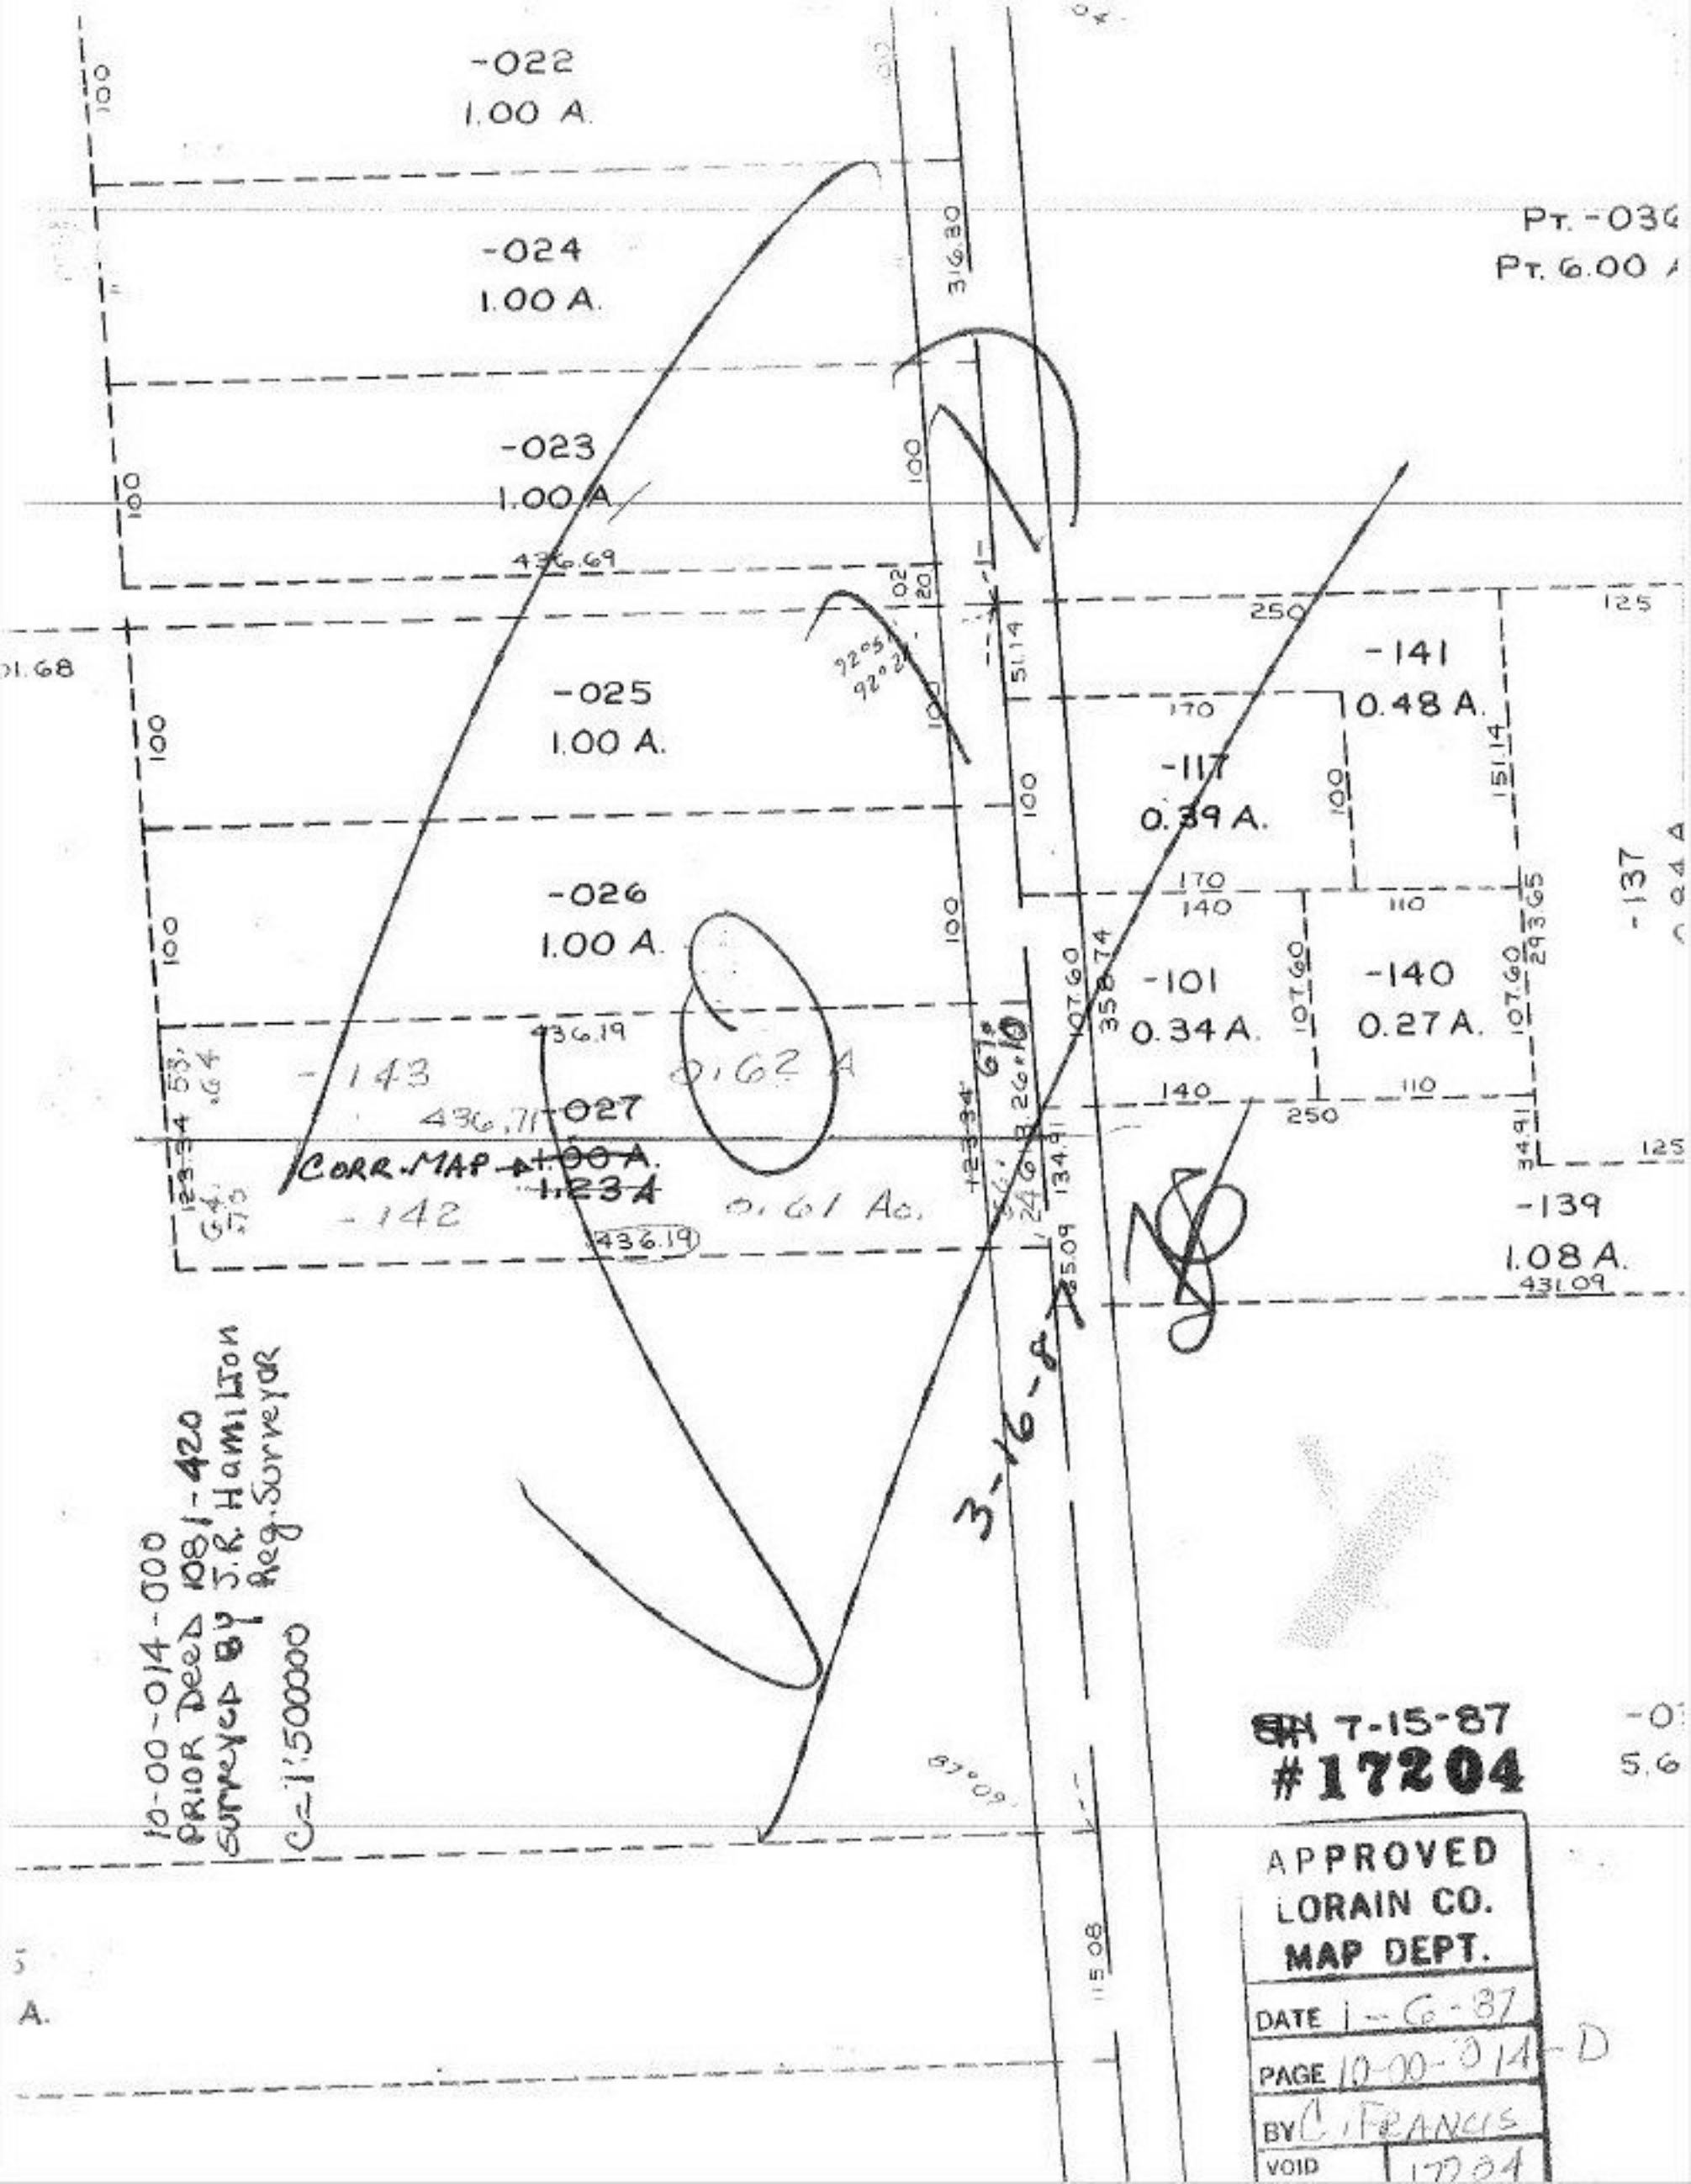
-022
1.00 A.
-024
1.00 A.
-023
1.00 A.
-025
1.00 A.
-026
1.00 A.
-027
1.00 A.
1.23 A
CORR. MAP
-141
0.48 A.
-117
0.39 A.
-101
0.34 A.
-140
0.27 A.
-139
1.08 A.
-137
-143
-142
0.62 A
0.61 Ac.
Pt. -036
Pt. 6.00 A
3-16-87
10-00-014-000
PRIOR DEED 1081-420
SURVEYED BY J.R. Hamilton
Reg. Surveyor
C=1:500000
7-15-87
#17204
APPROVED
LORAIN CO.
MAP DEPT.
DATE 1-6-87
PAGE 10-00-014-D
BY C. FRANCIS
VOID 17204