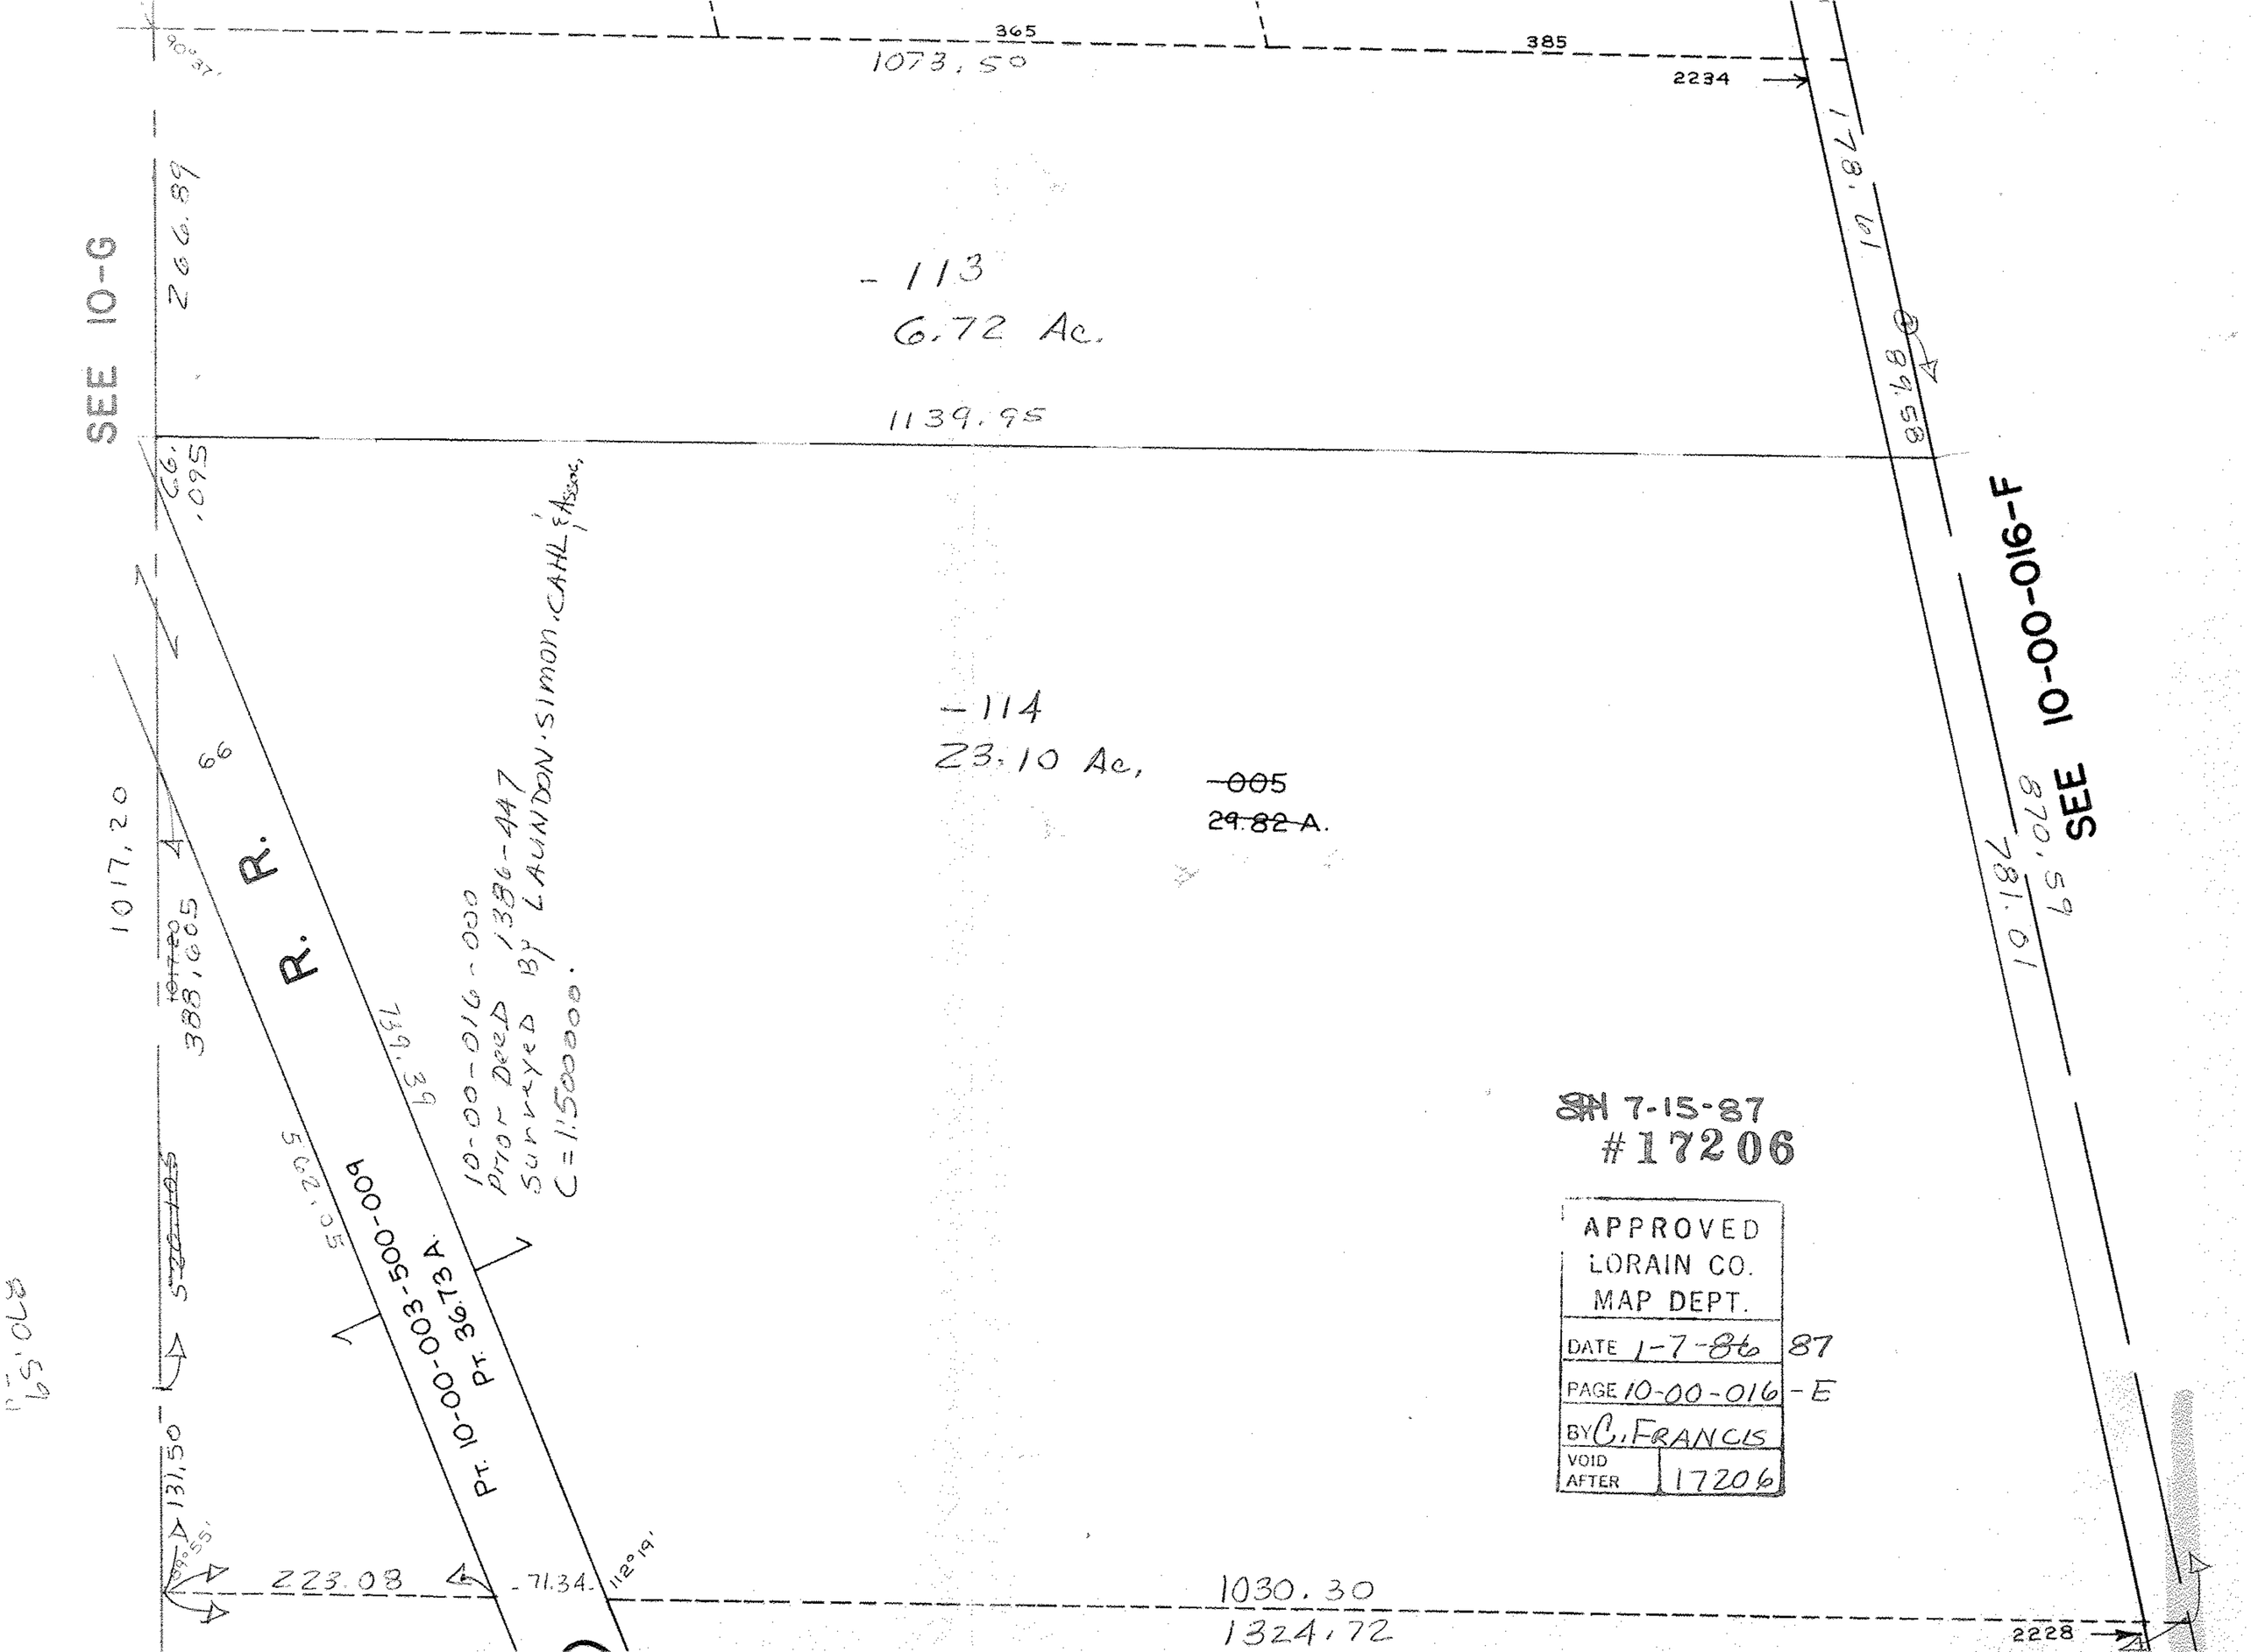

SEE 10-G
SEE 10-00-016-F
365
385
1073.50
2234
266.89
-113
6.72 Ac.
1139.95
178.61
89.58
66.095
-114
23.10 Ac.
~~-005~~
~~29.82 A.~~
66
1017.20
388.605
R.
739.39
562.05
10-00-016-000
Prior Deed 1386-447
Surveyed By LAUNDON, SIMON, CAHL & Assoc.
C=1:500000.
Pt. 10-00-003-500-009
Pt. 36.73 A.
870.59
781.01
131.50
223.08
71.34
112°19'
1030.30
1324.72
2228
SH 7-15-87
#17206
APPROVED
LORAIN CO.
MAP DEPT.
DATE 1-7-~~86~~ 87
PAGE 10-00-016-E
BY C. FRANCIS
VOID AFTER 17206