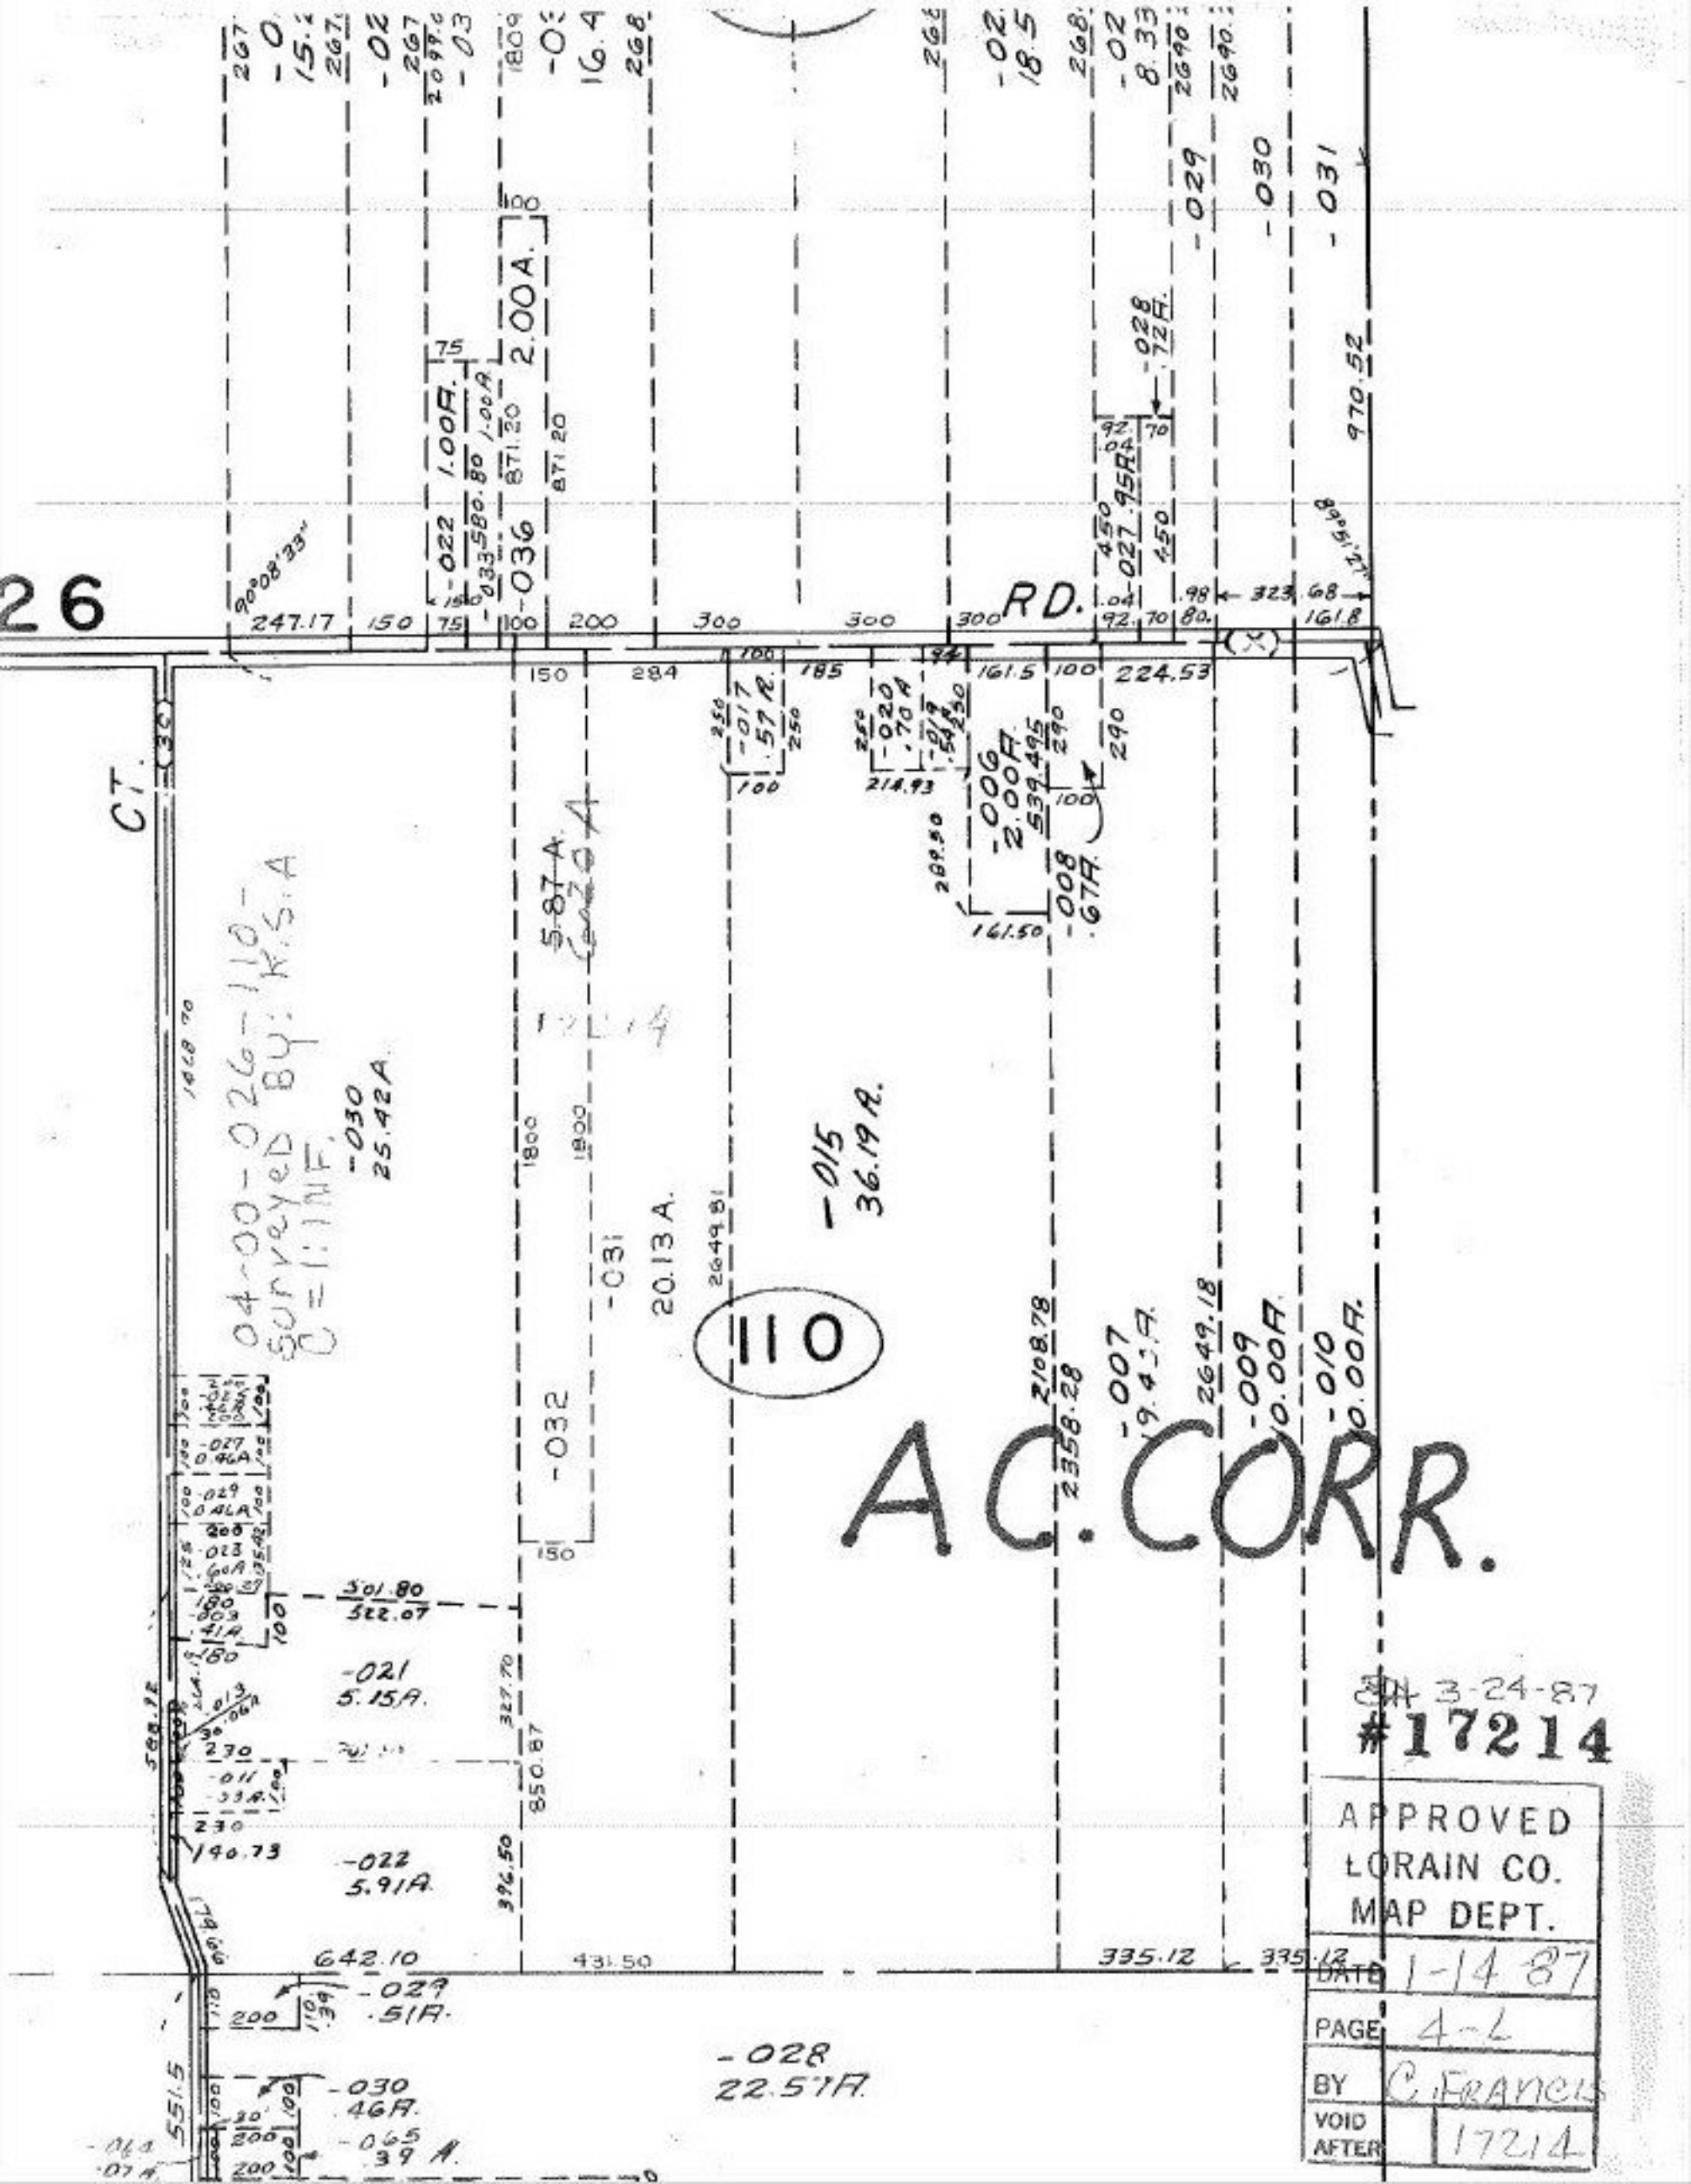
26
RD.
CT.
110
AC.CORR.
04-00-026-110-
Surveyed By: K.S.A
C=1:1NF.
-015
36.19A.
-030
25.42A.
-031
20.13 A.
-032
-021
5.15A.
-022
5.91A.
-028
22.57A.
-029
.51A.
-030
.46A.
-065
.39 A.
-006
2.00A.
-008
.67A.
-007
19.43A.
-009
10.00A.
-010
10.00A.
-027
.95A.
-028
.72A.
-029
-030
-031
-036
2.00A.
1.00A.
-022
-033
-017
.57A.
-020
.70A.
-019
.54A.
-029
-030
-031
-032
-036
-027
0.46A.
-029
0.46A.
-023
.60A.
-003
.41A.
-011
.33A.
-064
.07A.
247.17
150
75
100
200
300
300
300
161.5
100
224.53
161.8
323.68
970.52
2649.81
2108.78
2358.28
2649.18
2690
2690
2099.6
1809
1800
1800
1468.70
501.80
522.07
327.70
850.87
396.50
642.10
431.50
335.12
335.12
551.5
90°08'33"
3-24-87
#17214
APPROVED
LORAIN CO.
MAP DEPT.
DATE 1-14-87
PAGE 4-L
BY C. FRANCIS
VOID AFTER 17214