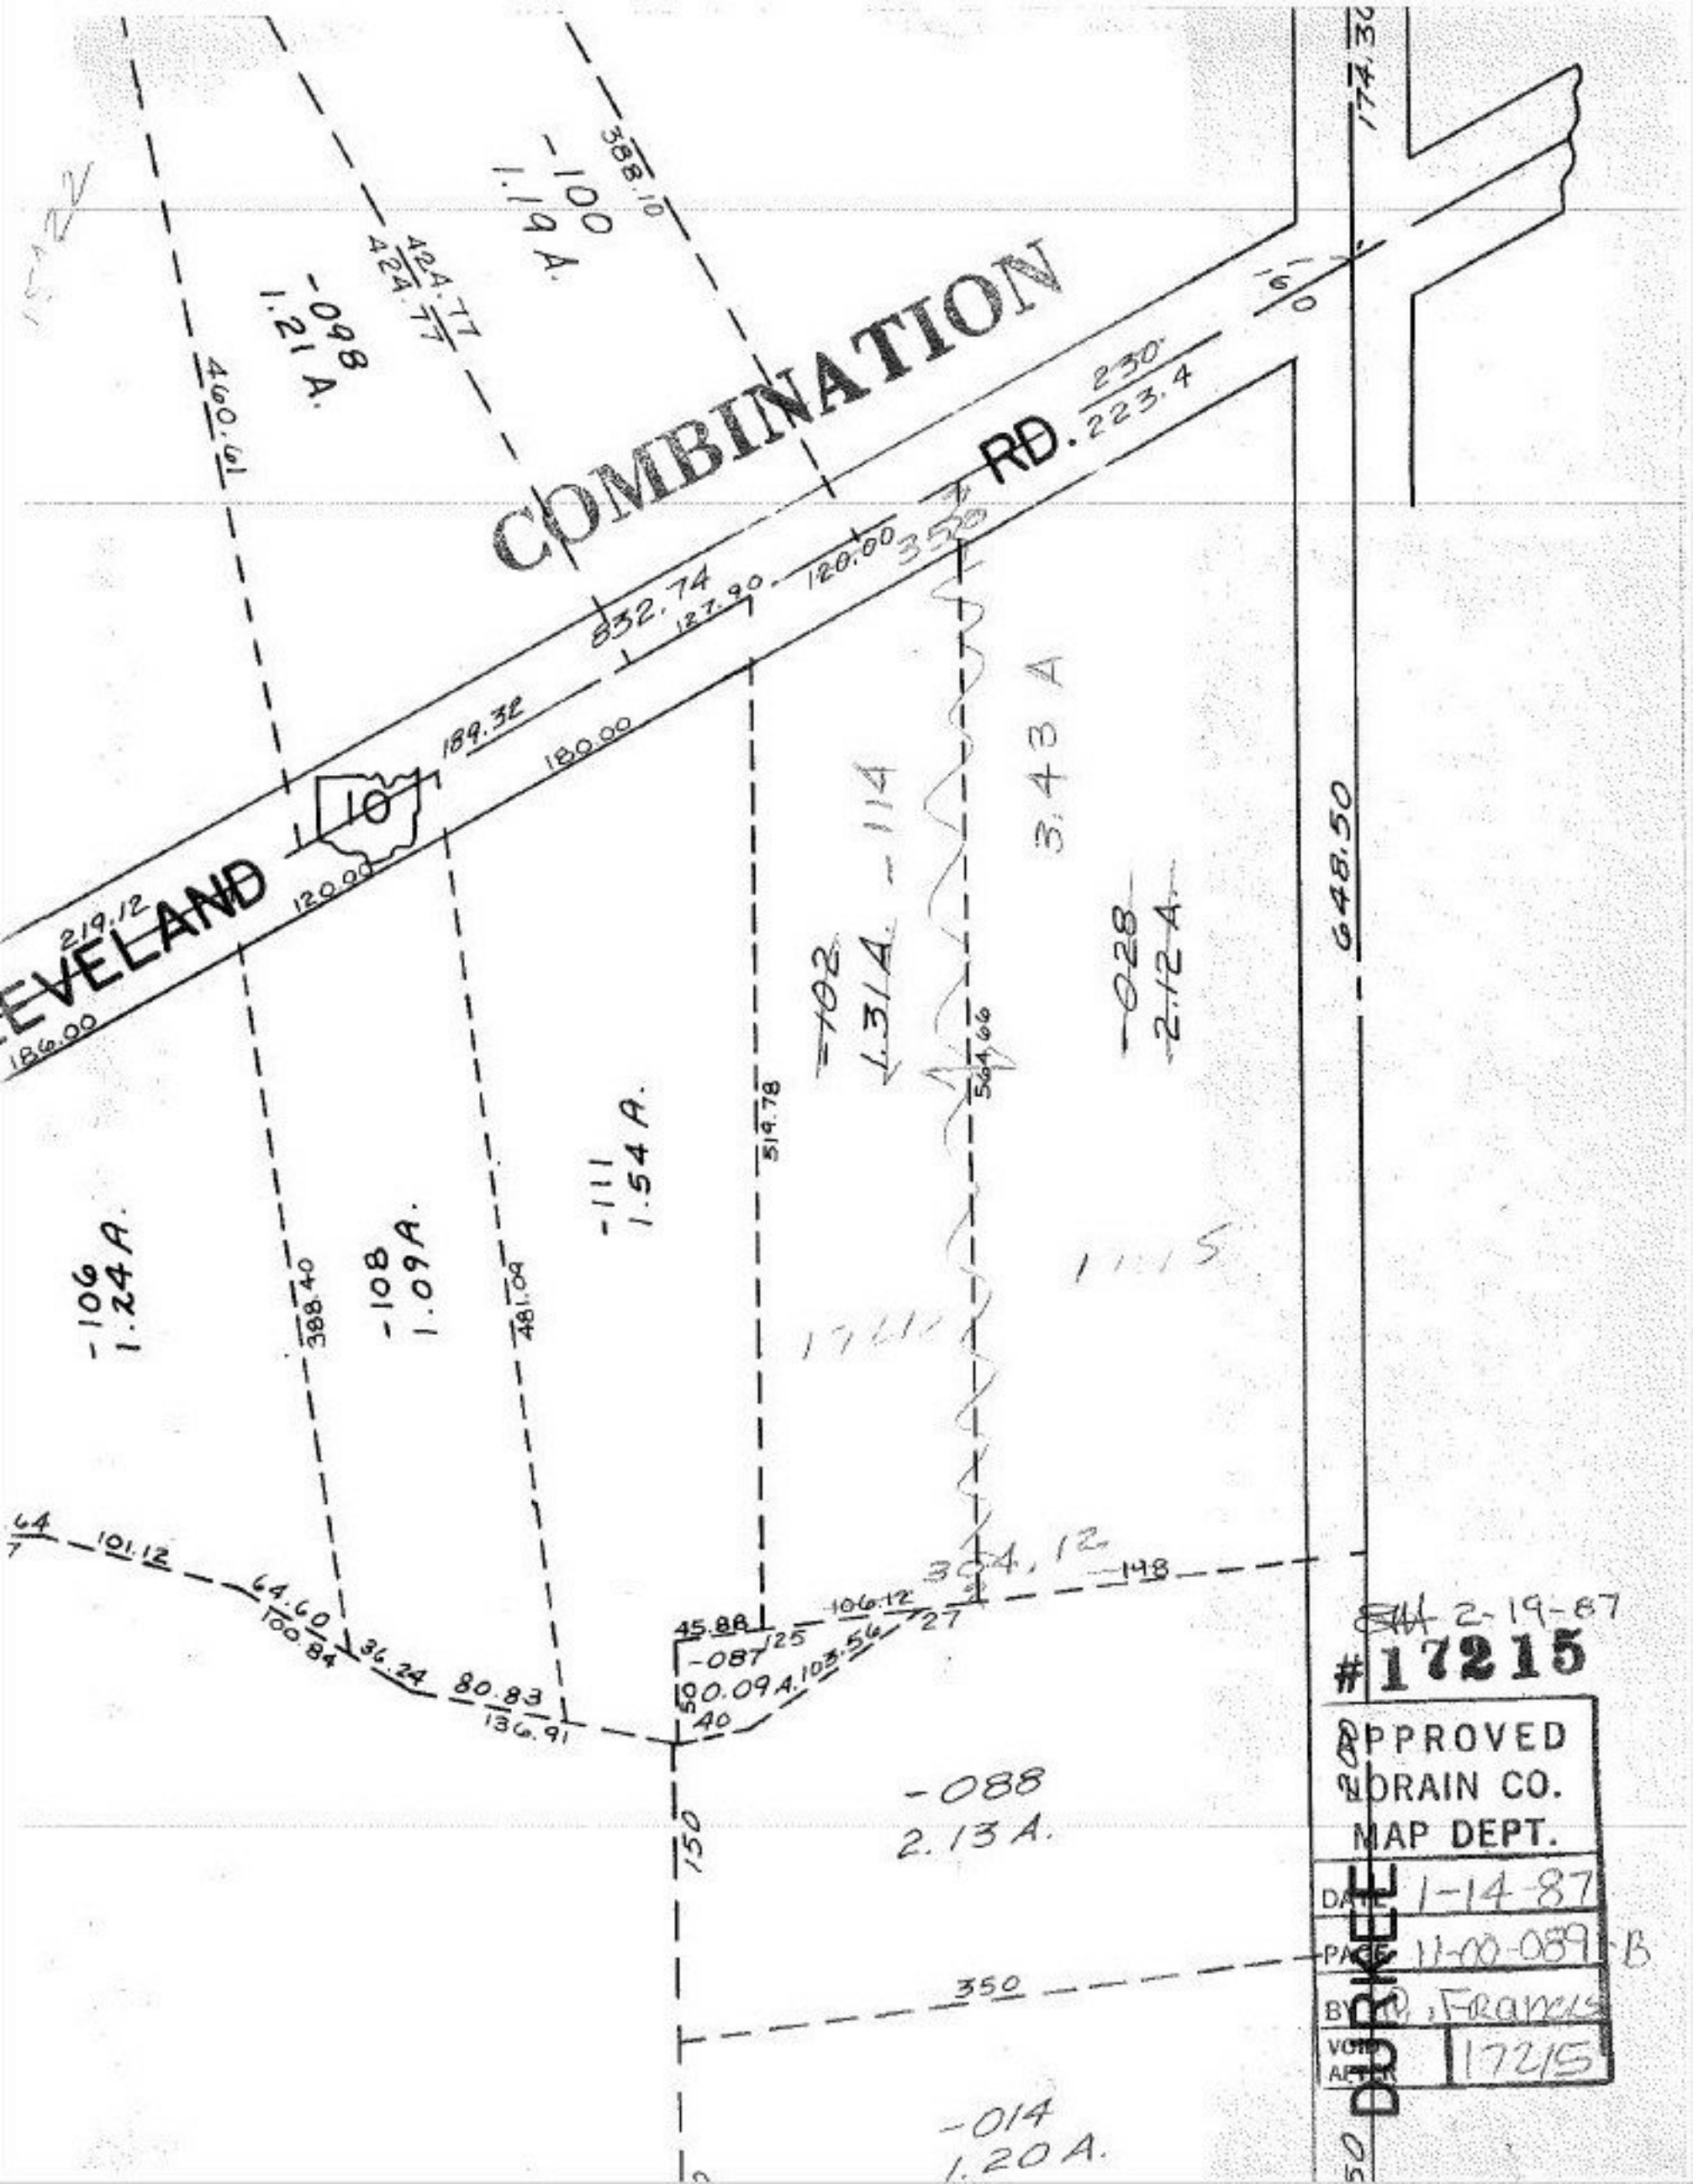
COMBINATION
RD.
EVELAND
10
-100
1.19 A.
-098
1.21 A.
-106
1.24 A.
-108
1.09 A.
-111
1.54 A.
-102
1.31 A.
-114
3.43 A
-028
2.12 A.
-088
2.13 A.
-014
1.20 A.
-087
0.09 A.
388.10
424.77
424.77
460.61
832.74
127.90
120.00
189.32
180.00
219.12
186.00
120.00
388.40
481.09
519.78
564.66
230
223.4
648.50
174.30
101.12
64.60
100.84
36.24
80.83
136.91
45.88
125
106.12
27
40
150
350
2-19-87
#17215
APPROVED
LORAIN CO.
MAP DEPT.
DATE 1-14-87
PAGE 11-00-089-B
BY R. Francis
VOID AFTER 17215
DURKEE