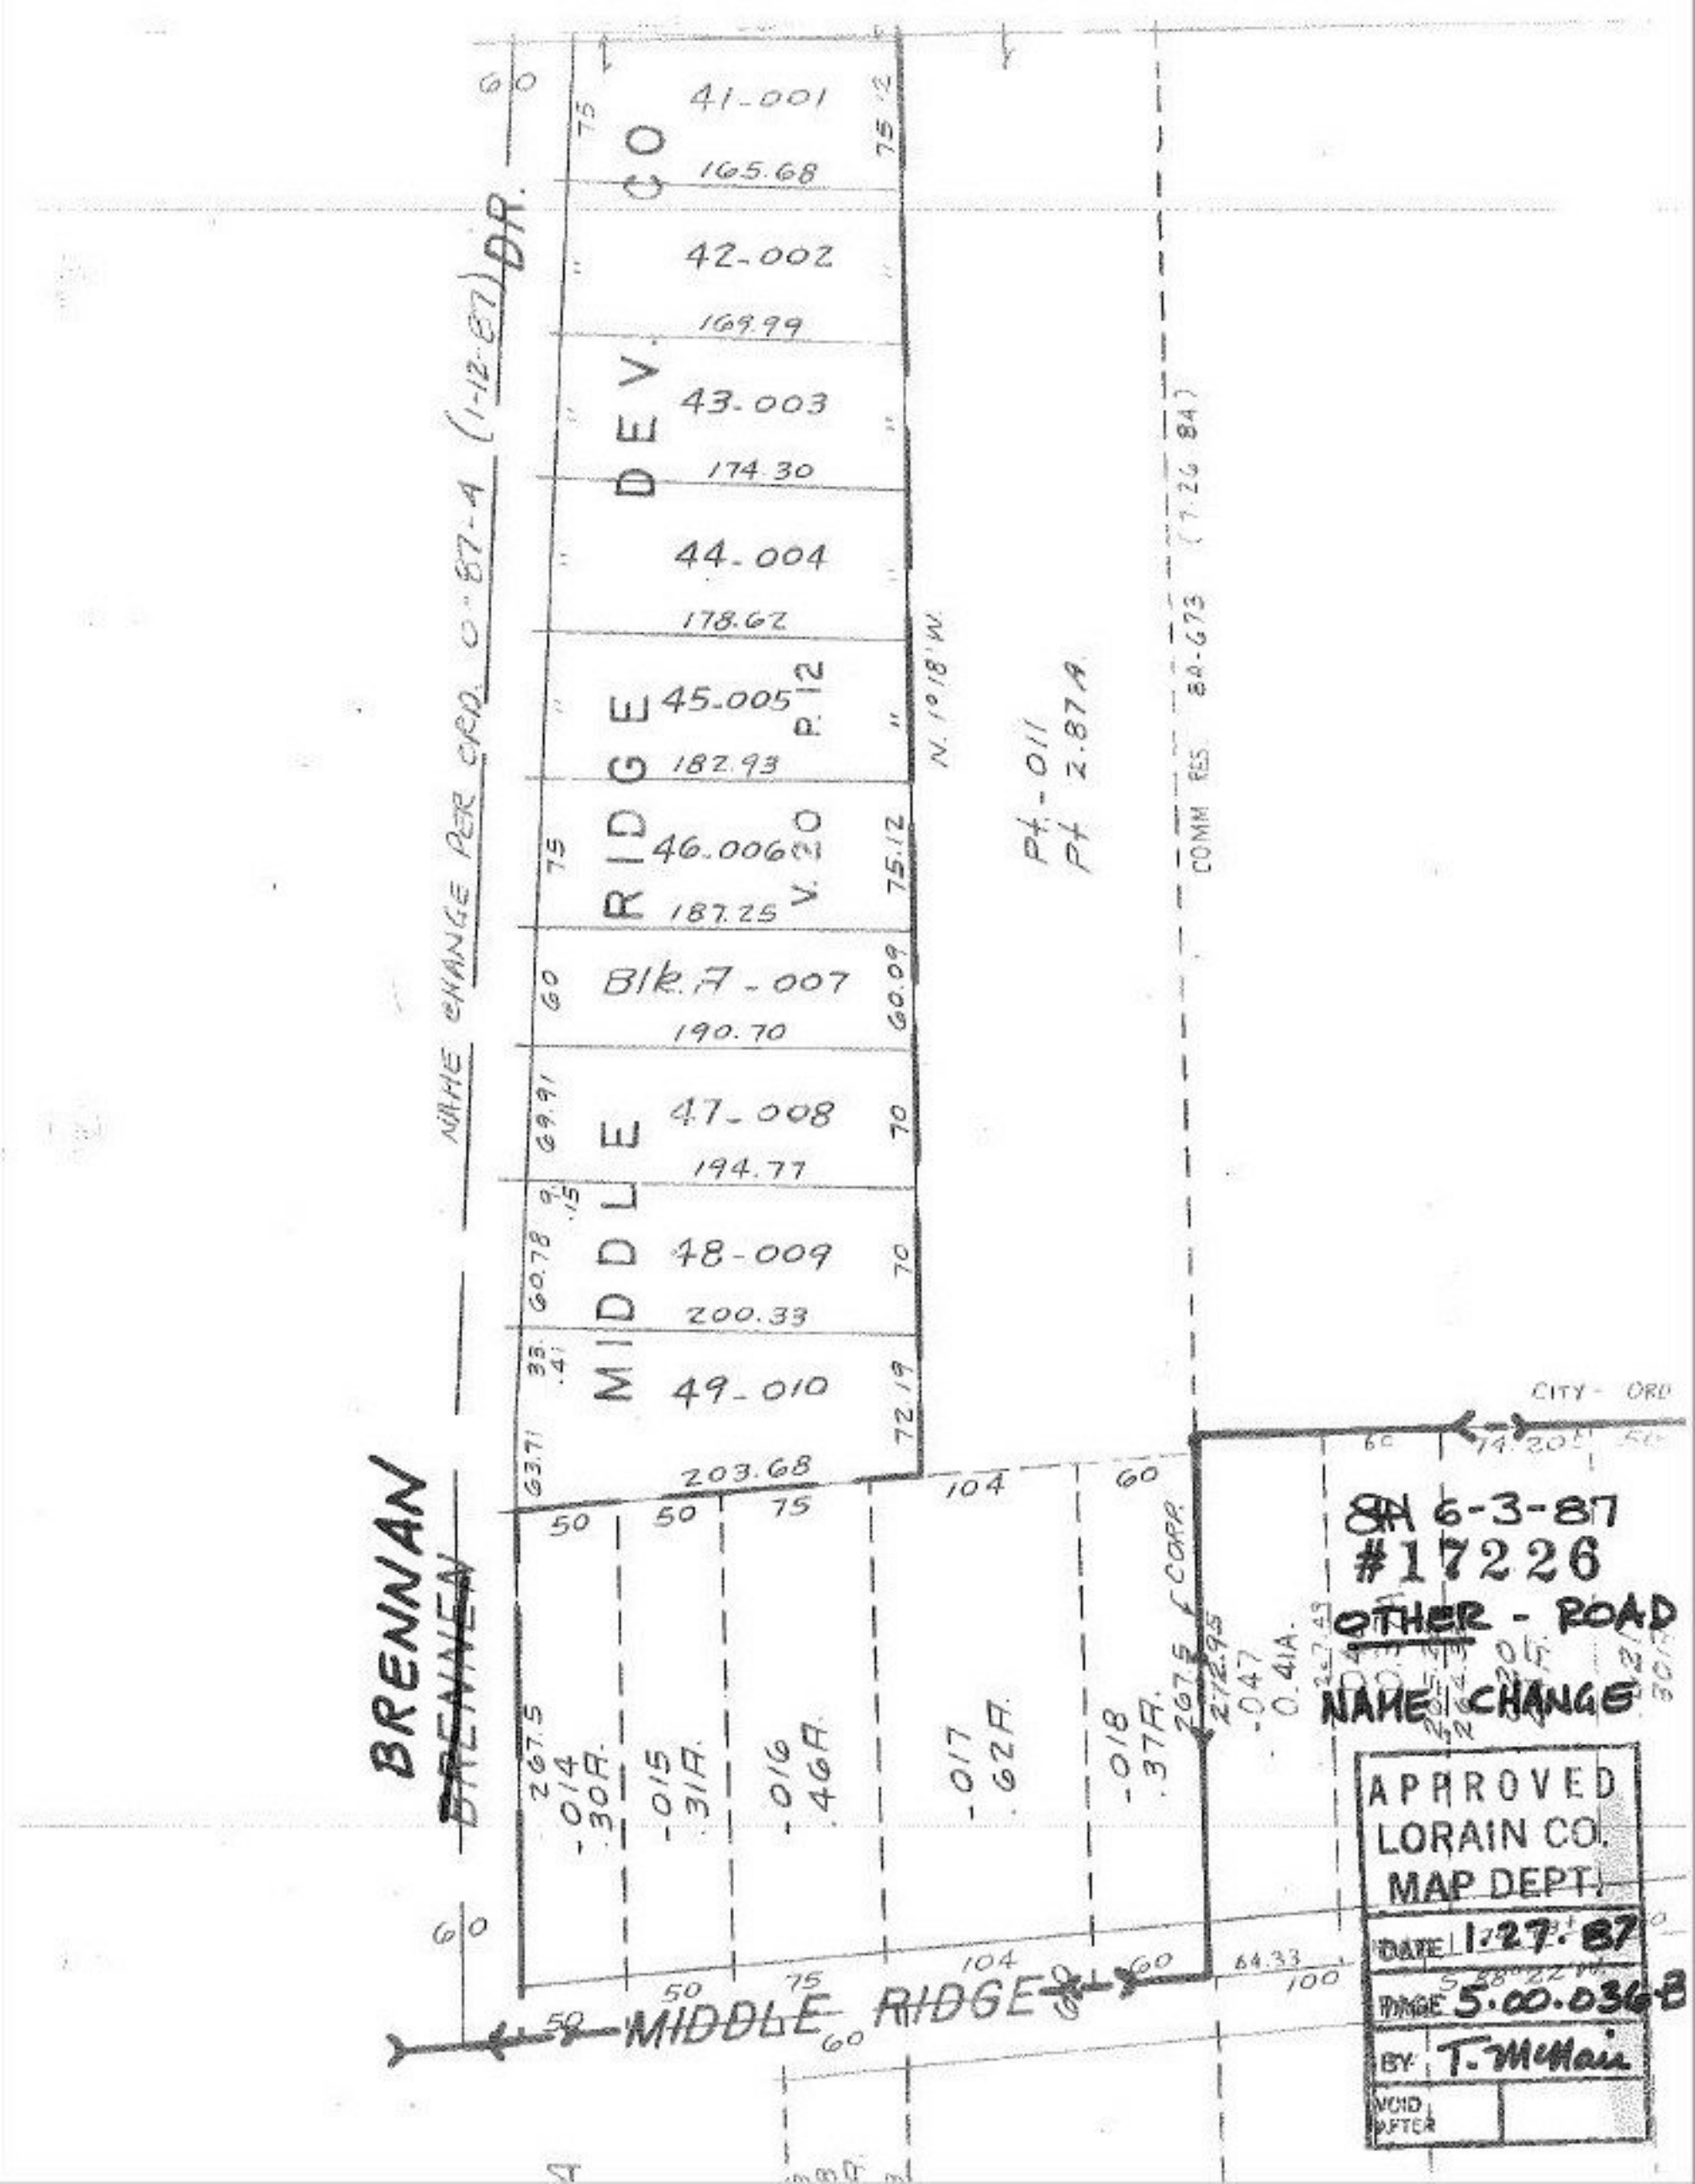
41-001
165.68
42-002
169.99
43-003
174.30
44-004
178.62
45-005
182.93
46-006
187.25
Blk.7-007
190.70
47-008
194.77
48-009
200.33
49-010
203.68
DEV. CO
RIDGE
MIDDLE
BRENNAN
BRENNAN
MIDDLE RIDGE
-014 .30A.
-015 .31A.
-016 .46A.
-017 .62A.
-018 .37A.
-047 0.41A.
267.5
272.95
267.5 C CORP
N. 10°18' W.
P4-011
Pt 2.87A
COMM RES 88-673 (7.26 84)
CITY - ORD
SR 6-3-87
#17226
OTHER - ROAD
NAME CHANGE
APPROVED
LORAIN CO.
MAP DEPT.
DATE 1-27-87
RMGE 5.00.036-B
BY T. McMain
VOID AFTER