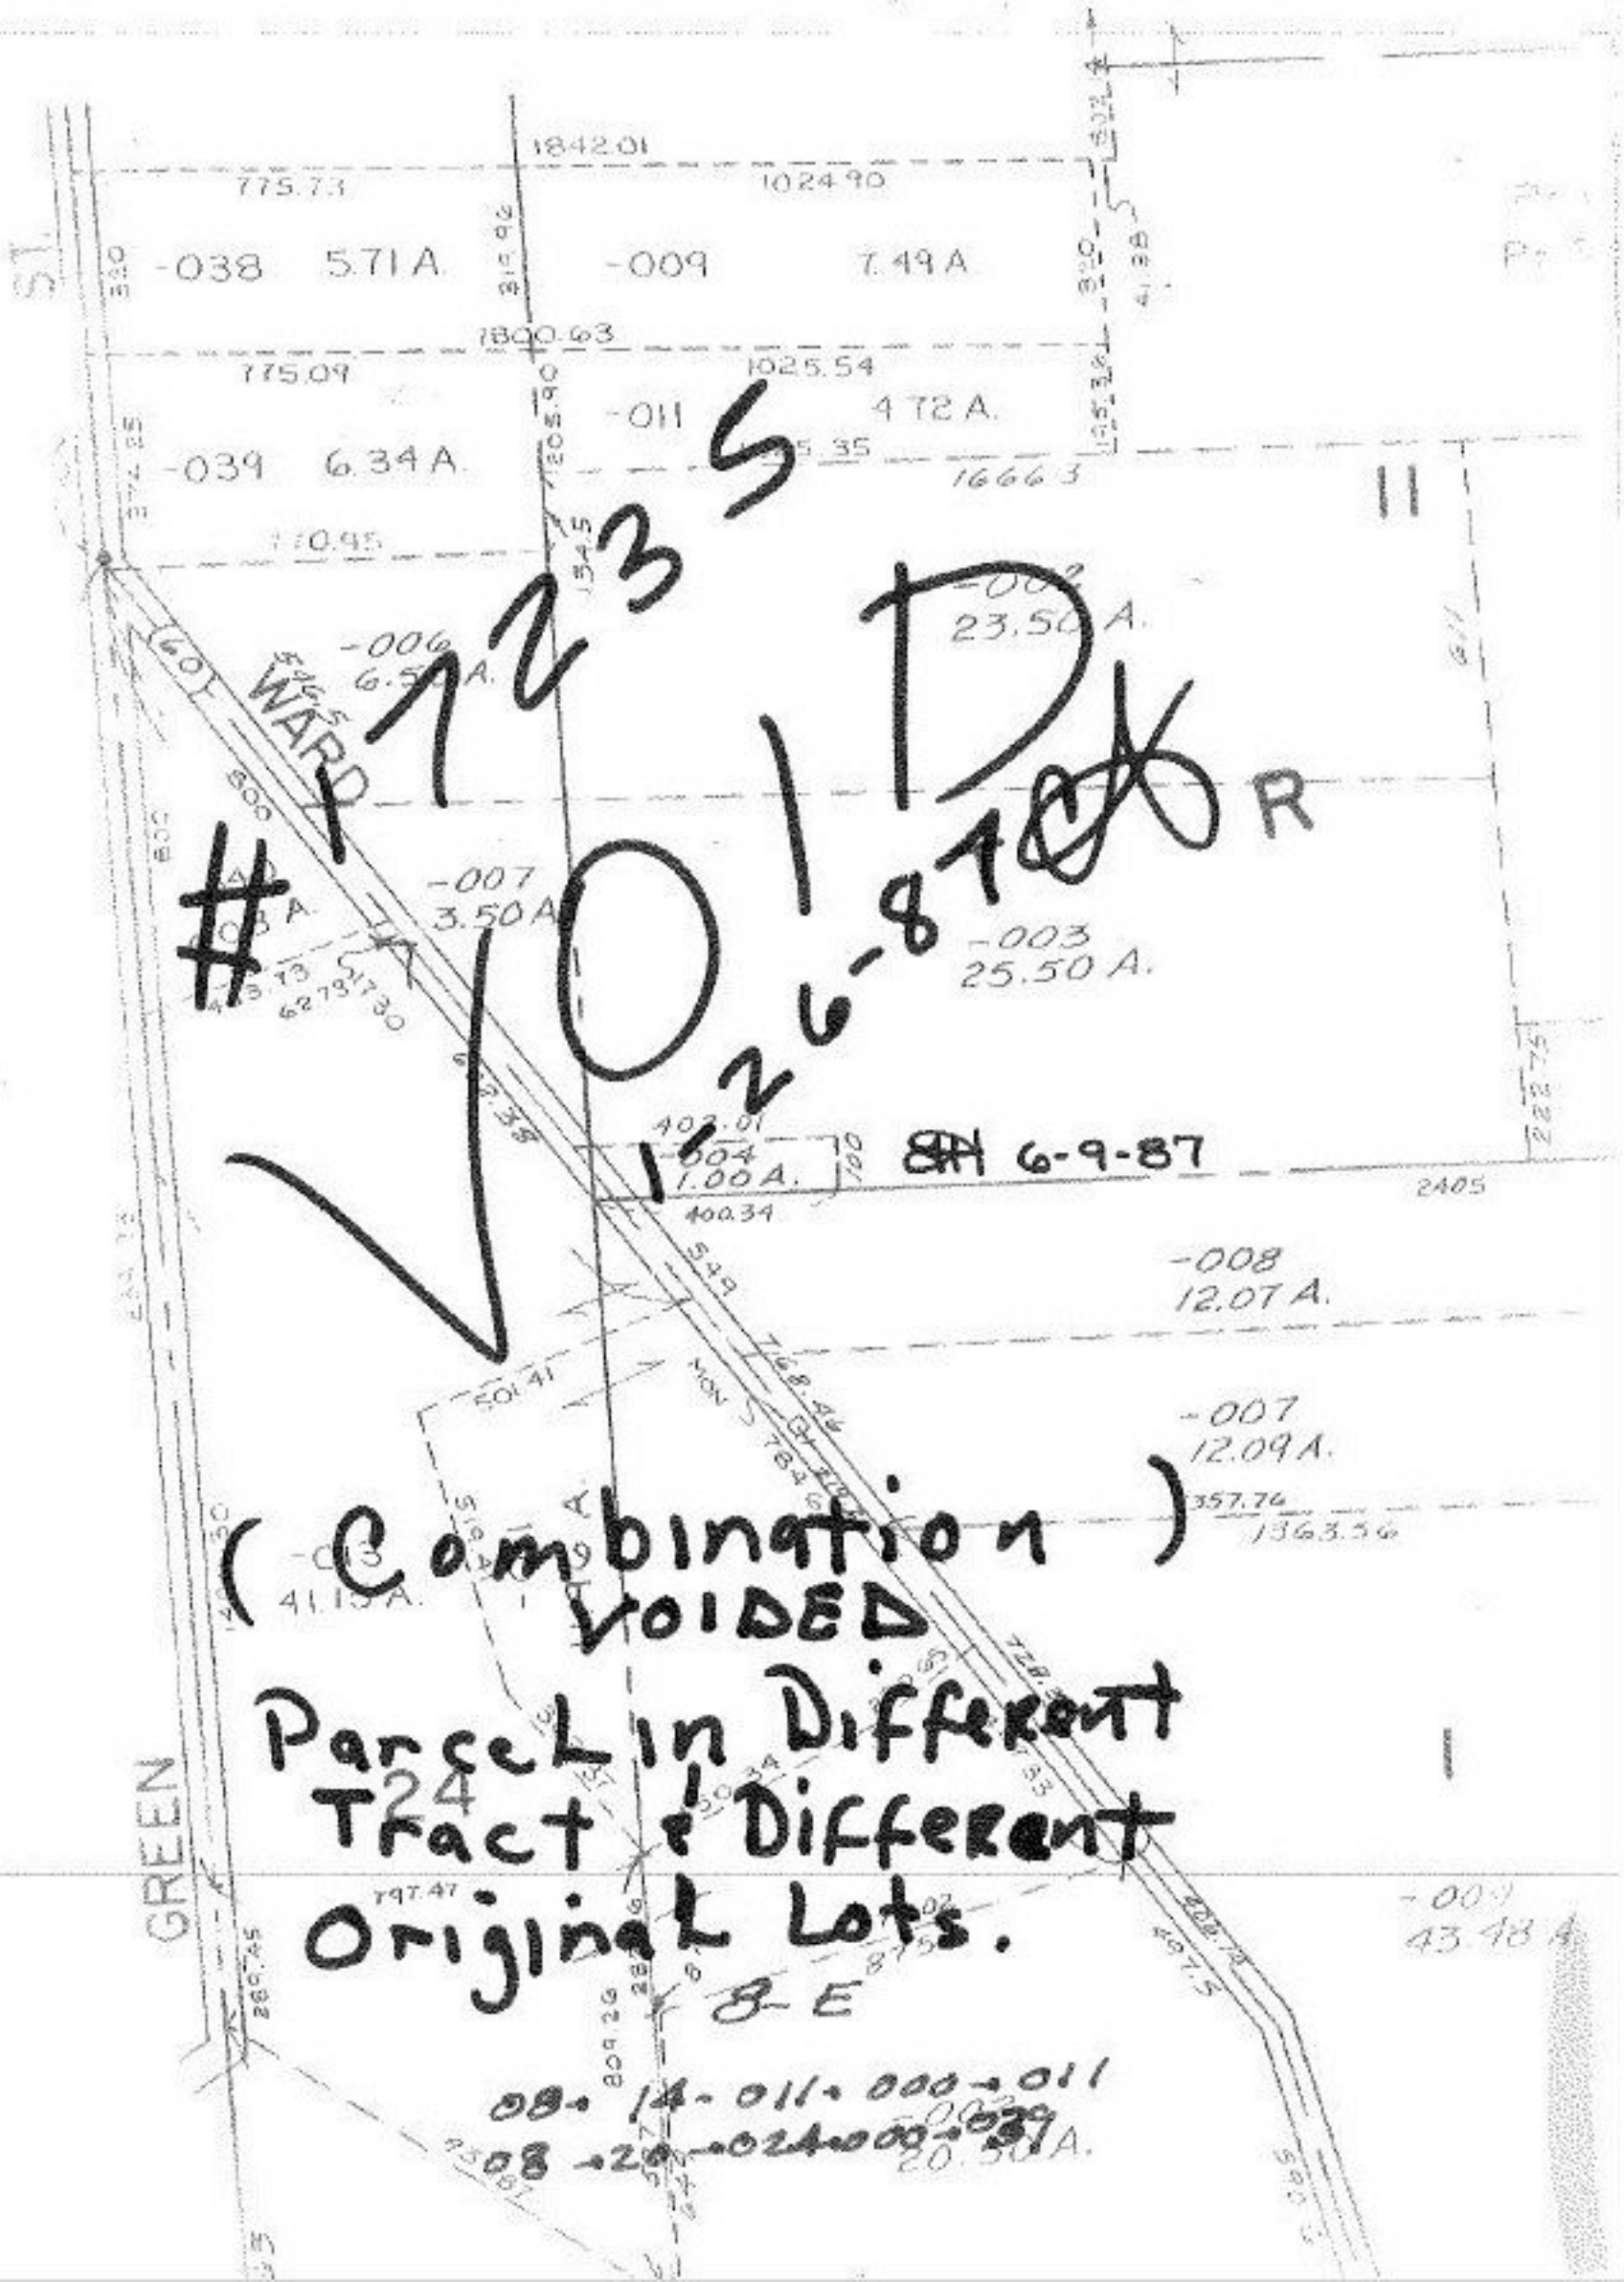

1723 5

1 1 D

26-87 R

SH 6-9-87

(Combination)
VOIDED
Parcel in Different
Tract & Different
Original Lots.

8-E

08-14-011-000-011
08-20-024-000-039