13-11-016-102-013,014
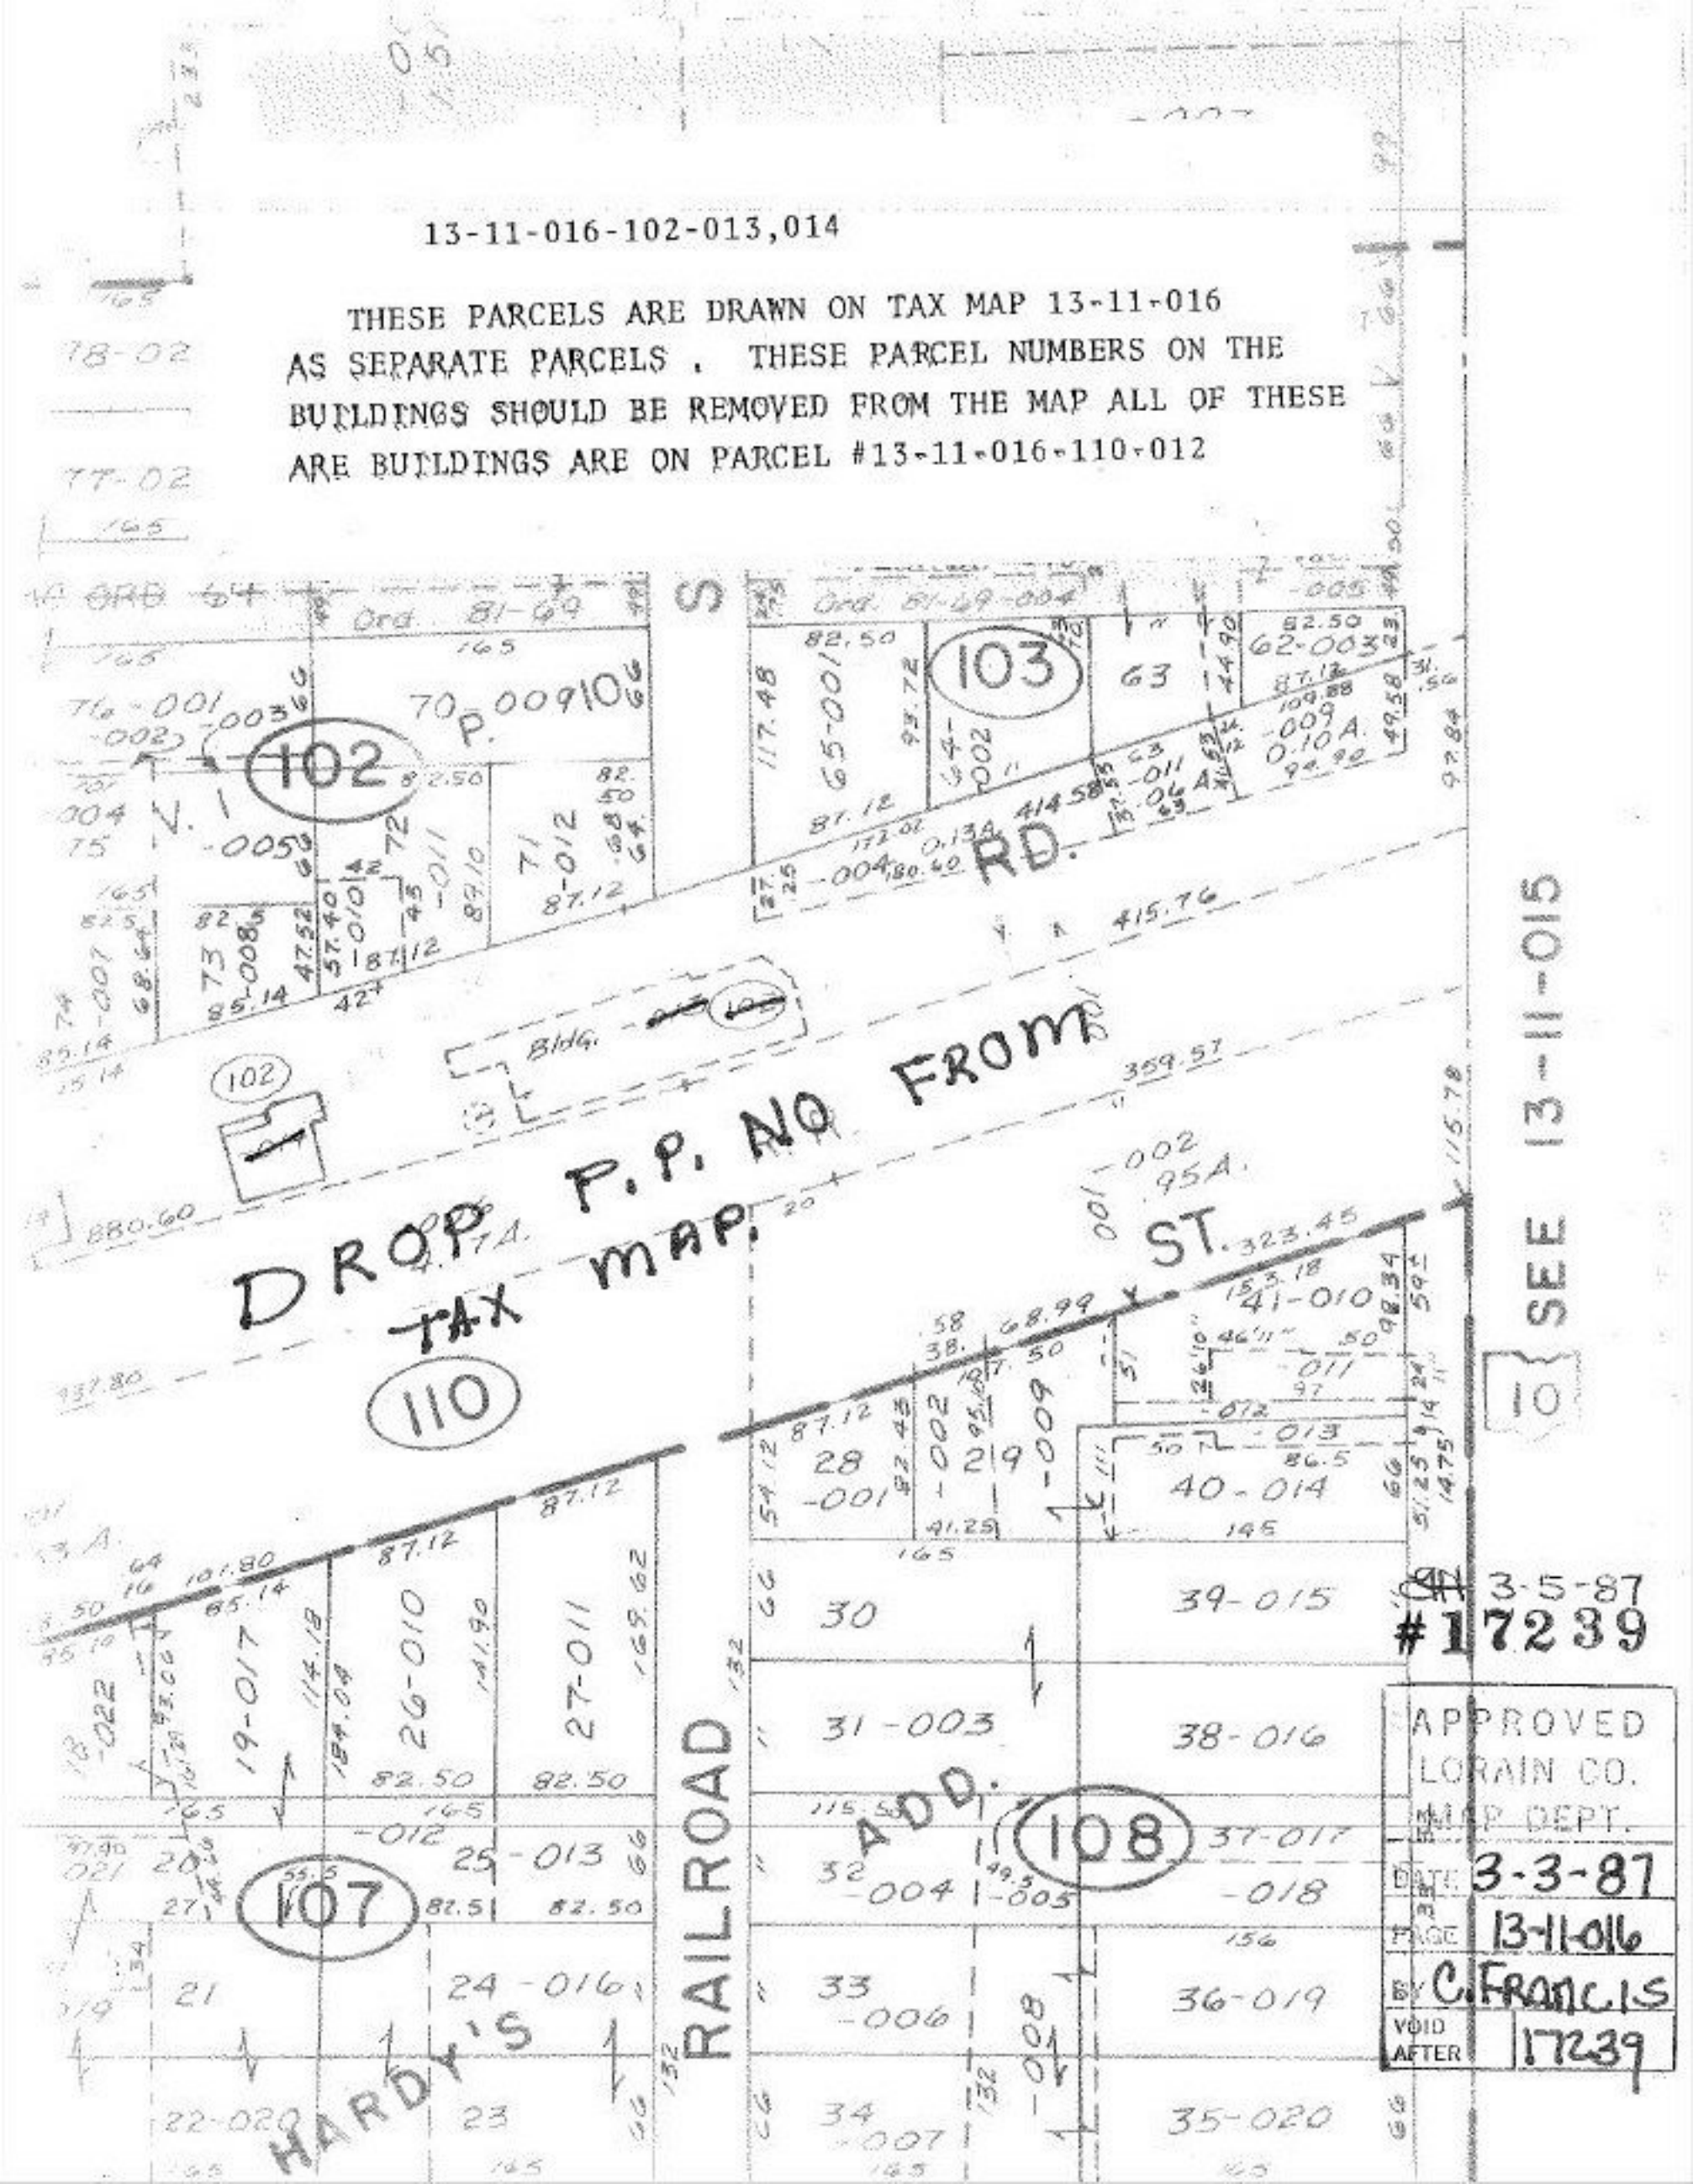
THESE PARCELS ARE DRAWN ON TAX MAP 13-11-016 AS SEPARATE PARCELS . THESE PARCEL NUMBERS ON THE BUILDINGS SHOULD BE REMOVED FROM THE MAP ALL OF THESE ARE BUILDINGS ARE ON PARCEL #13-11-016-110-012