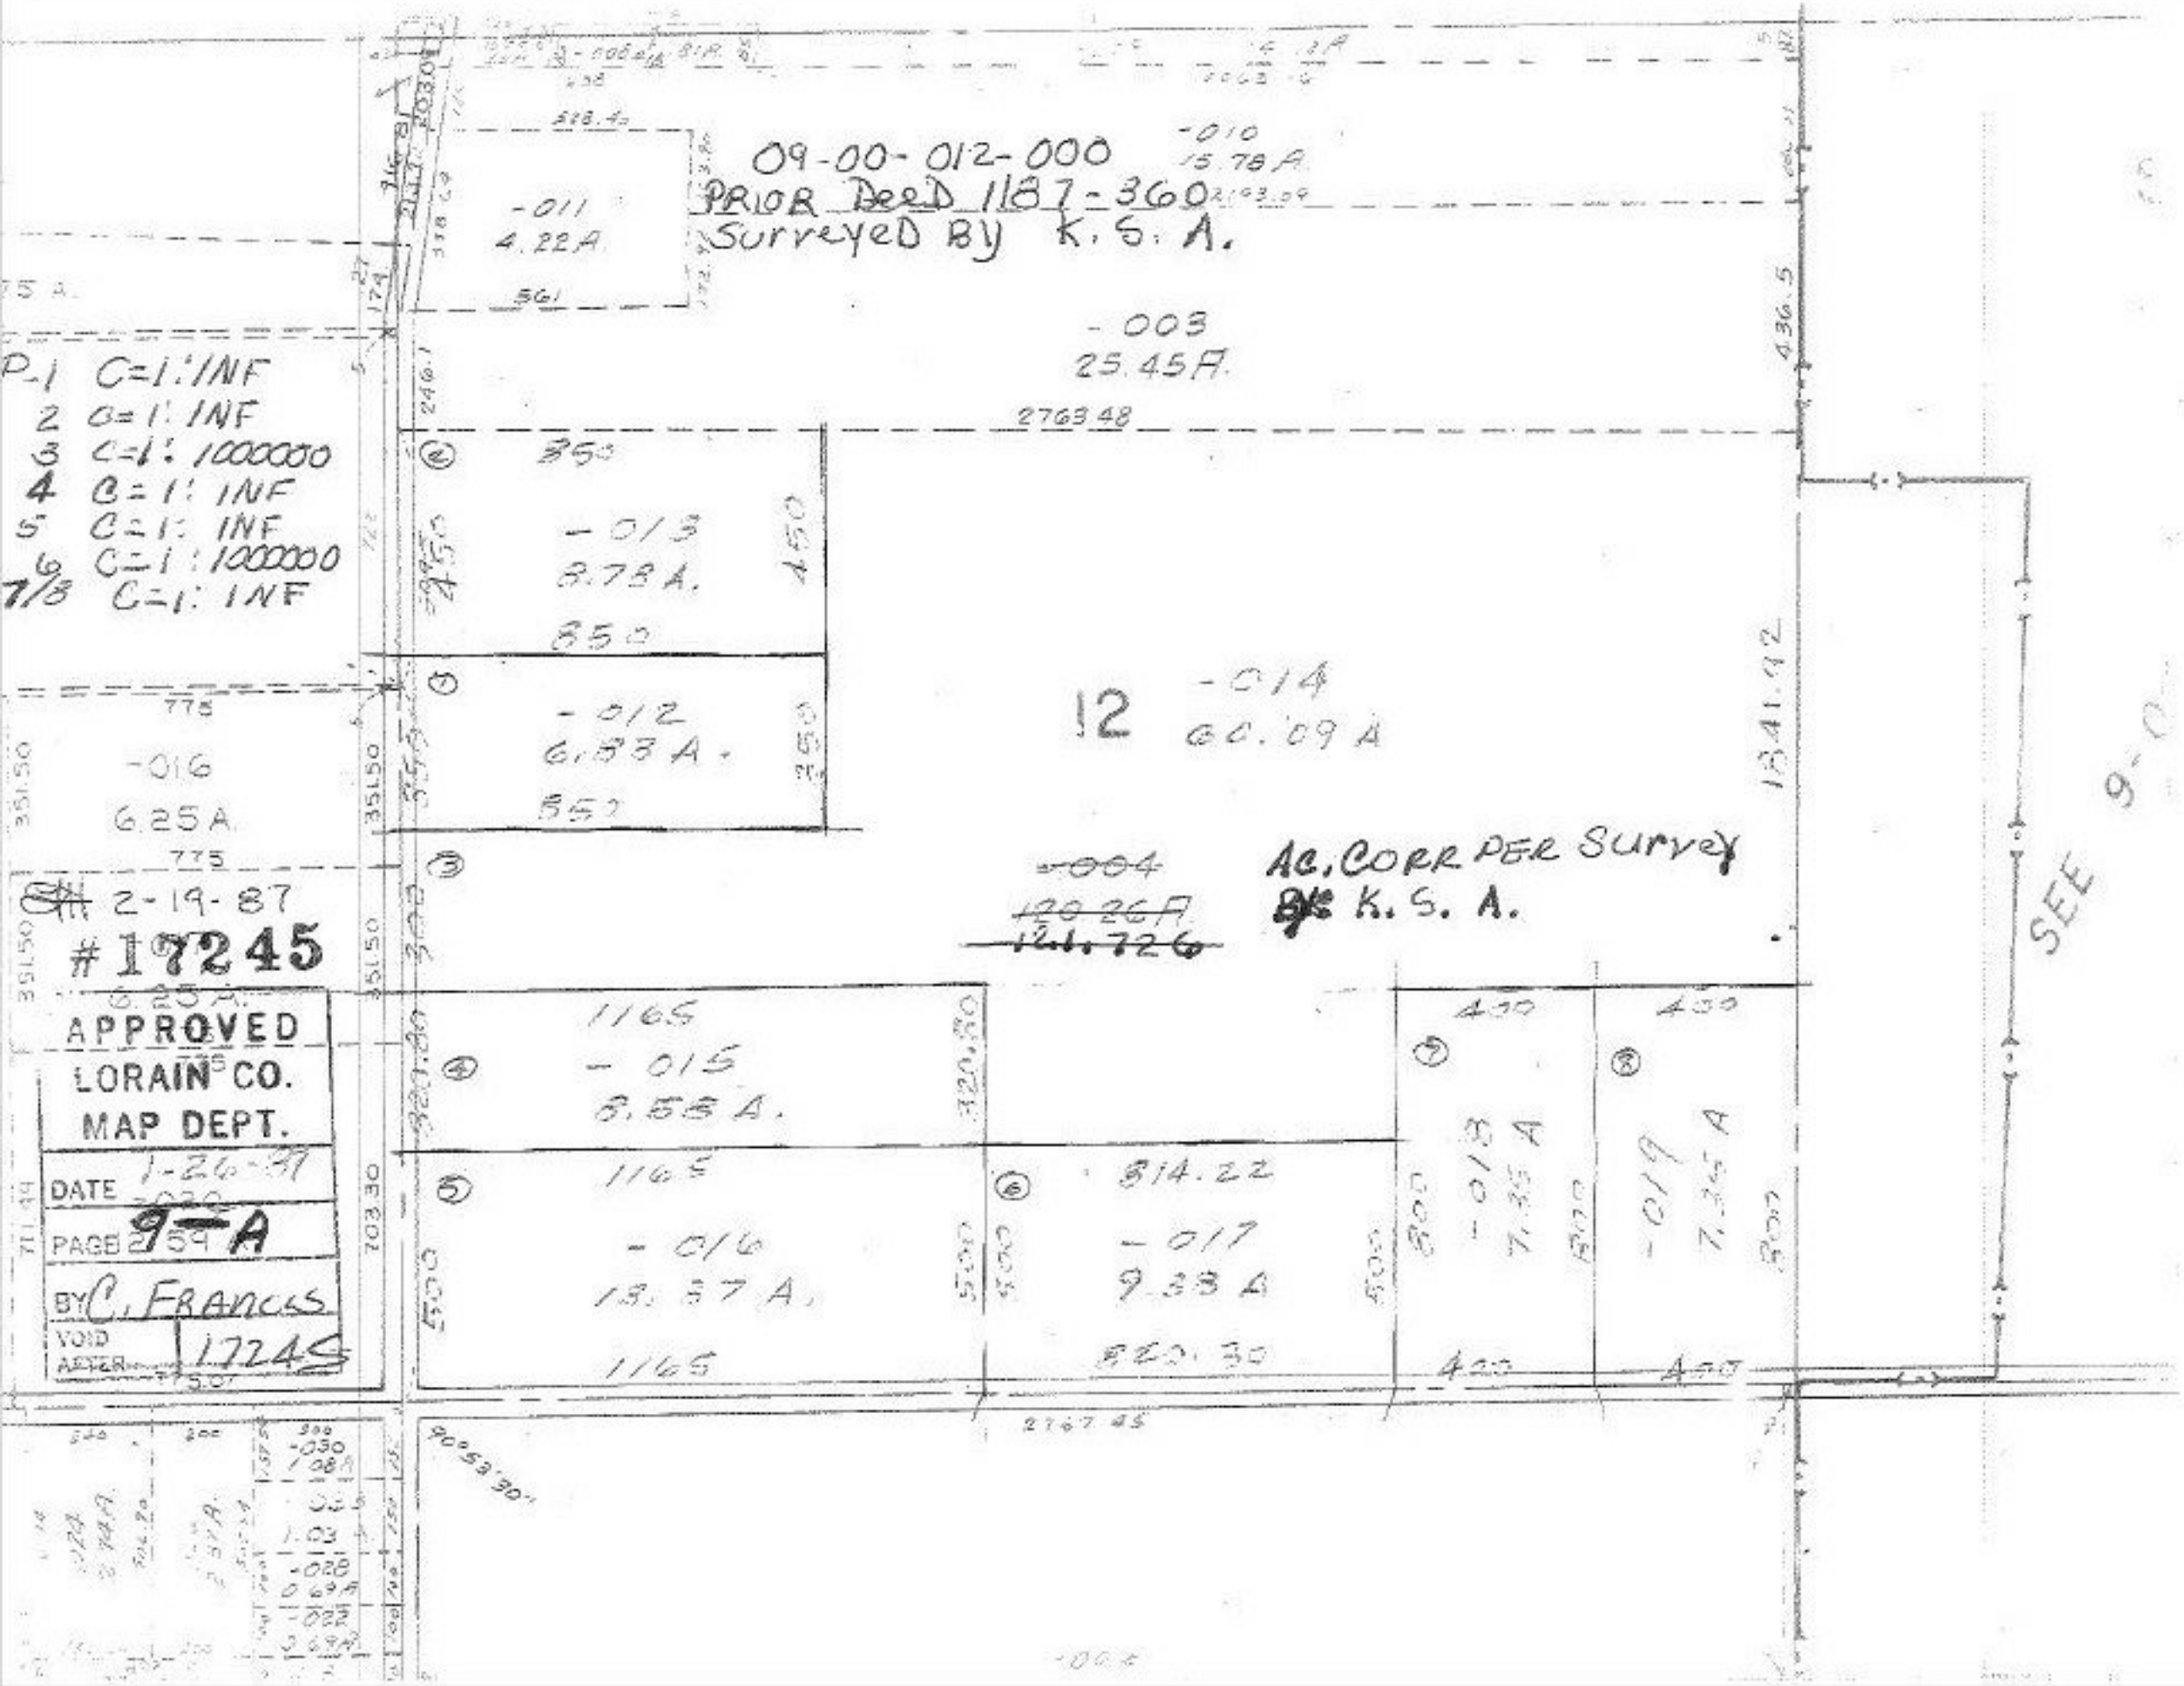

09-00-012-000
PRIOR DEED 1187-360
SURVEYED BY K.S.A.
-010
15.78 A
-011
4.22 A
561
-003
25.45 A
2763.48
P-1 C=1:INF
2 C=1:INF
3 C=1:1000000
4 C=1:INF
5 C=1:INF
6 C=1:1000000
7/8 C=1:INF
-013
8.78 A.
850
-012
6.83 A.
850
12
-014
60.09 A
-016
6.25 A
775
-004
120.26 A
121.726
AC. CORR PER SURVEY
BY K.S.A.
2-19-87
#17245
APPROVED
LORAIN CO.
MAP DEPT.
DATE 1-26-87
PAGE 9-A
BY C. FRANCIS
VOID AFTER 17245
1165
-015
8.58 A.
1165
-016
13.37 A.
1165
814.22
-017
9.38 A
820.30
-018
7.35 A
-019
7.35 A
400
800
SEE 9-0
1841.92
436.5
2767.45
90°53'30"