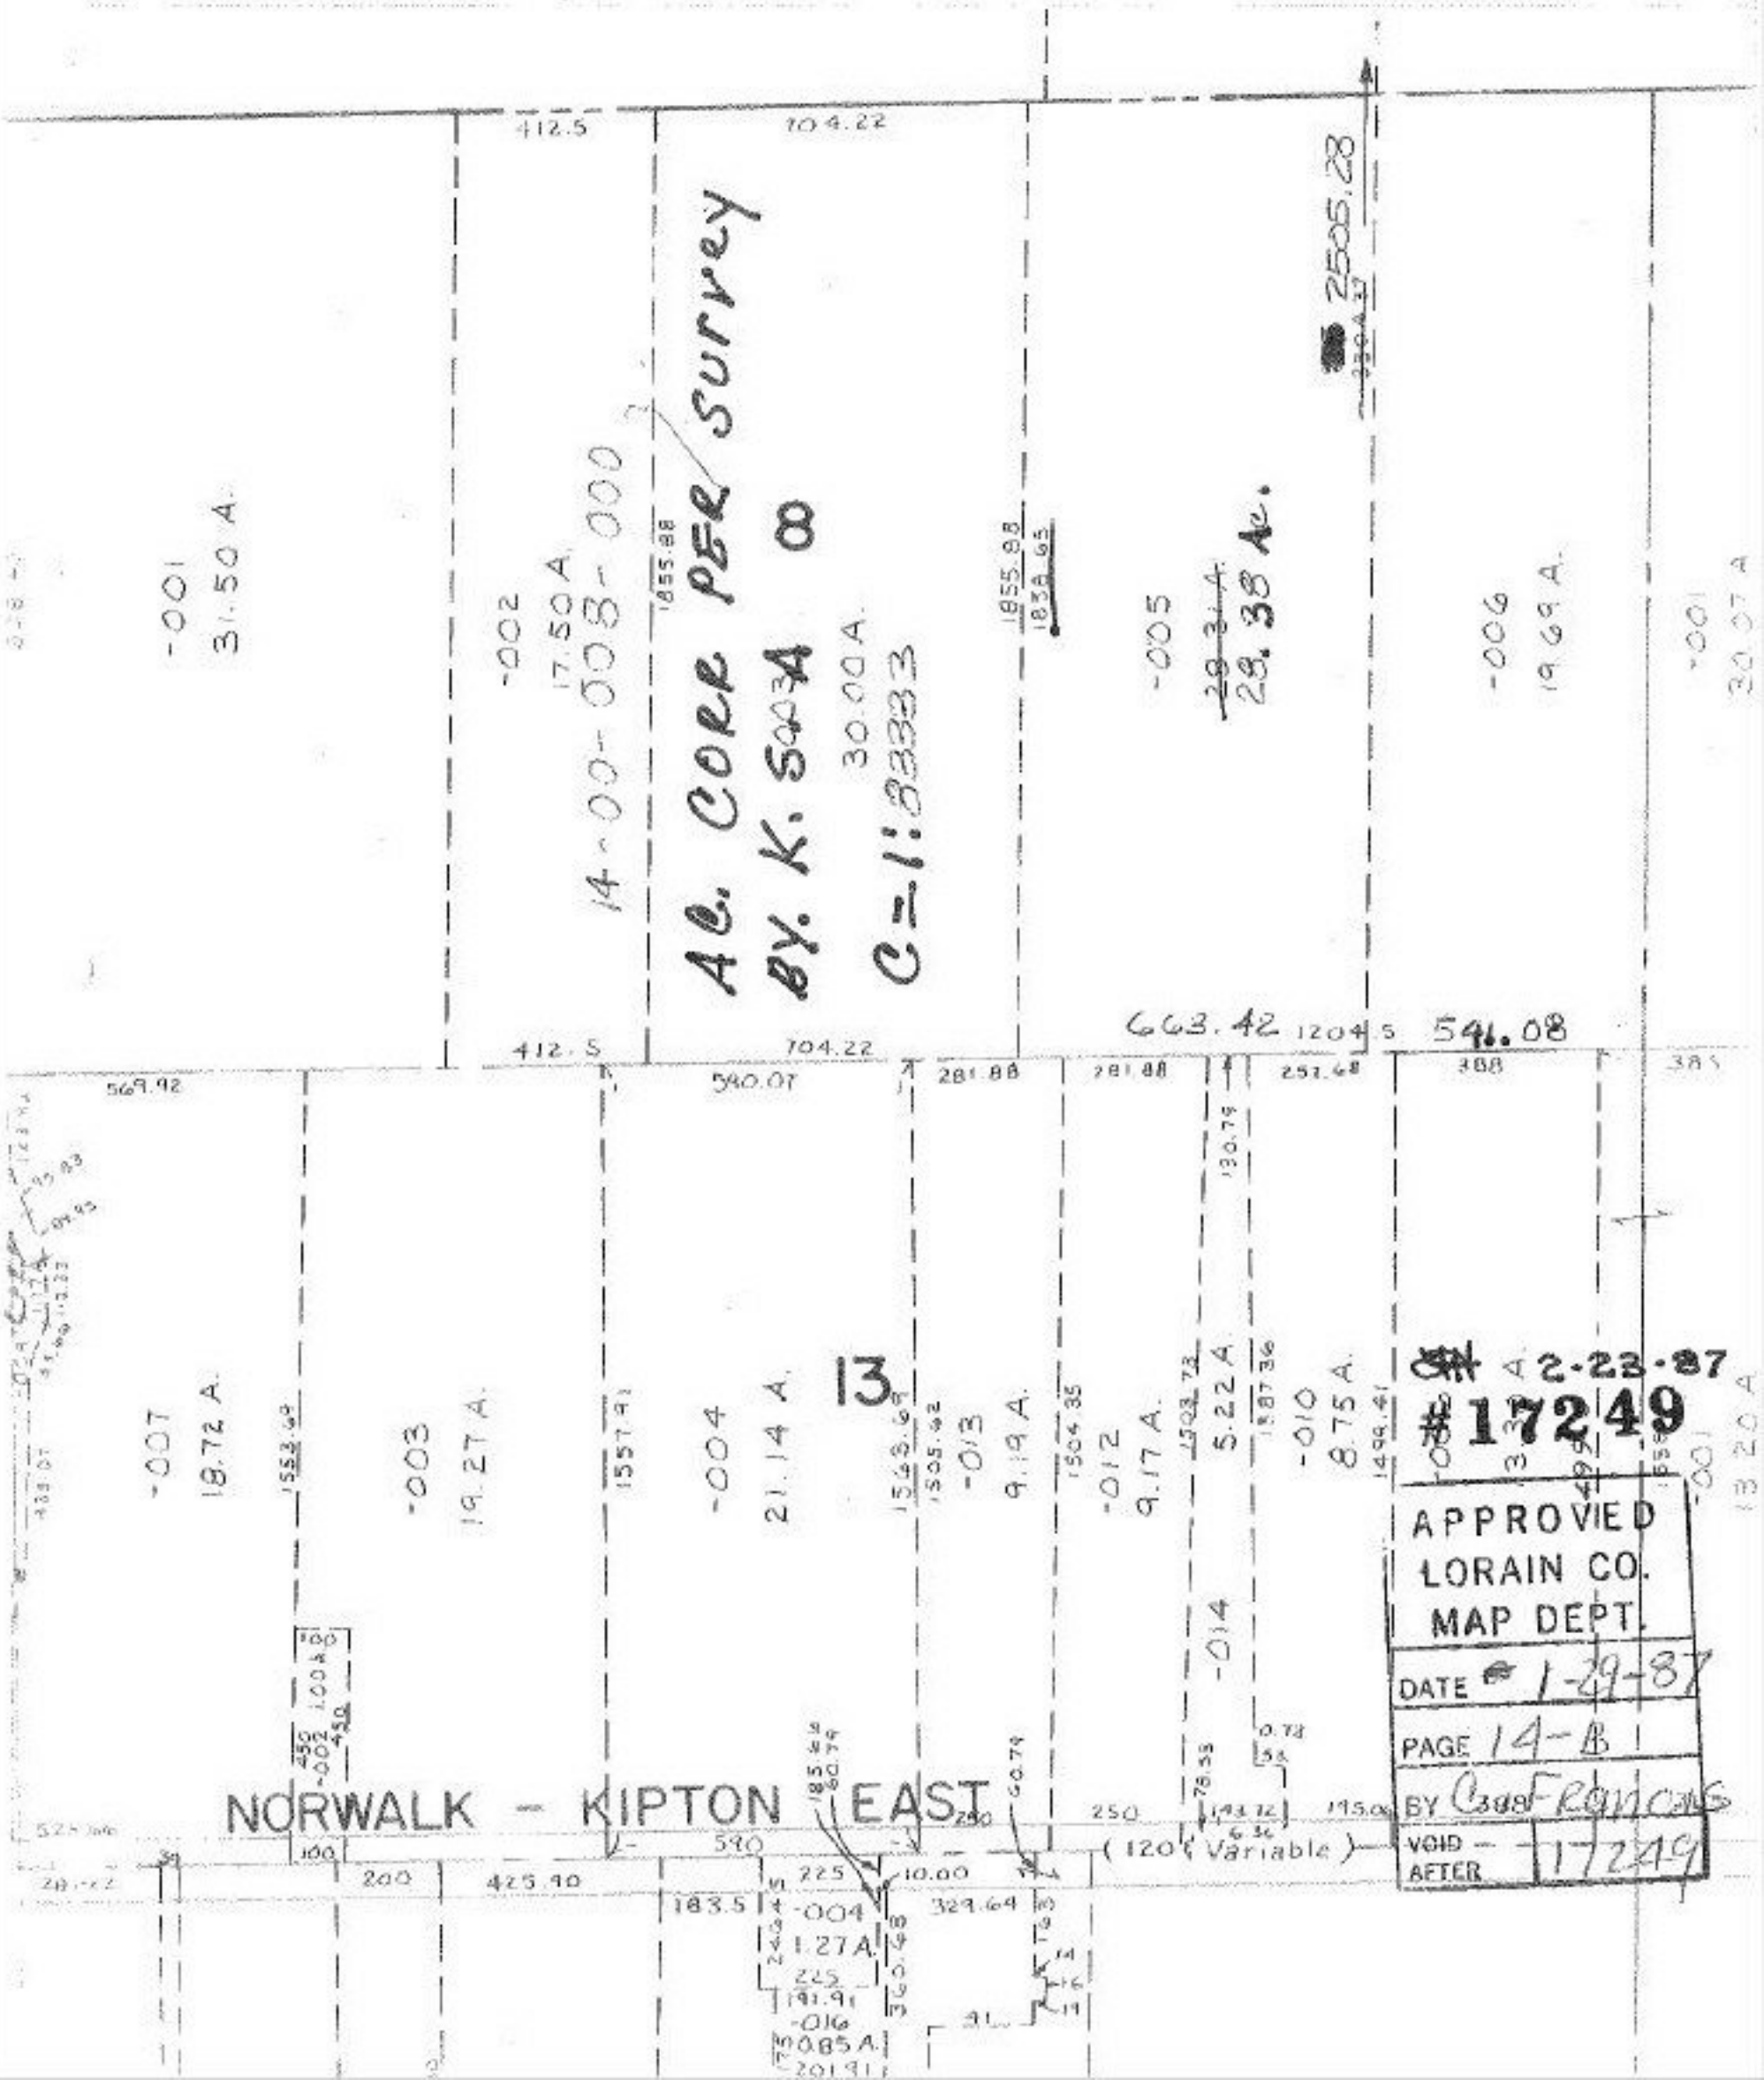

2-23-87
#17249

APPROVED
LORAIN CO.
MAP DEPT.
DATE 1-29-87
PAGE 14-B
BY C. Francis
VOID AFTER 17249