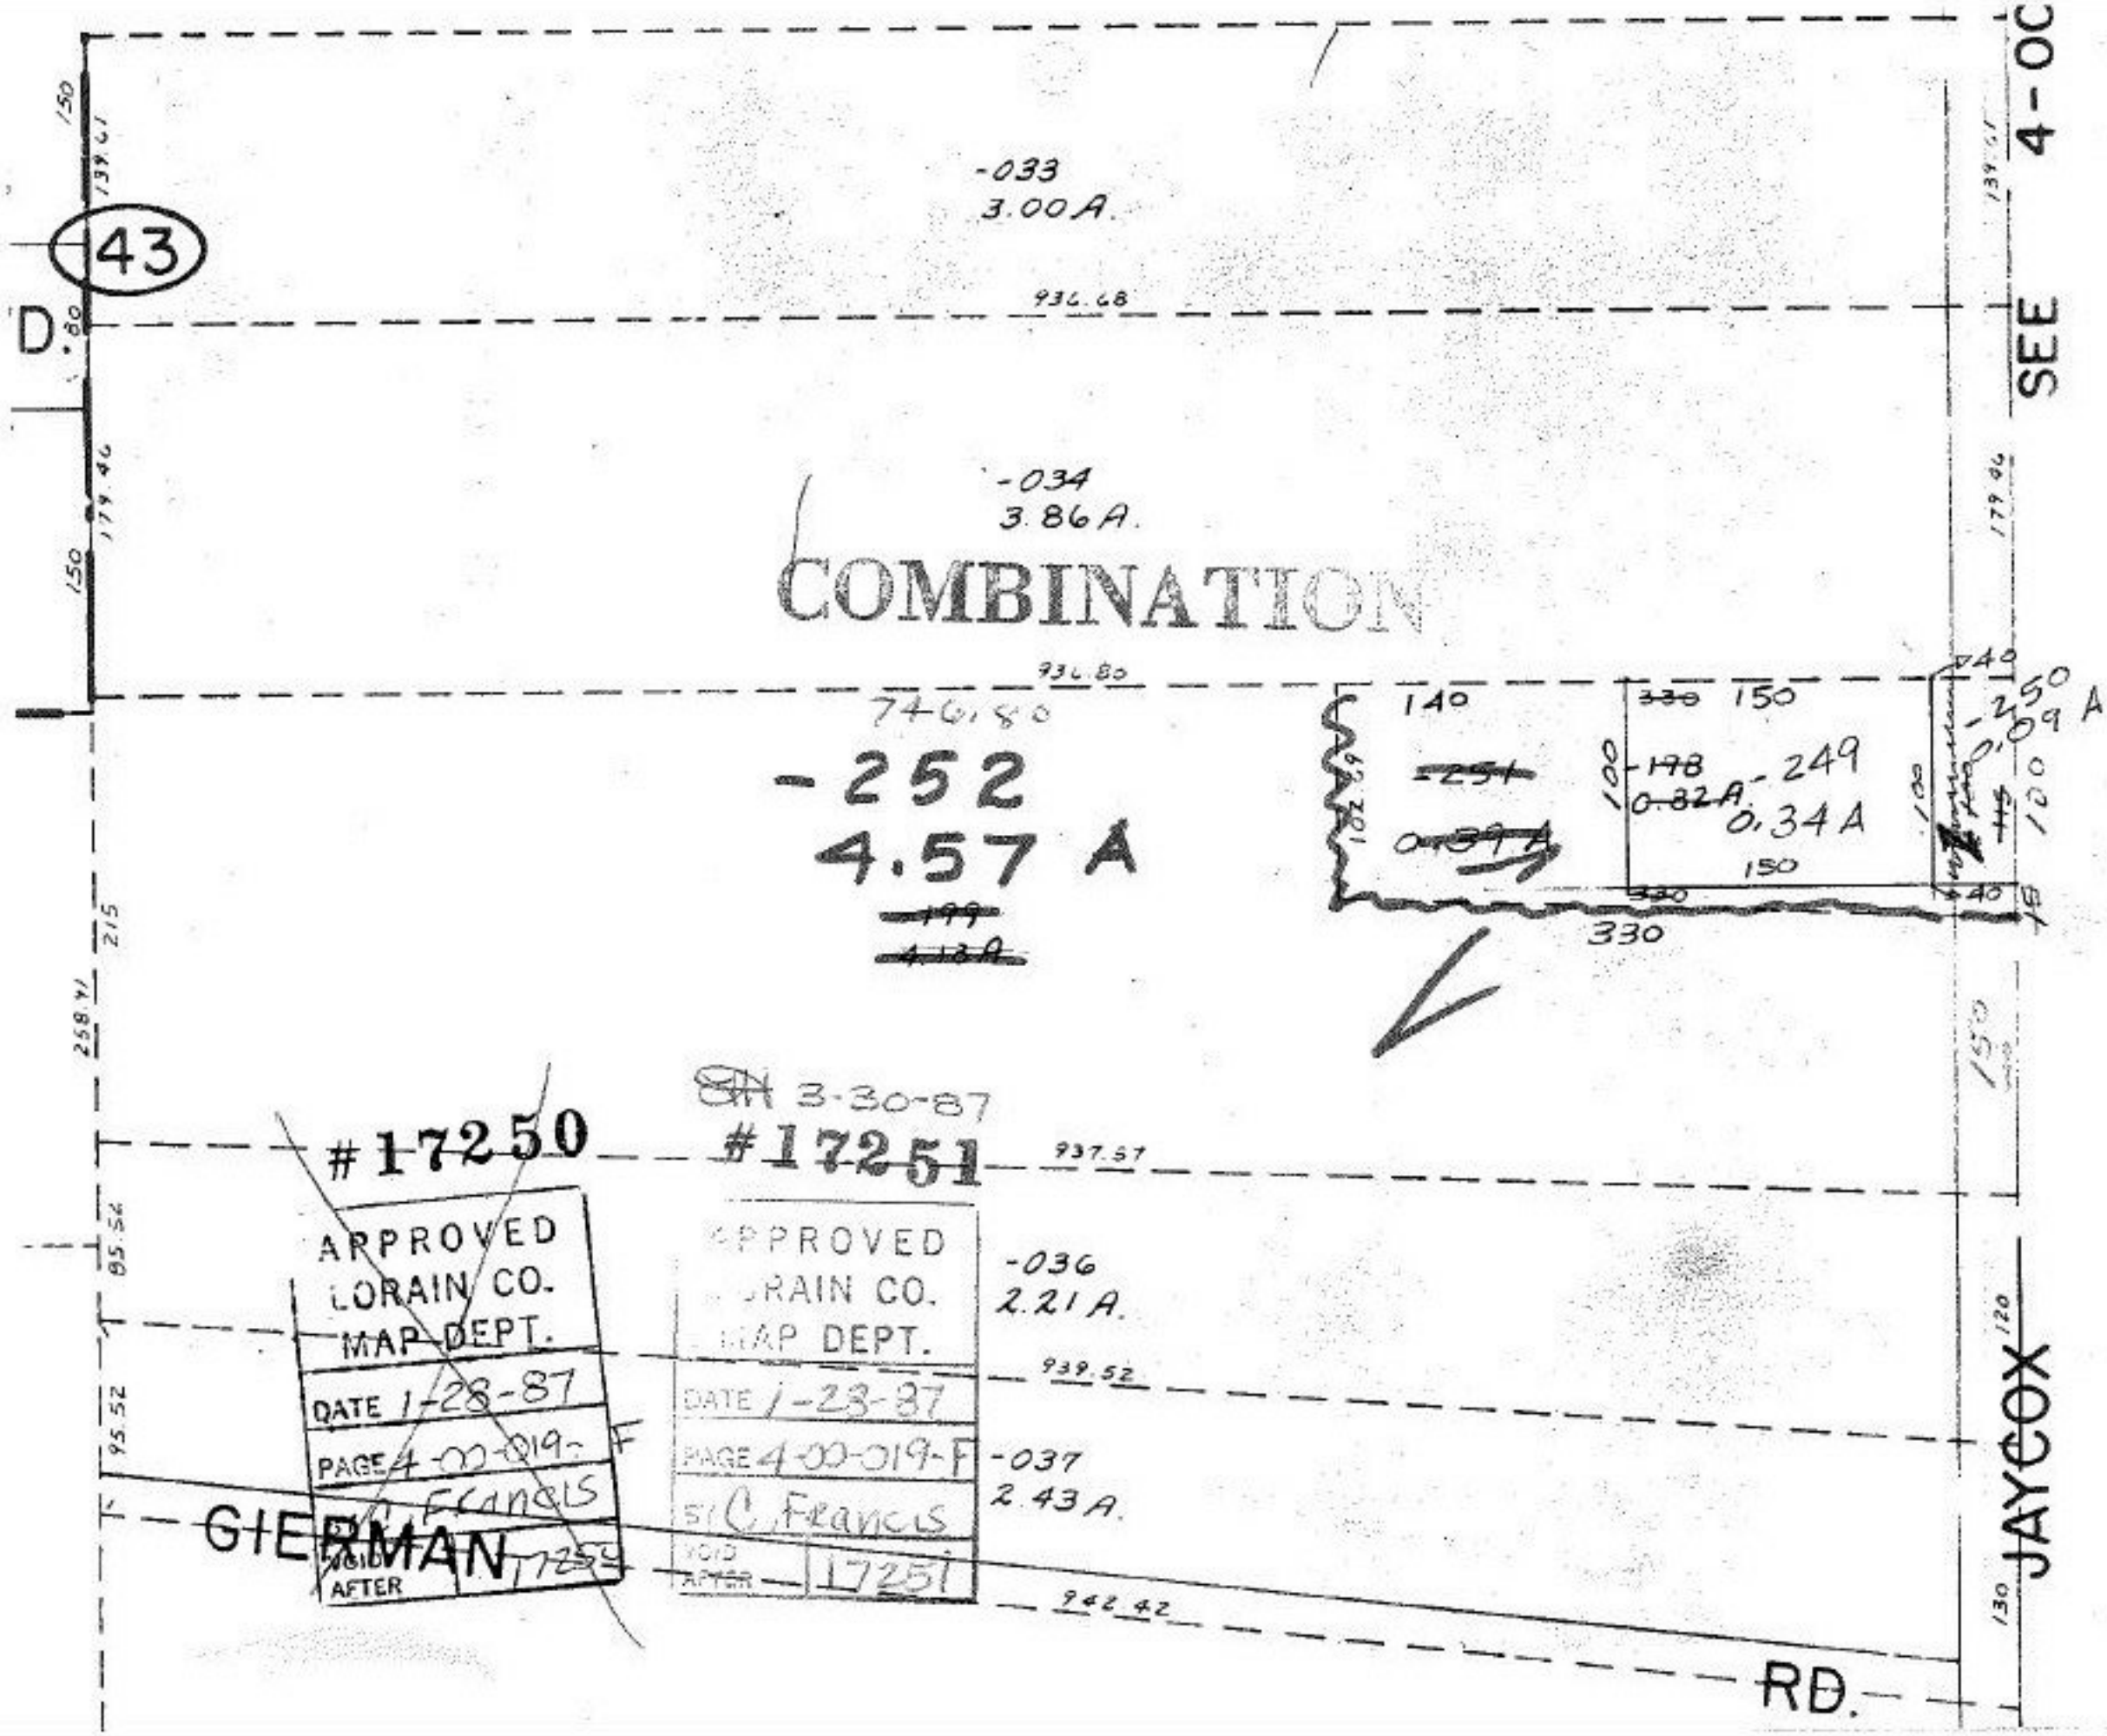

43
D.
SEE 4-OC
-033
3.00 A.
936.68
-034
3.86 A.
COMBINATION
936.80
746.80
-252
4.57 A
~~-199~~
~~4.13 A~~
140
~~-251~~
~~0.39 A~~
~~330~~ 150
100
~~-198~~
~~0.82 A~~
-249
0.34 A
150
~~330~~
330
-250
0.09 A
100
40
215
258.41
150
#17250
APPROVED
LORAIN CO.
MAP DEPT.
DATE 1-28-87
PAGE 4-00-019-F
C. Francis
VOID AFTER 17250
GIERMAN
3-30-87
#17251
APPROVED
LORAIN CO.
MAP DEPT.
DATE 1-28-87
PAGE 4-00-019-F
BY C. Francis
VOID AFTER 17251
937.57
-036
2.21 A.
939.52
-037
2.43 A.
942.42
RD.
JAYCOX