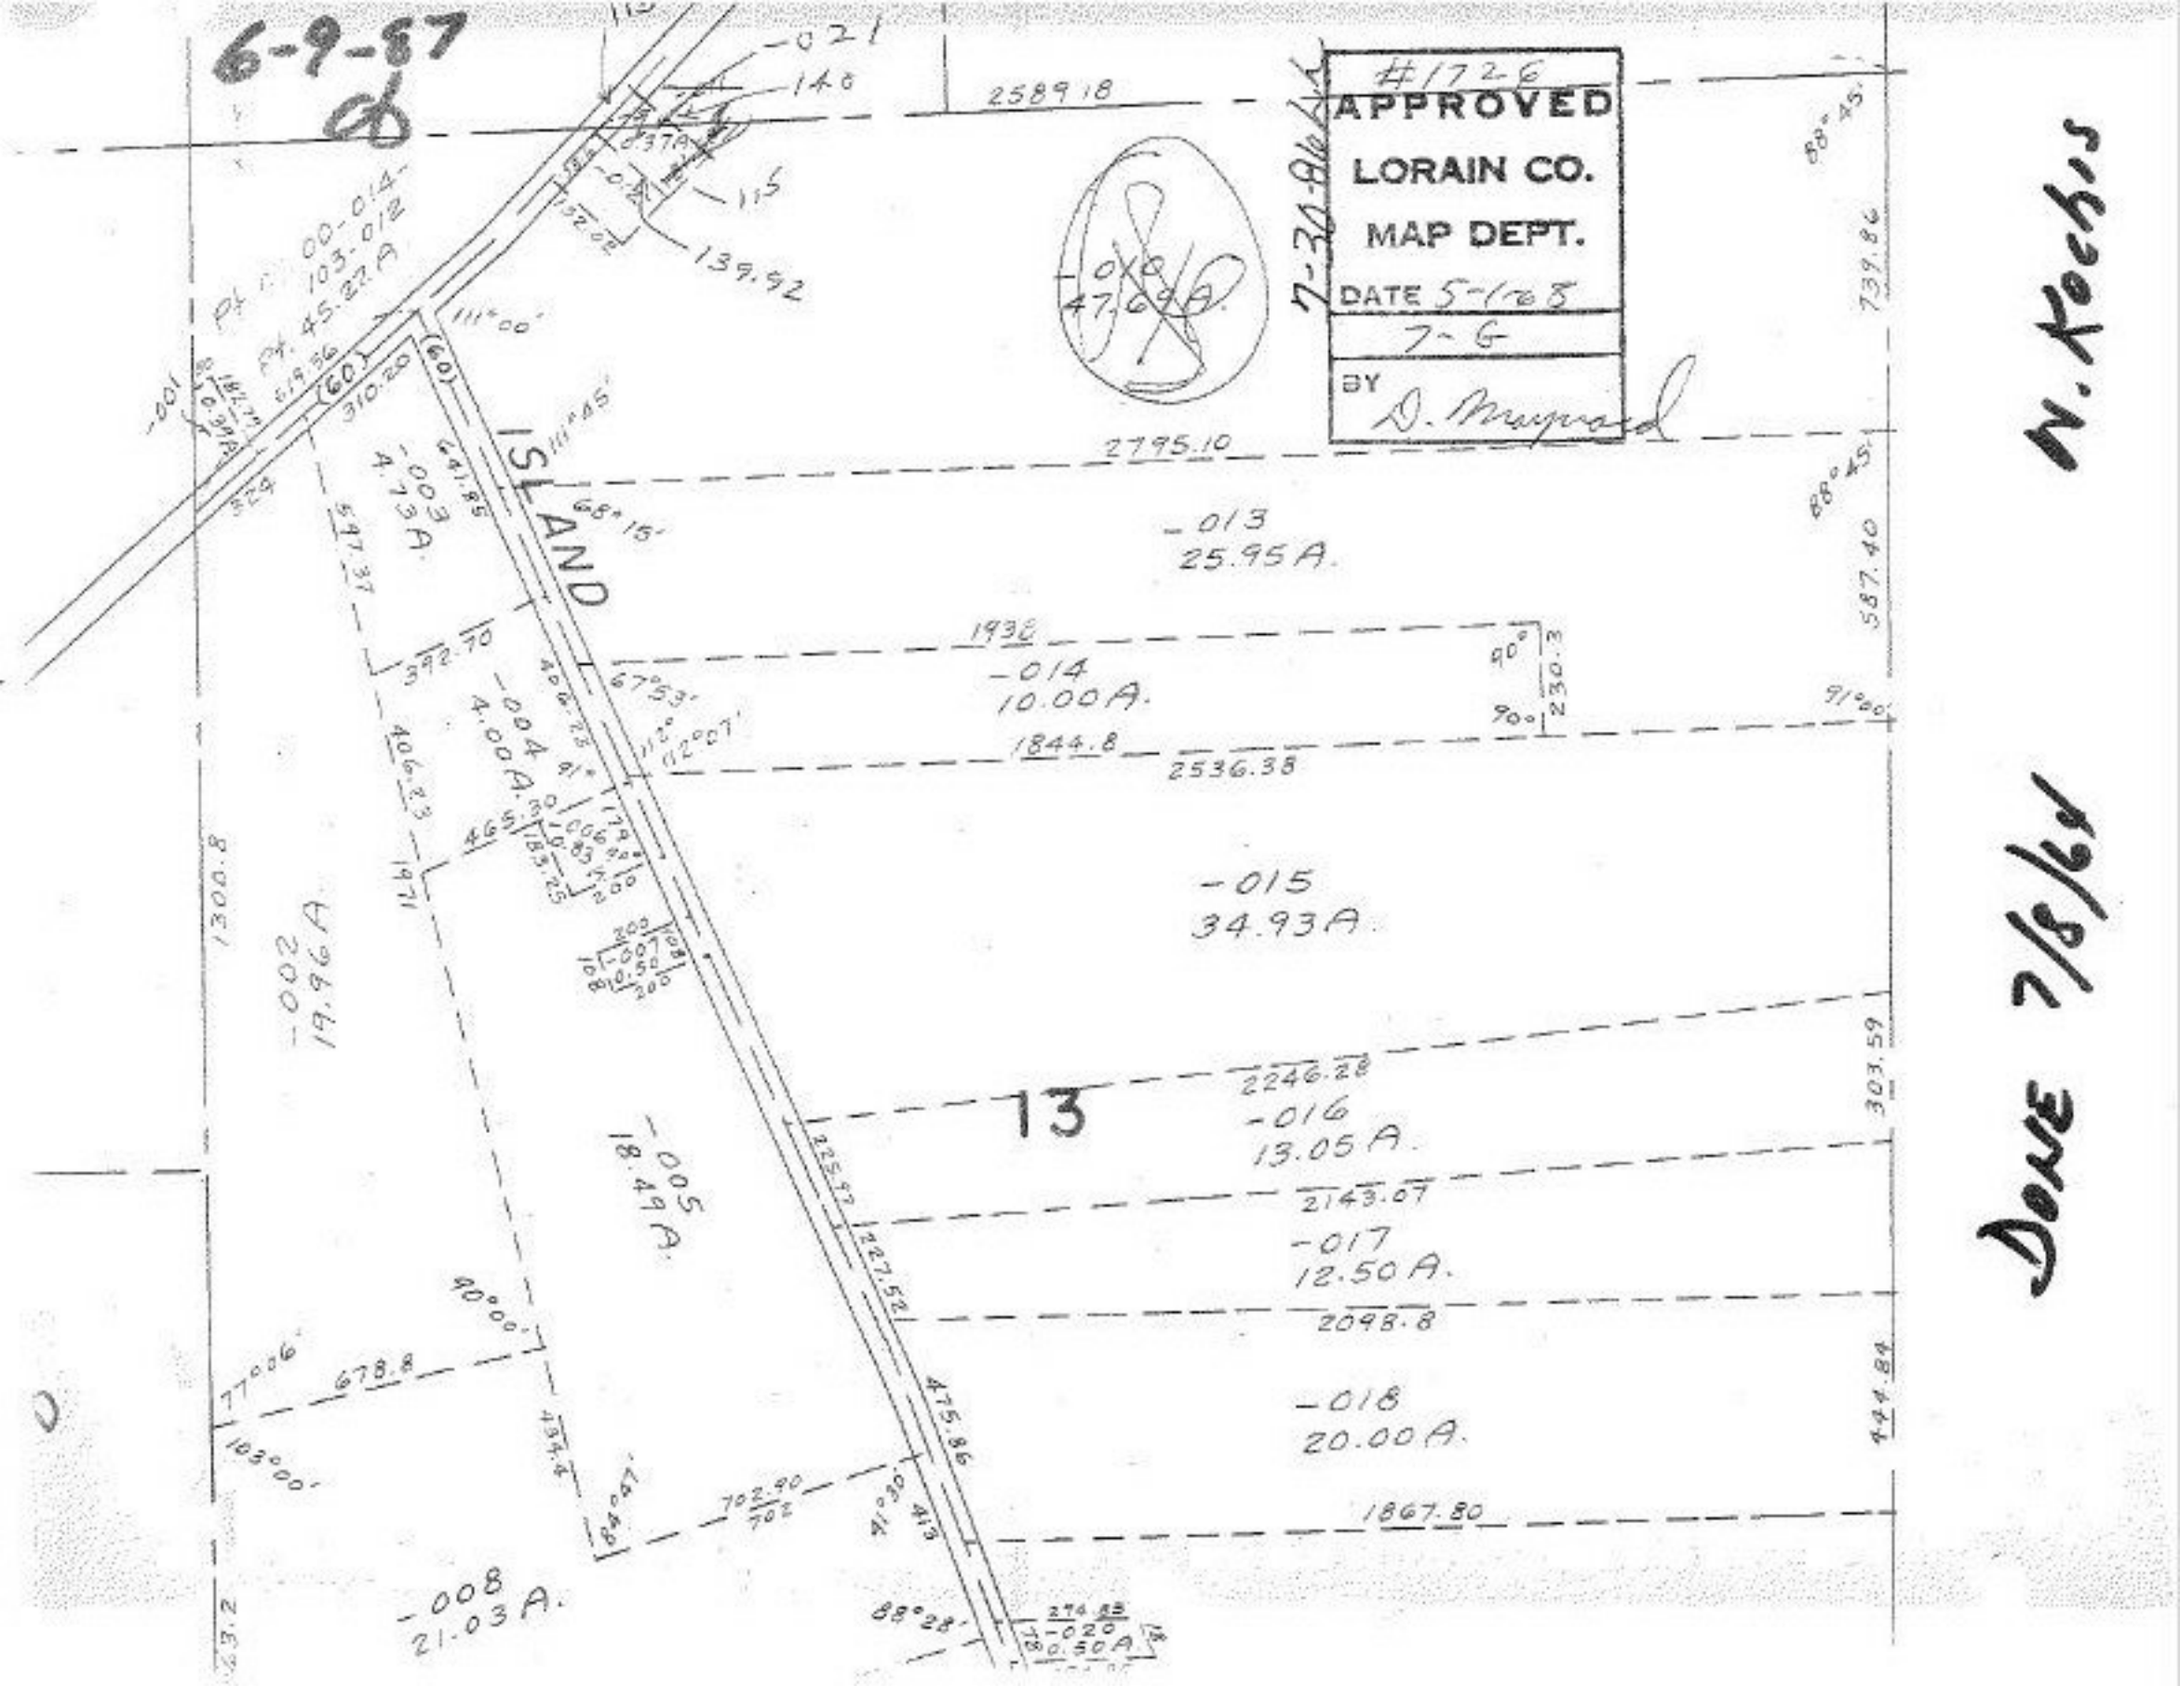
6-9-87
#1726
APPROVED
LORAIN CO.
MAP DEPT.
DATE 5-12-87
7-6
BY D. Maynard
7-30-86
ISLAND
13
-001
-002
19.96A
-003
4.73A.
-004
4.00A.
-005
18.49A.
-008
21.03A.
-013
25.95A.
-014
10.00A.
-015
34.93A.
-016
13.05A.
-017
12.50A.
-018
20.00A.
-020
0.50A.
-021
1.40
0.37A.
0.21A.
1.15
139.92
47.08A.
2589.18
2795.10
1938
1844.8
2536.38
2246.28
2143.07
2098.8
1867.80
310.20
(60)
111°00'
111°45'
68°15'
67°53'
112°07'
88°45'
91°00'
90°00'
40°00'
77°06'
103°00'
41°30'
88°28'
1300.8
739.86
587.40
303.59
444.84
475.86
227.52
678.8
702.90
Dowe 7/8/87
N. Rocks