-001
57.50A

-002
20.42A

Pt. -047
Pt. 85.41 A

COMBINATION

08-00-093-000

SM 6-9-87
#17261

APPROVED
LORAIN CO.
MAP DEPT.
DATE 2-5-87
PAGE 8-00-093-A
BY C. Francis
VOID AFTER 17261
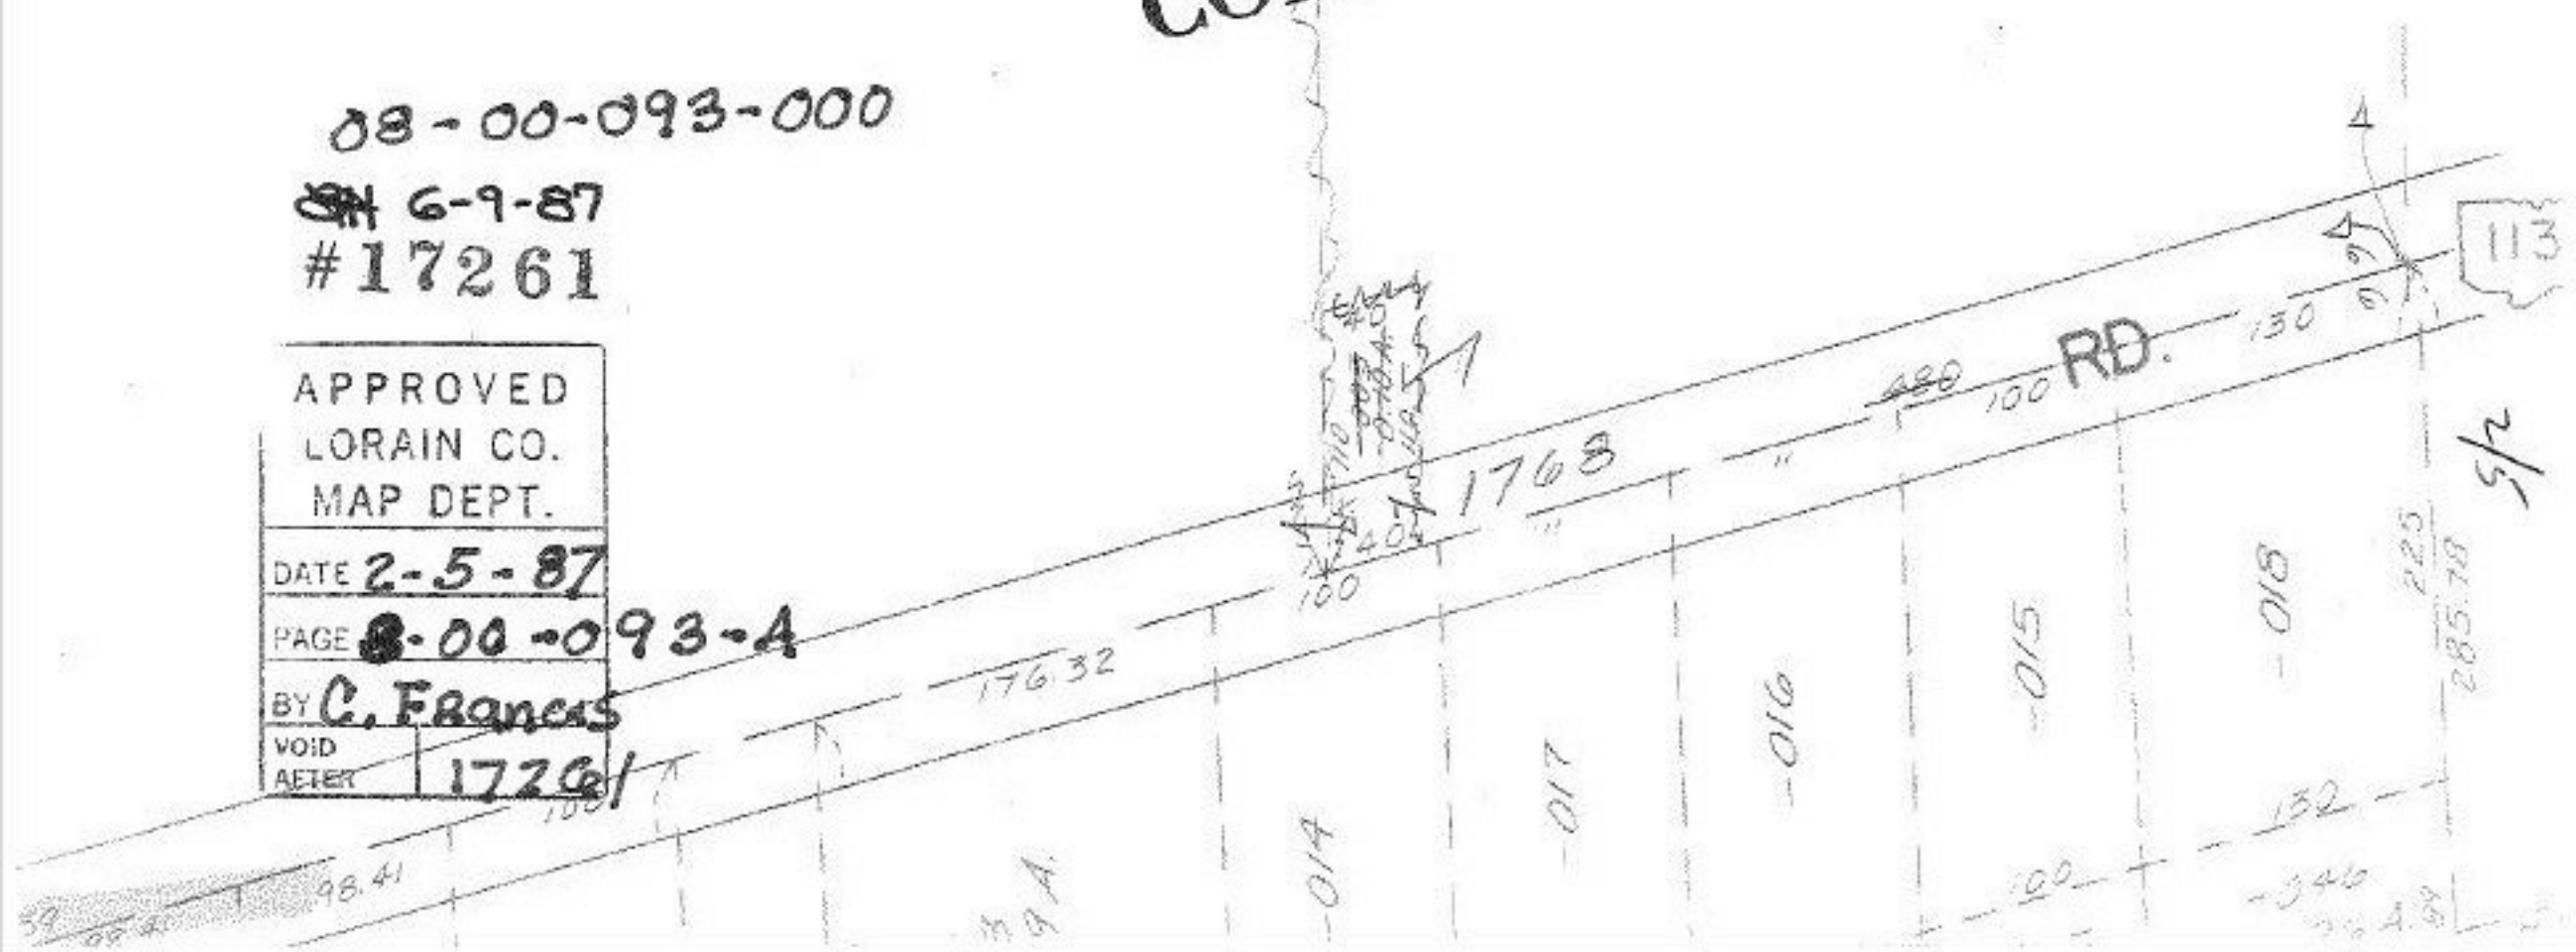
After Meas. 650 To Nw Corner Of -033 Put In Brake Line ——— 650', ——— To Nw, Corner Of -033