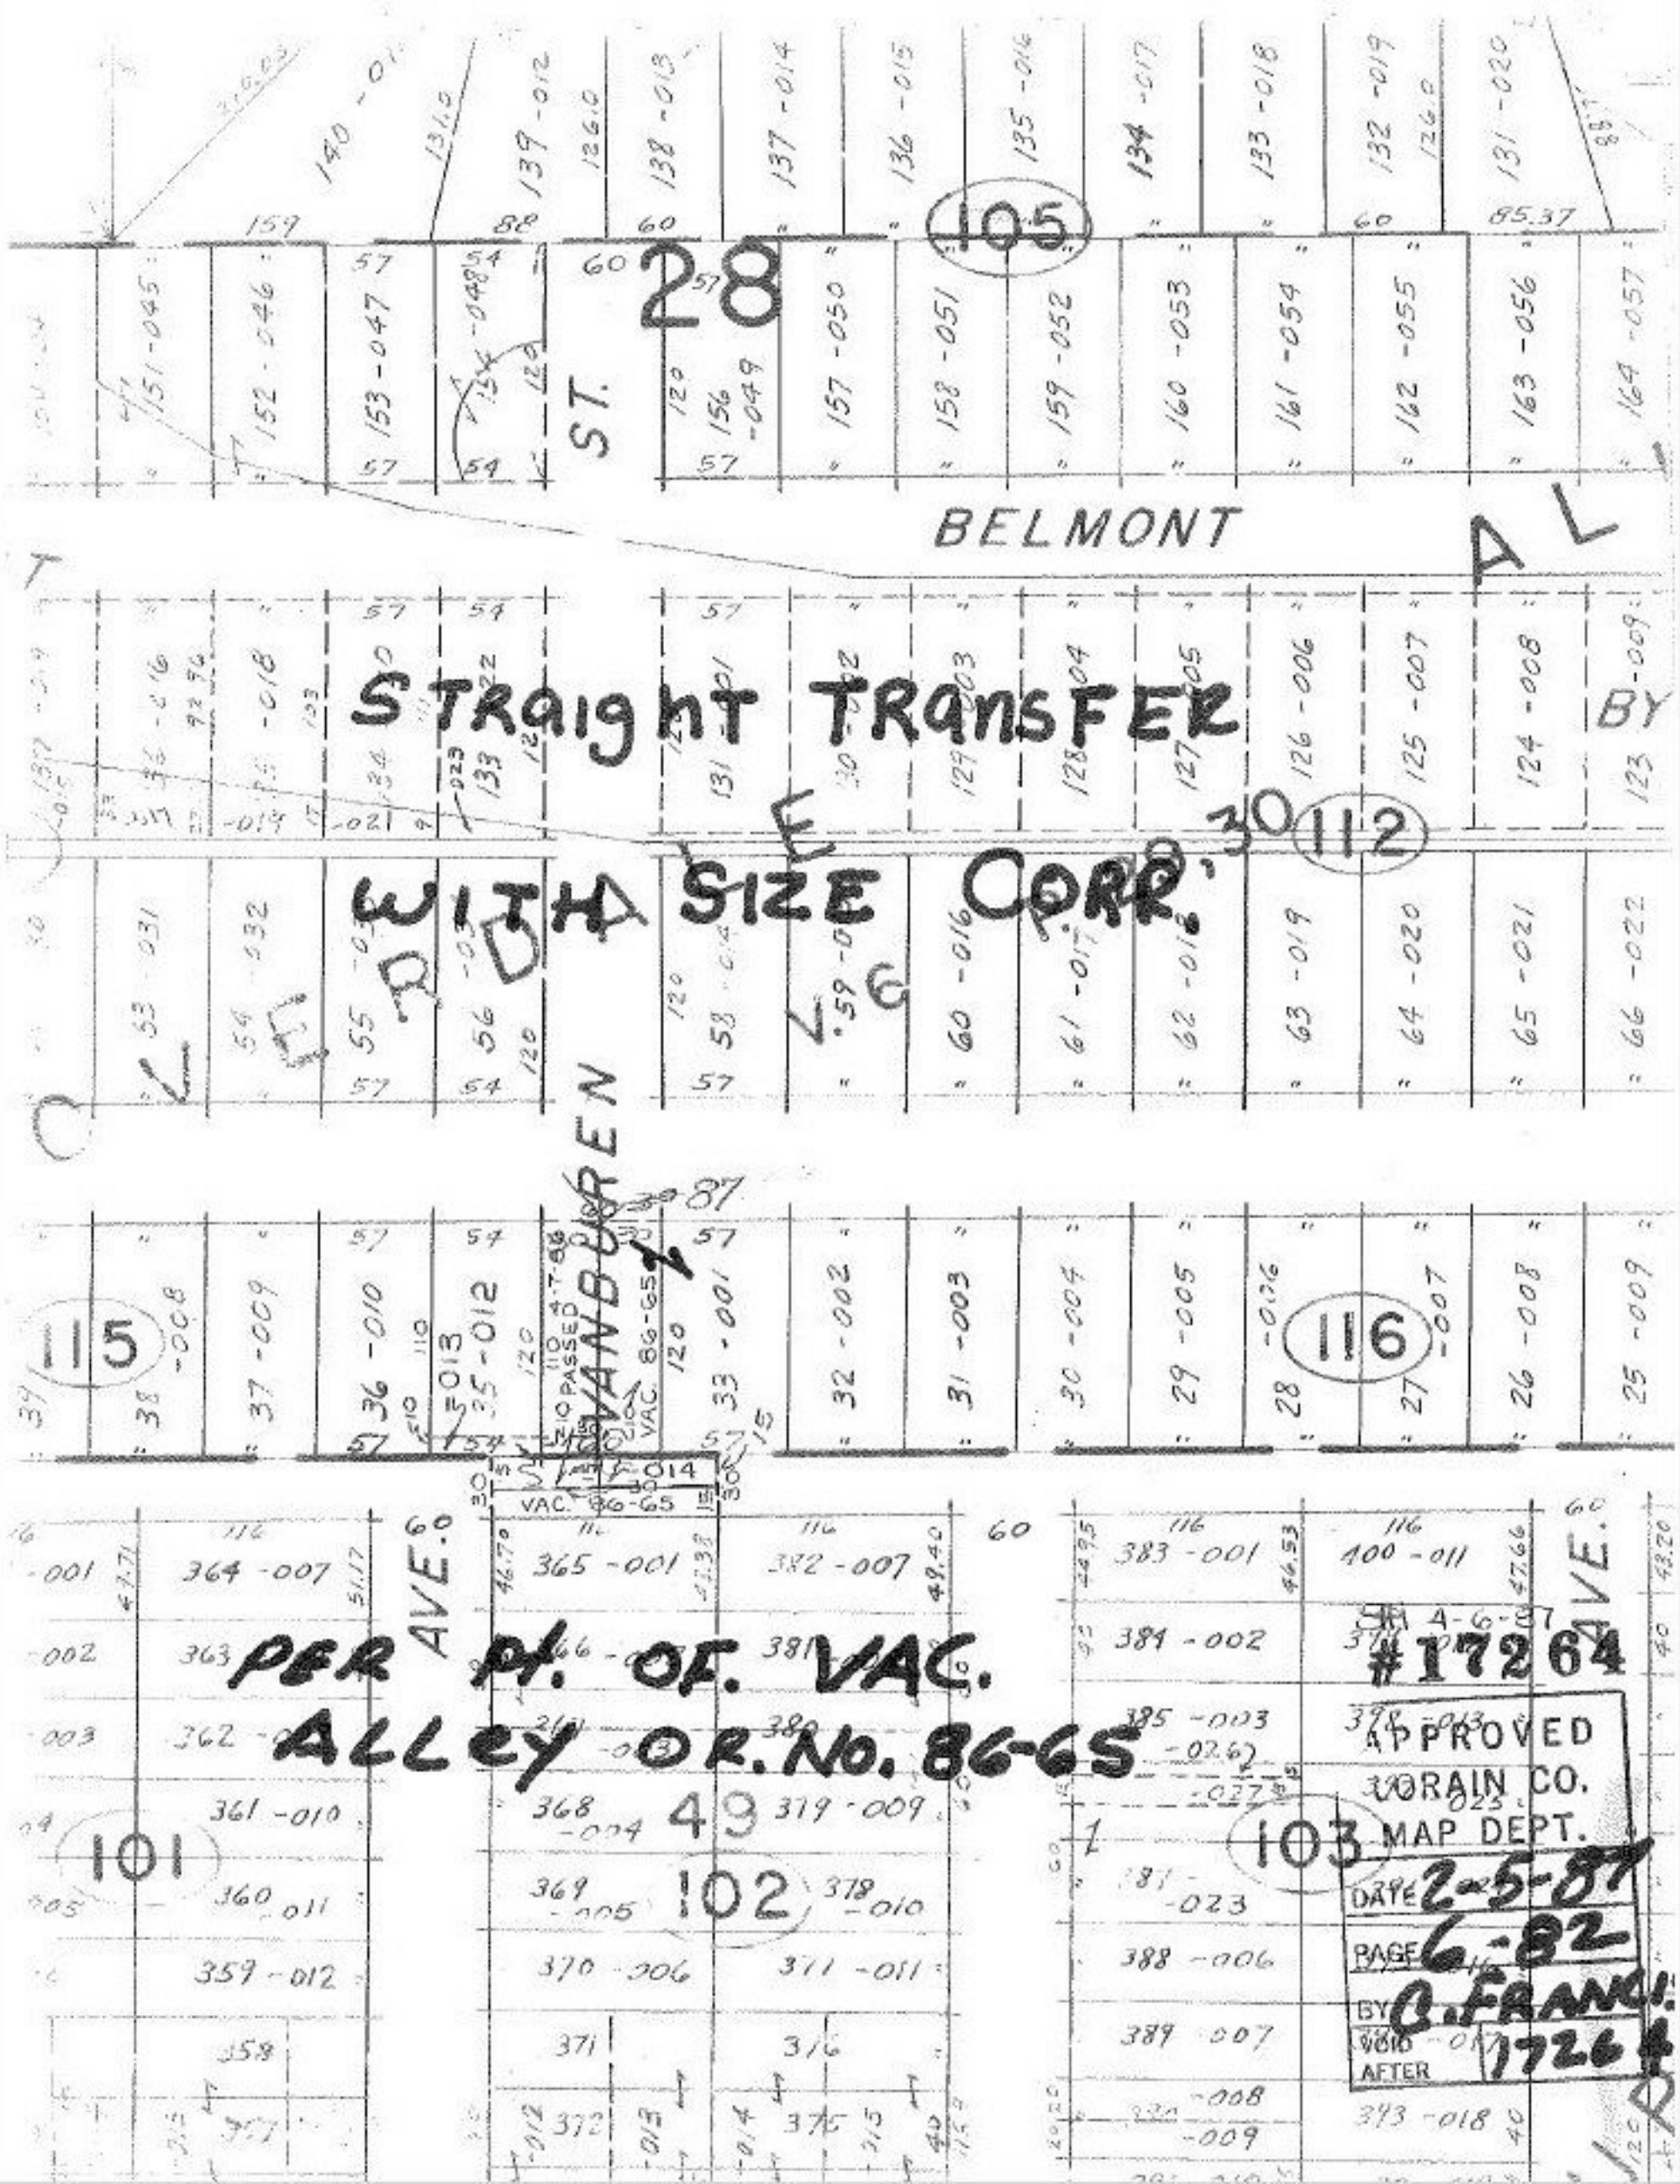
BELMONT
AL
ST.
28
105
112
BY
STRAIGHT TRANSFER
WITH SIZE CORR.
REF
REN
VAN BUREN
115
116
VAC. 86-65
PER PL. OF. VAC.
ALLEY OR. NO. 86-65
AVE.
101
102
103
49
#17264
APPROVED
LORAIN CO.
MAP DEPT.
DATE 2-5-87
PAGE 6-82
BY C. FRANCIS
VOID AFTER 17264