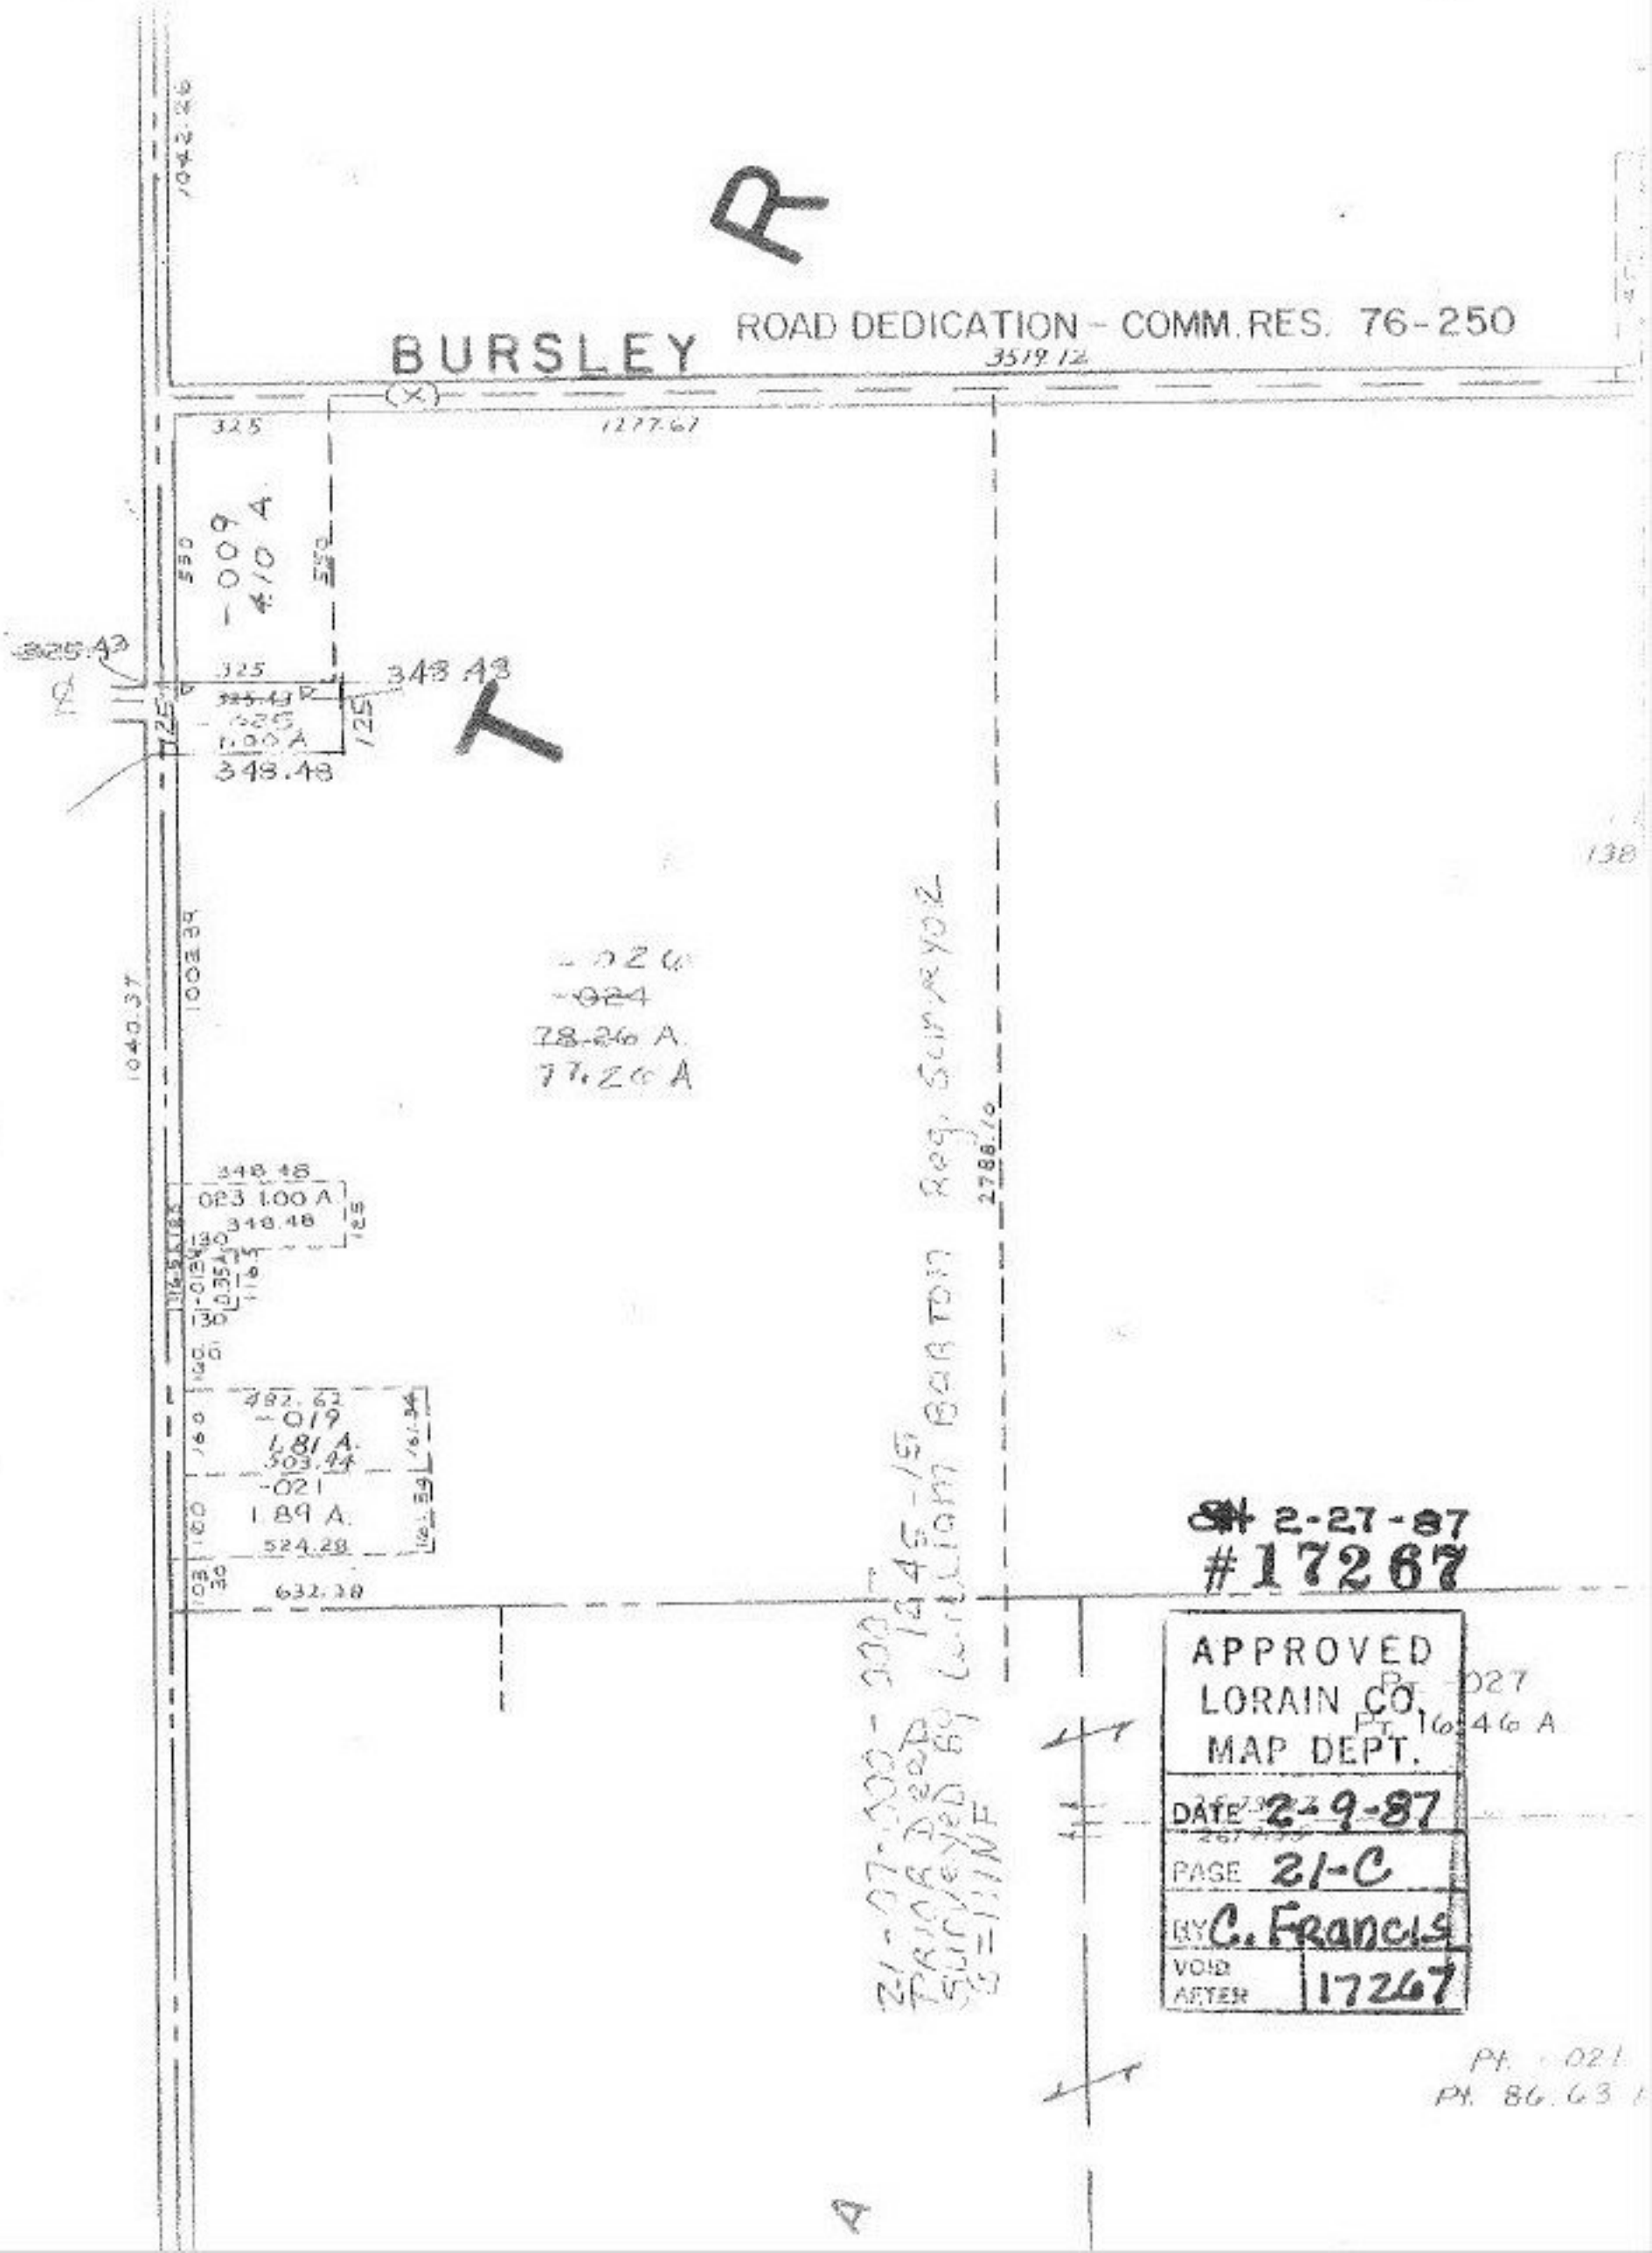

BURSLEY
ROAD DEDICATION - COMM. RES. 76-250
3519.12
1277.67
325
-009
410 A
325.43
348.48
-025
1.00 A
348.48
-026
-024
78.26 A
77.26 A
1040.37
1002.39
348.48
-023 1.00 A
348.48
482.62
-019
1.81 A
503.44
-021
1.89 A
524.28
632.38
2788.10
21-07-000-000
PRIOR DEED
SURVEYED BY
G=1:1NF
1645-15
William Barton Reg. Surveyor
2-27-87
#17267
APPROVED
LORAIN CO.
MAP DEPT.
DATE 2-9-87
PAGE 21-C
BY C. Francis
VOID AFTER 17267
Pt. -027
Pt. 16.46 A
Pt. -021
Pt. 86.63