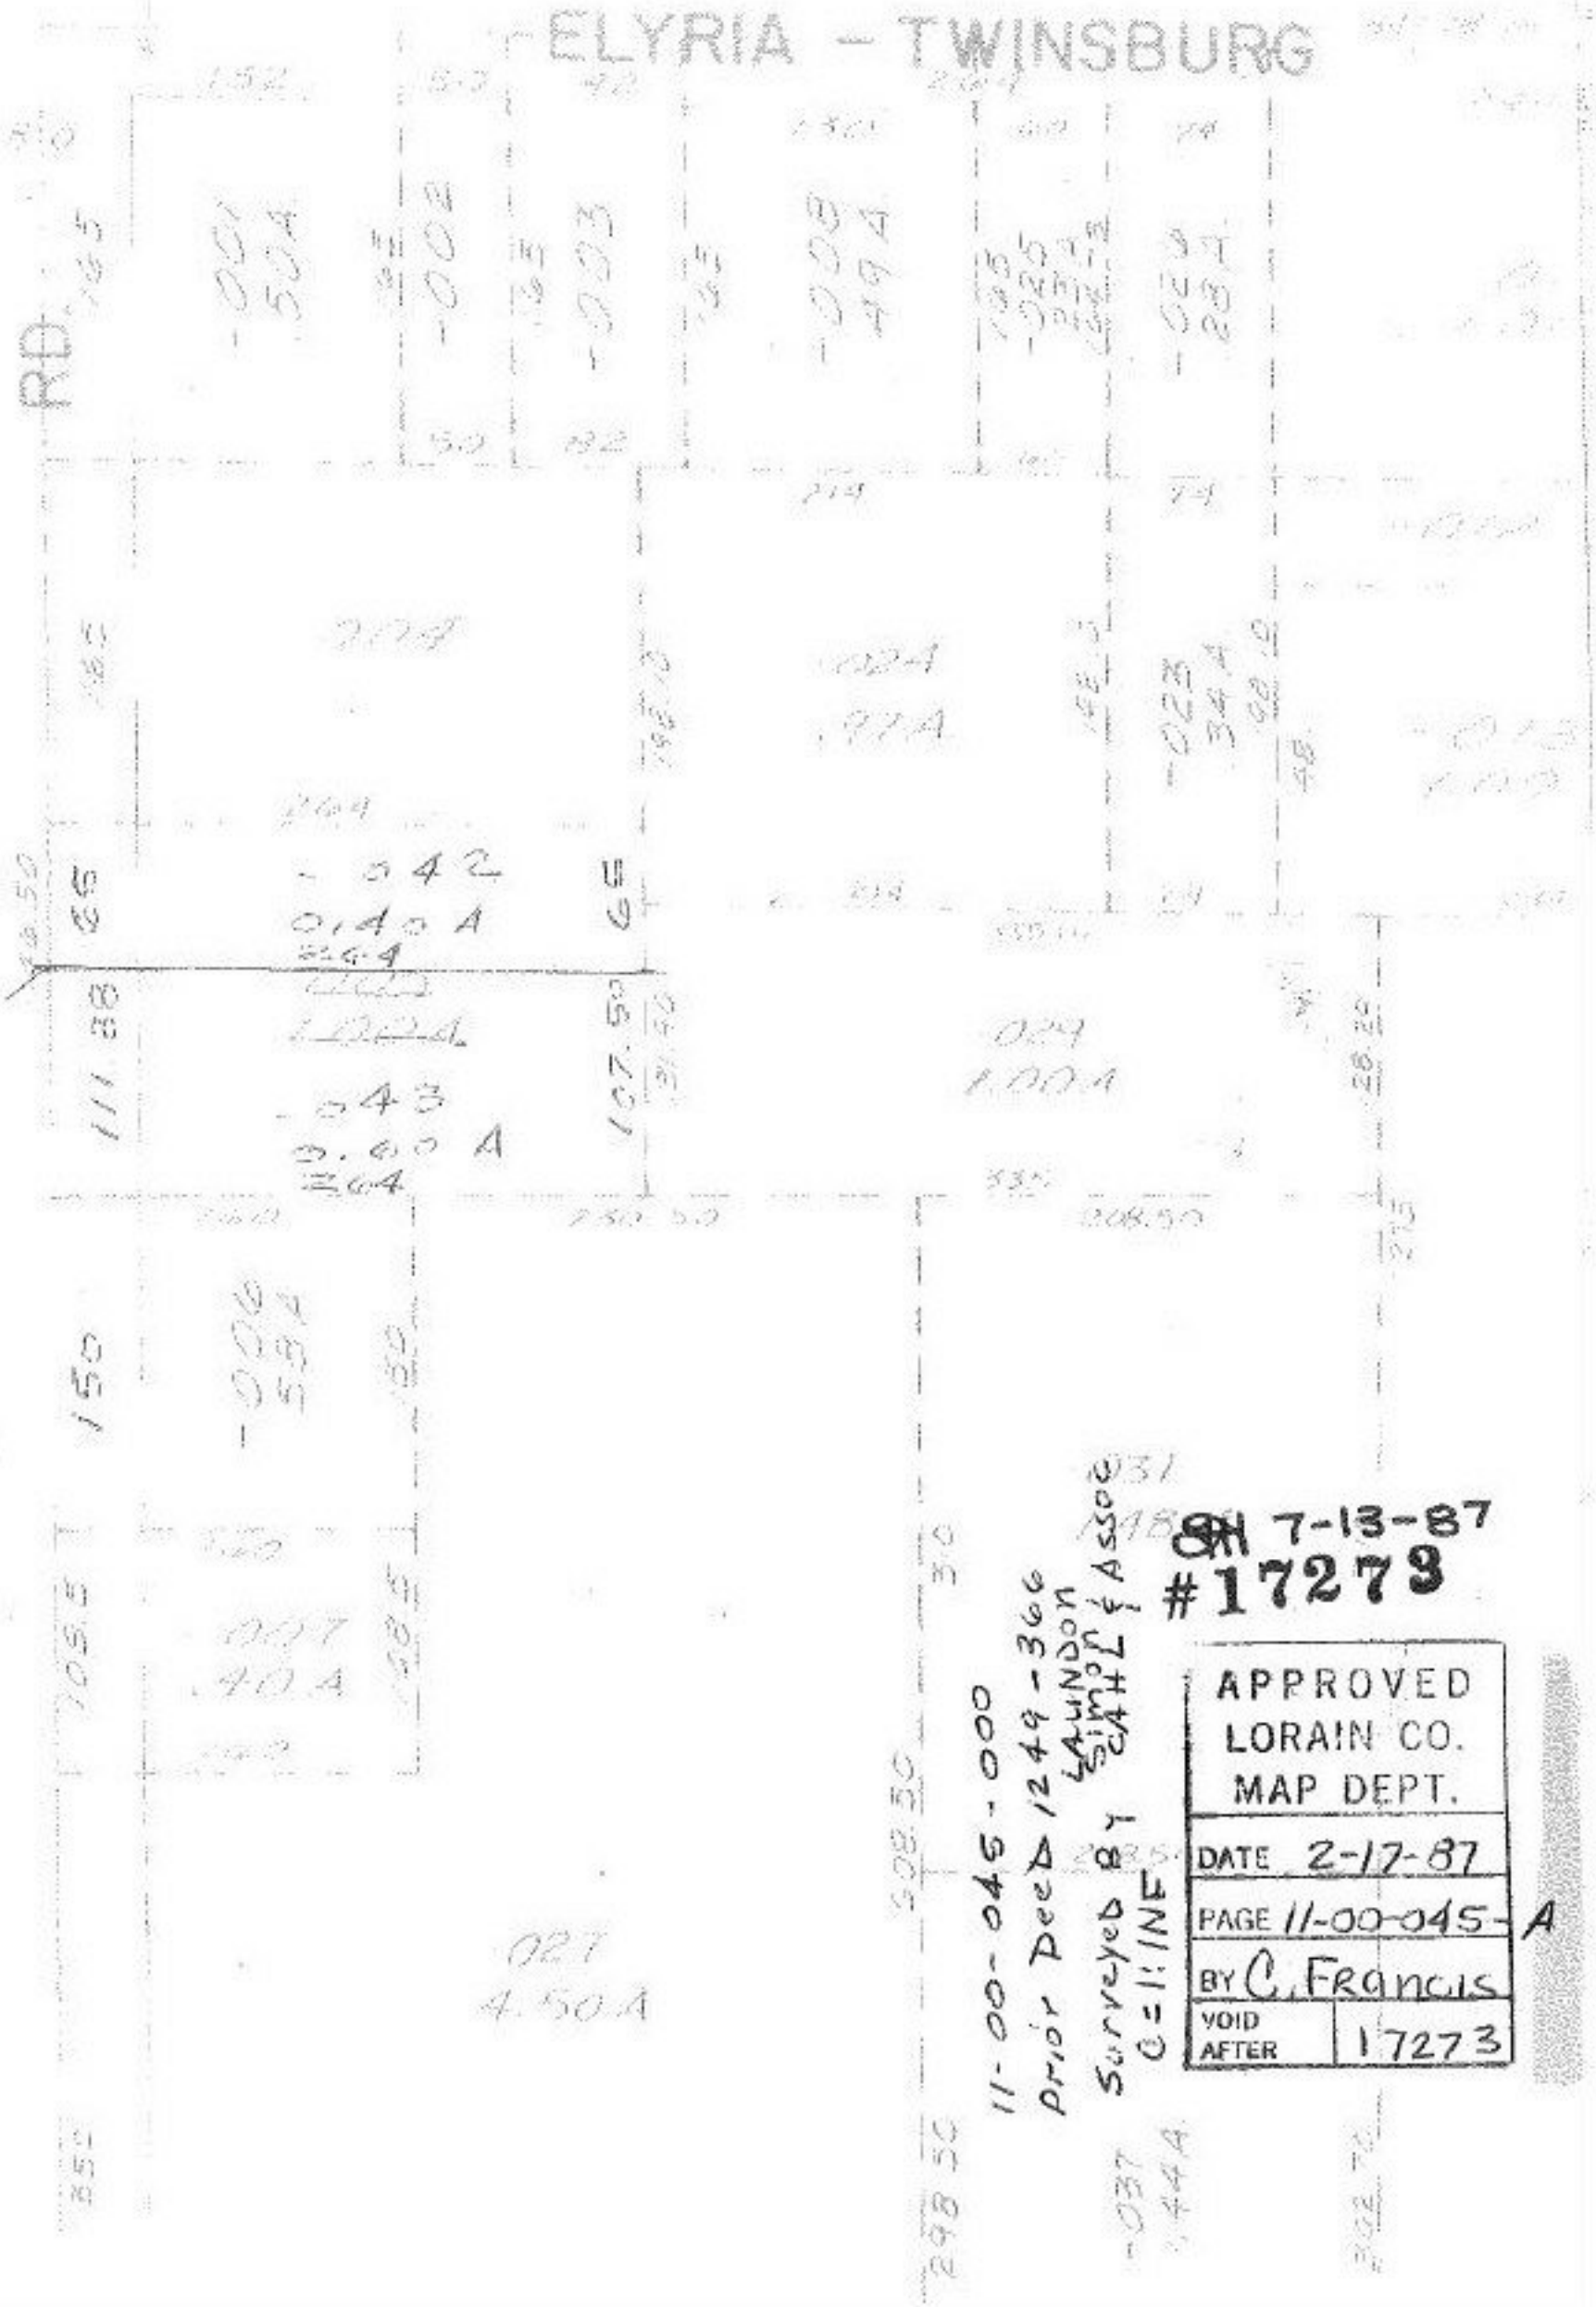
ELYRIA - TWINSBURG
RD.
.042
0.40 A
.043
3.60 A
.027
4.50 A
11-00-045-000
Prior Deed 1249-366
Surveyed By LAUNDON SIMON & ASSOC
C=1:INF
7-13-87
#17273
APPROVED
LORAIN CO.
MAP DEPT.
DATE 2-17-87
PAGE 11-00-045-A
BY C. Francis
VOID AFTER 17273