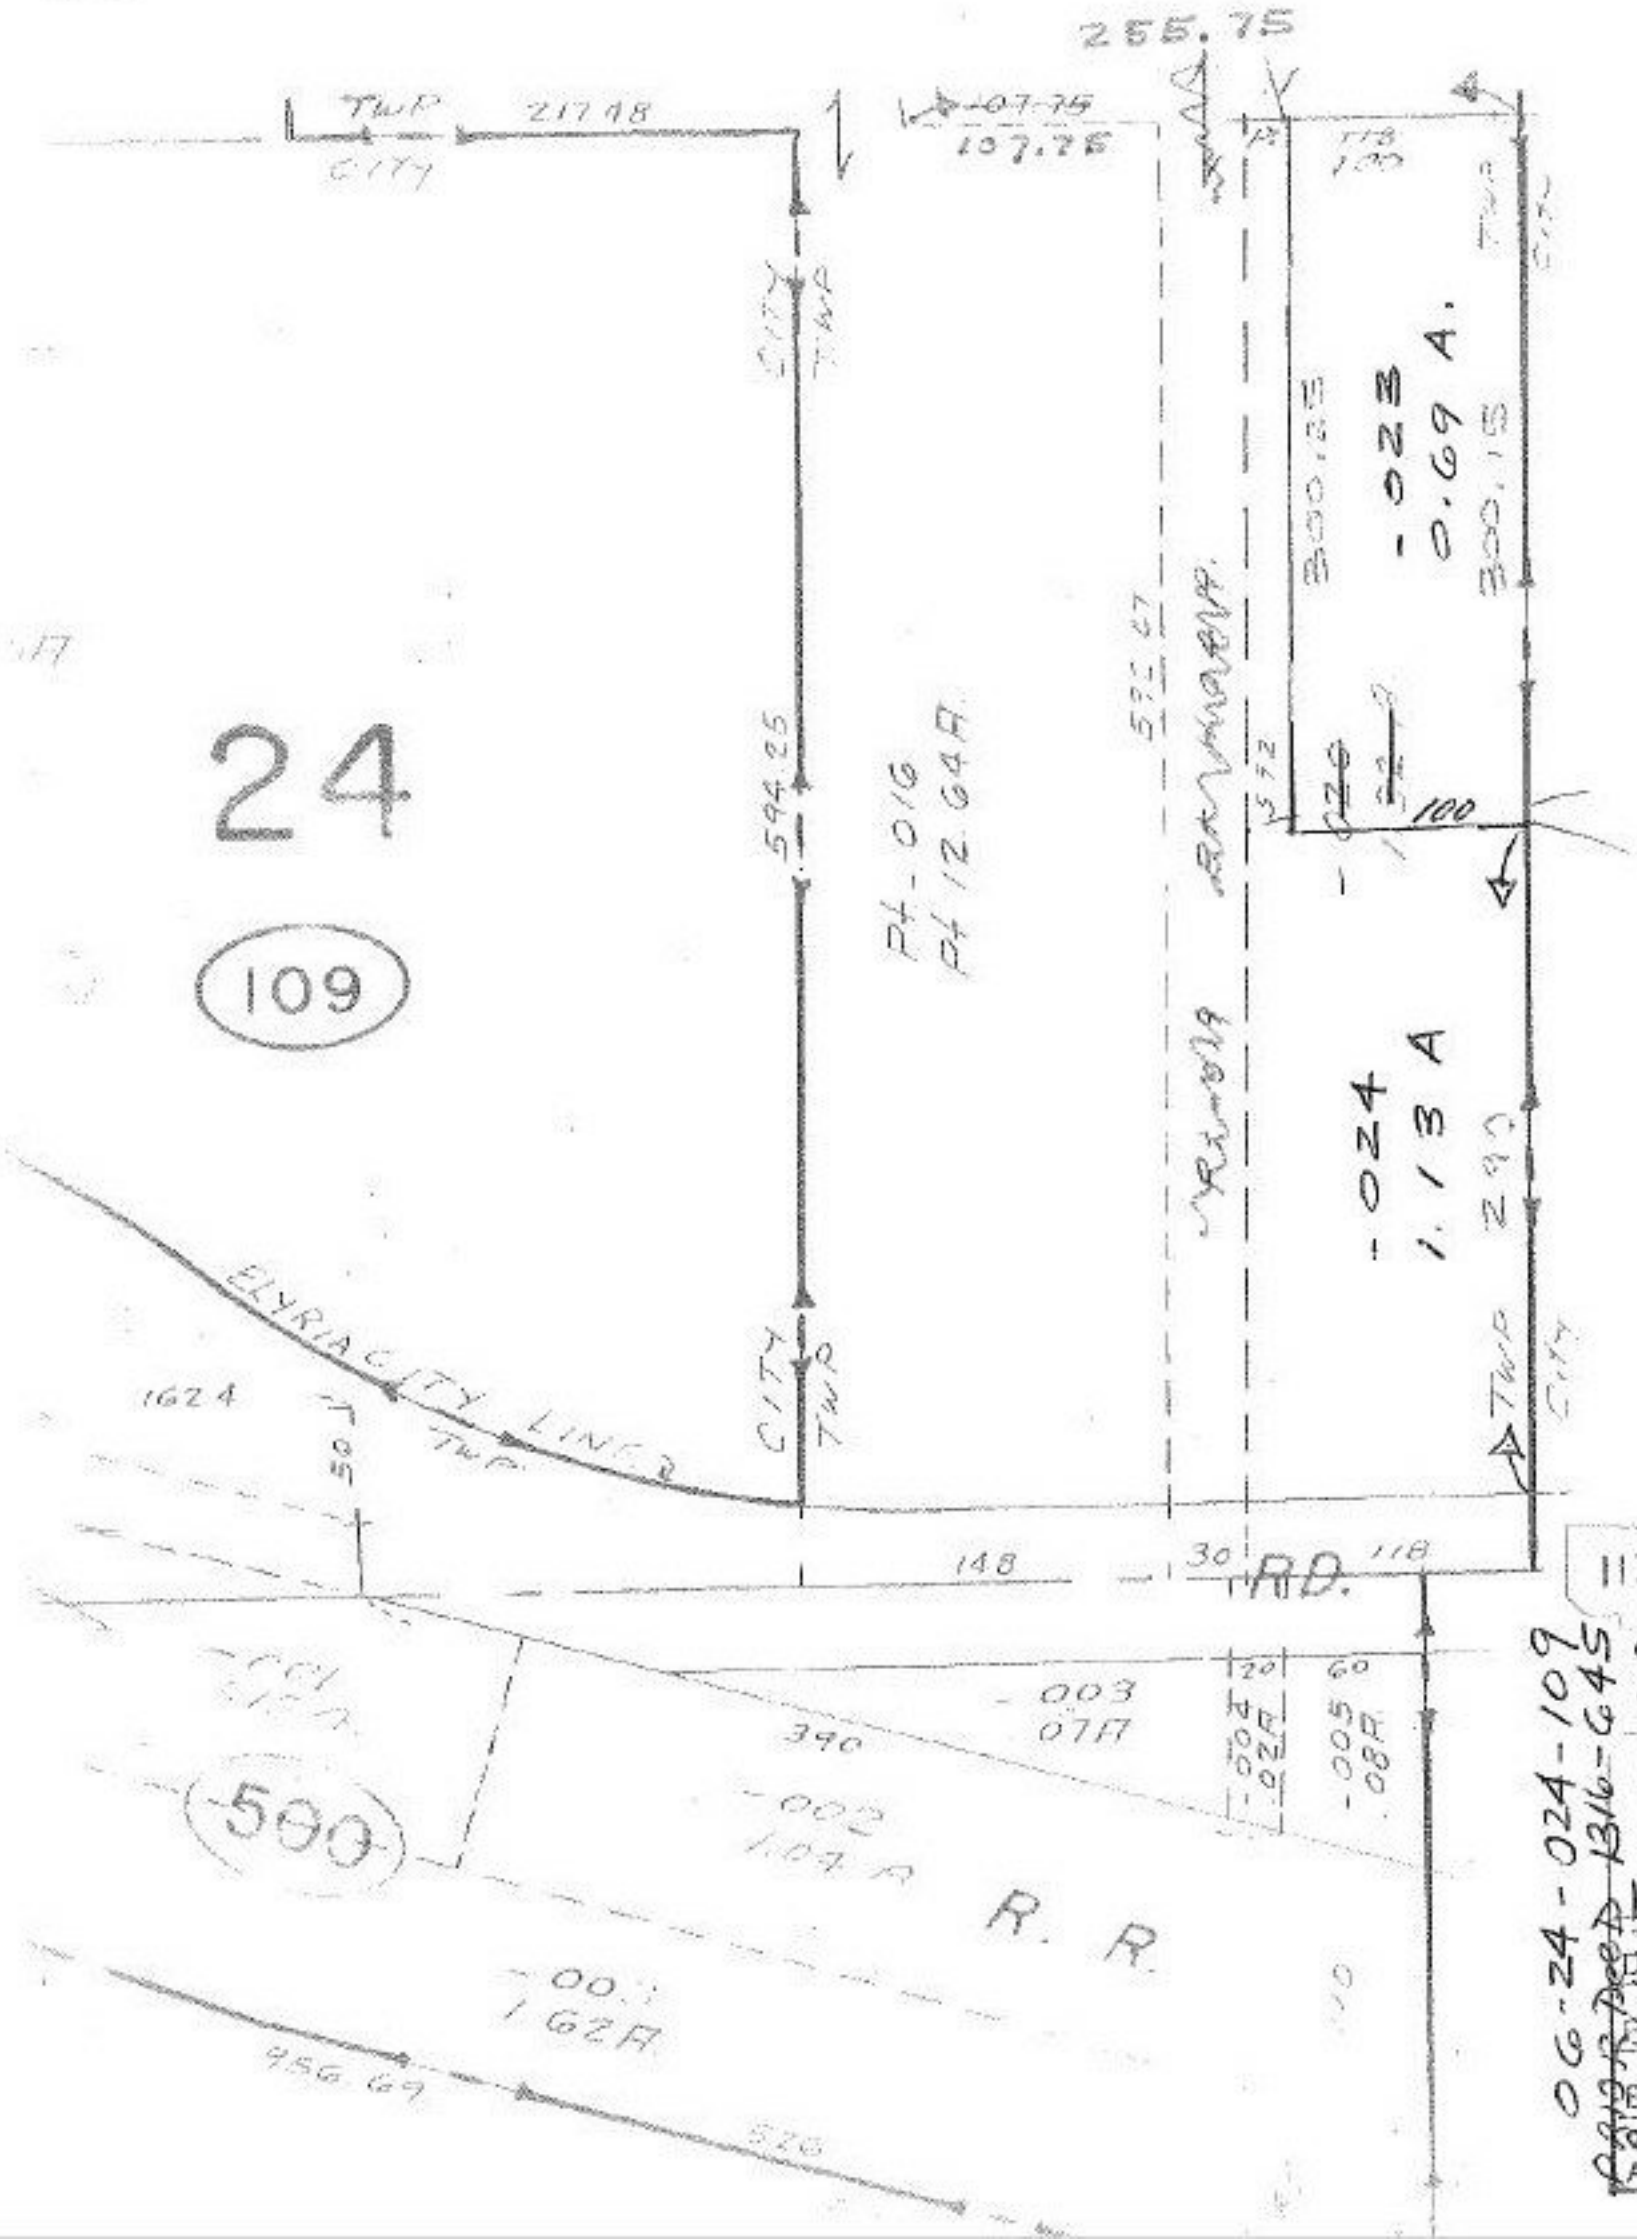

06-24-024-109
PRIOR DEED 1316-645

CH 4-6-87

#17283

APPROVED
LORAIN CO.
MAP DEPT.

DATE 2-24-87

PAGE 6-95

BY C. Francis

VOID AFTER 17283