SEE 6-138

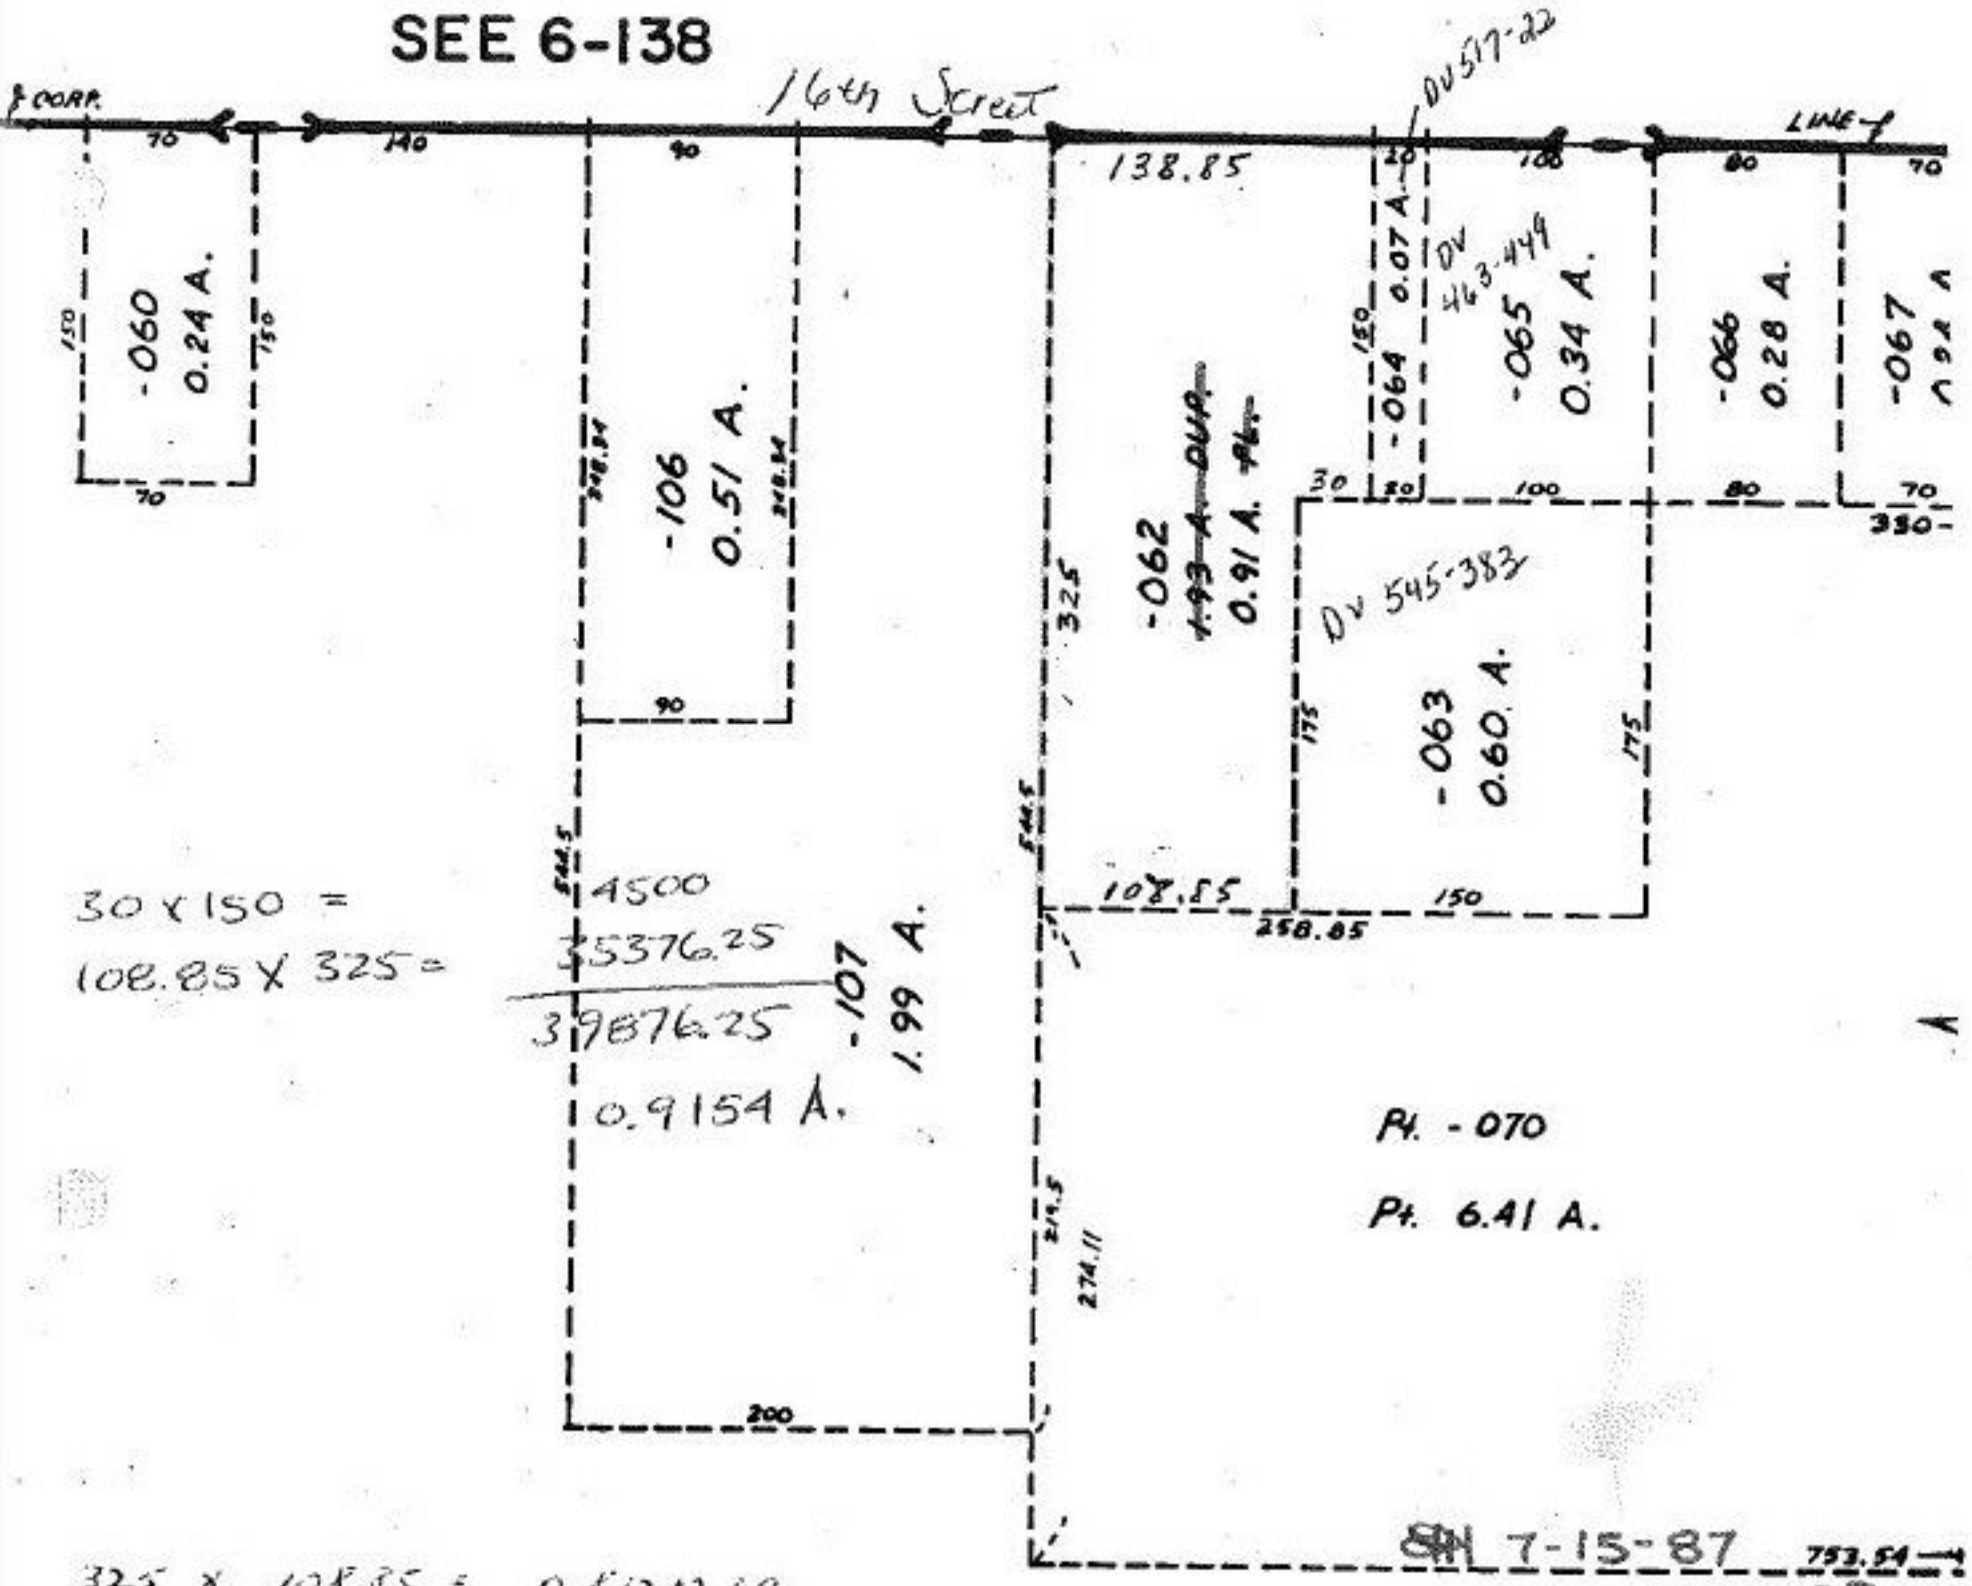

30 x 150 = 4500

108.85 X 325 = 35376.25

39876.25

0.9154 A.

325 X 108.85 = 0.8121269

30 X 150 = 0.1023057

0.9154326