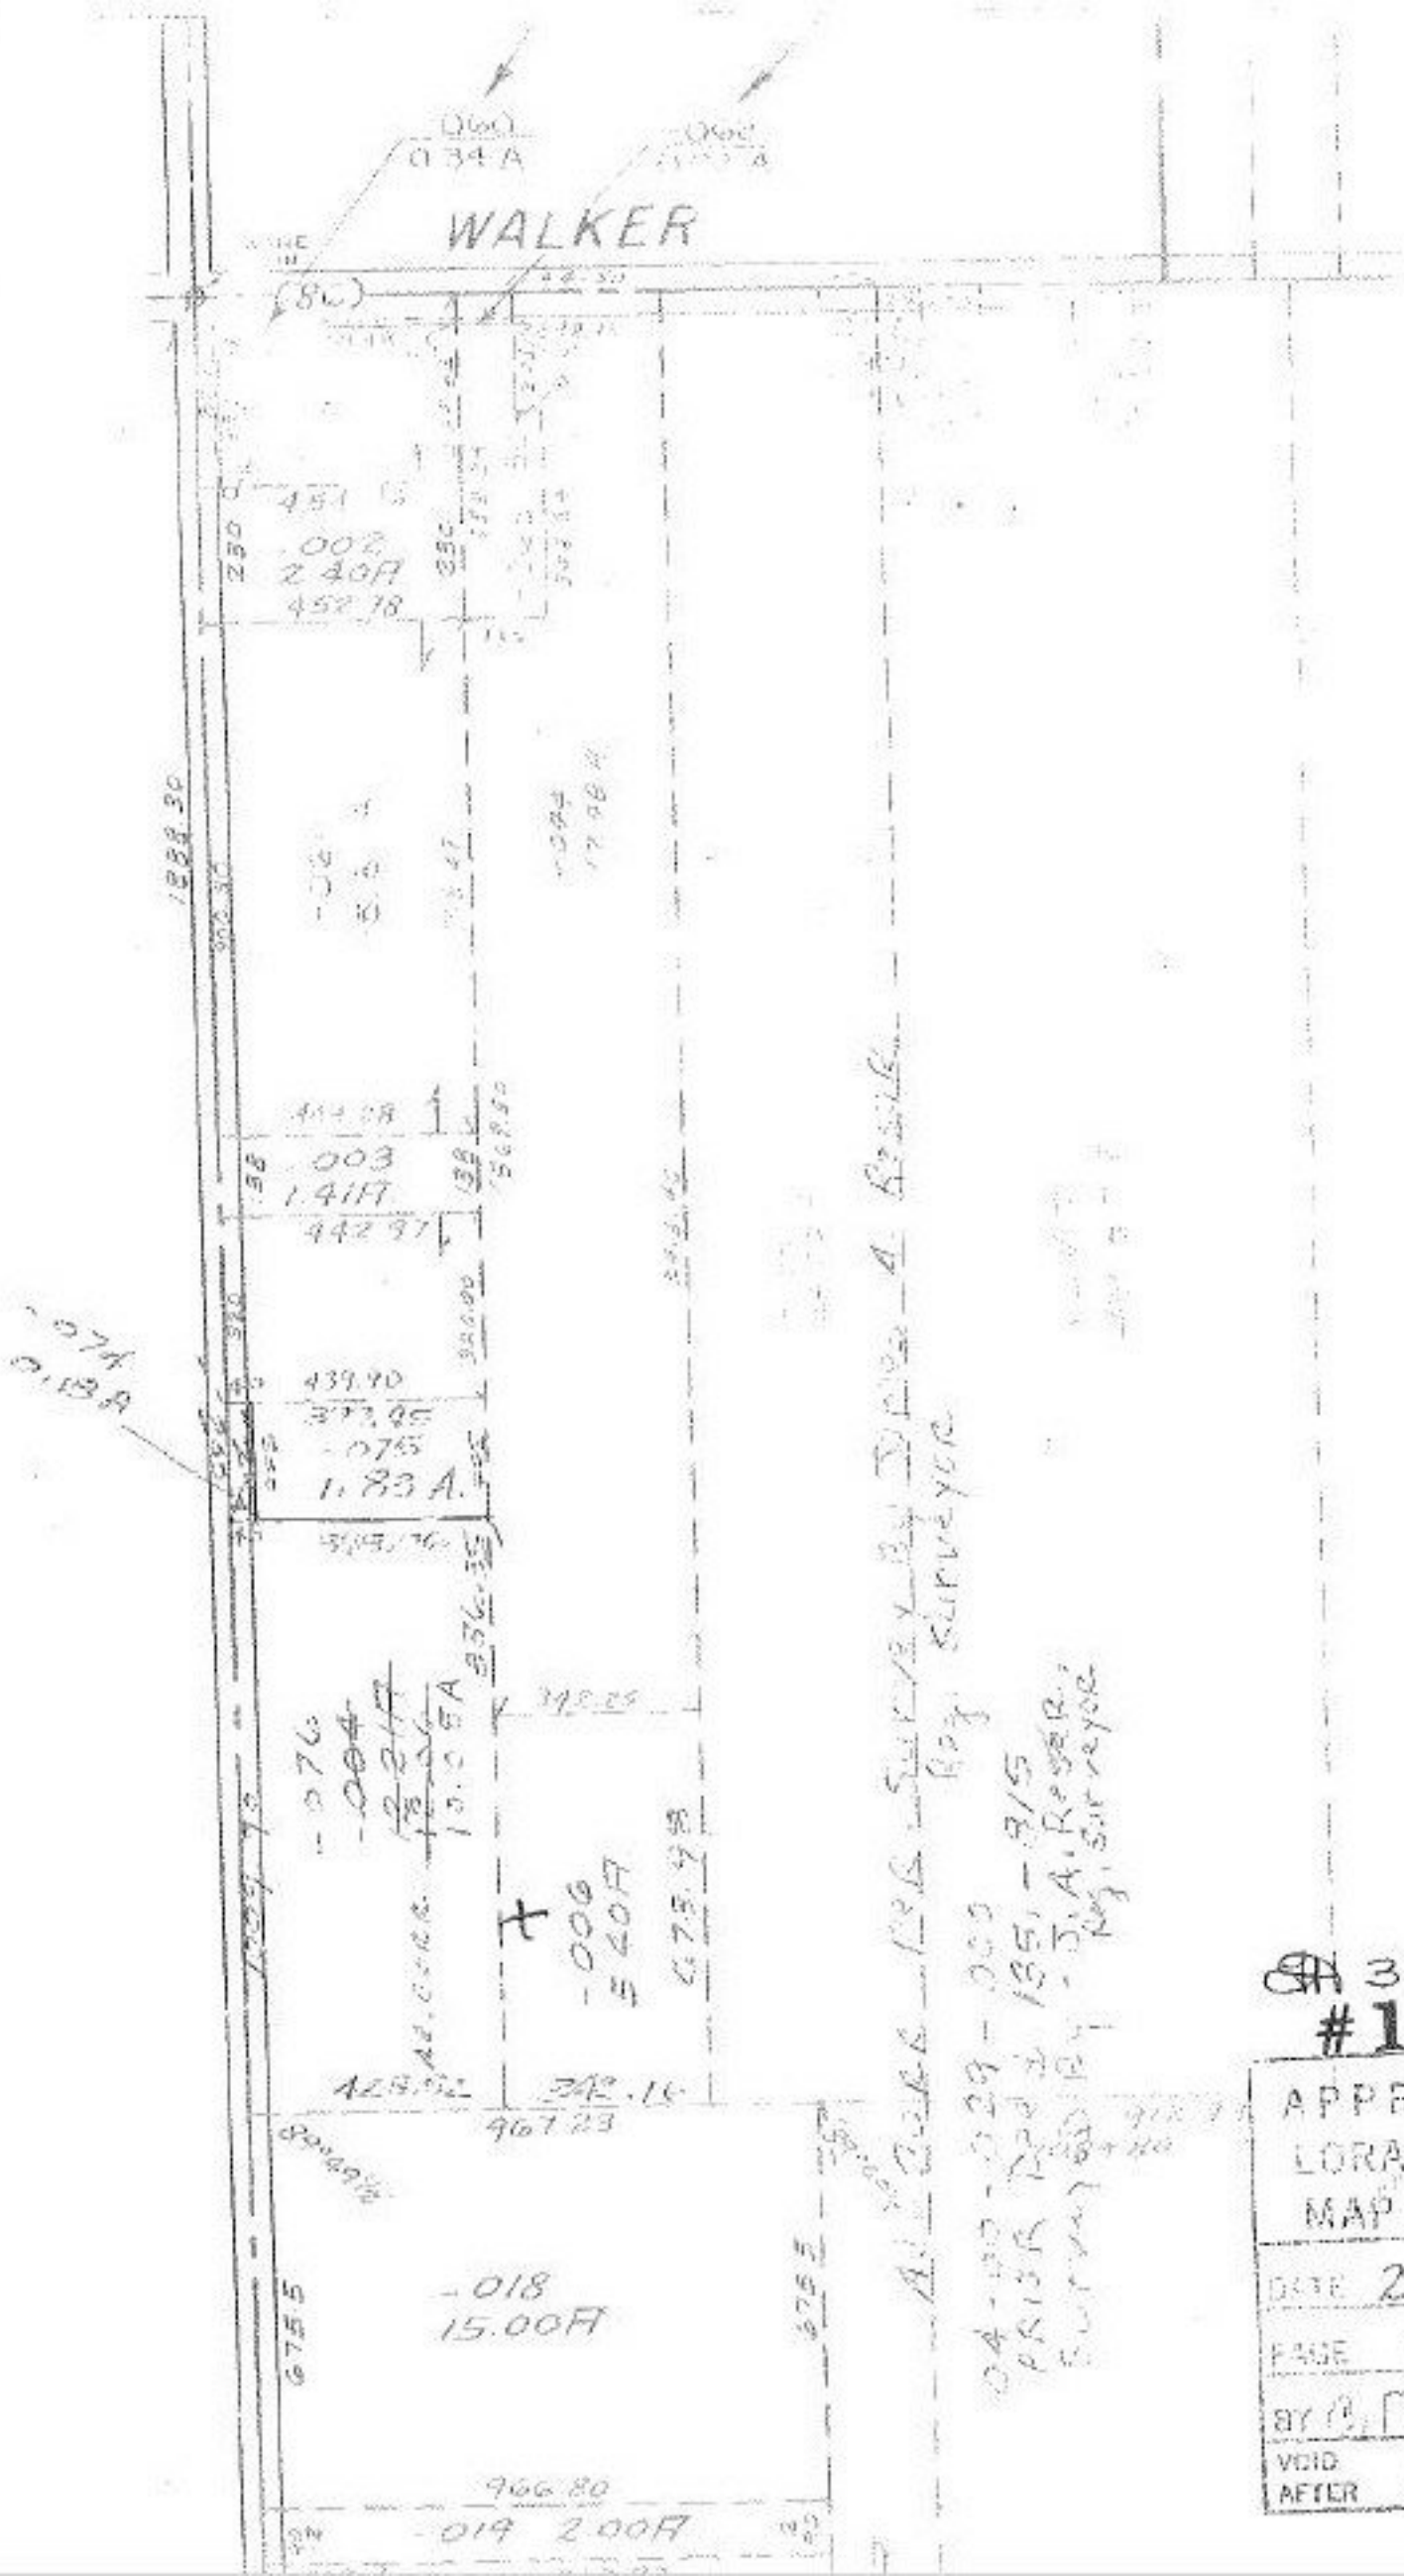

3-24-87
#17288

APPROVED
LORAIN CO.
MAP DEPT.

DATE 2-25-87
PAGE 4+D
BY [illegible]
VOID AFTER [illegible]