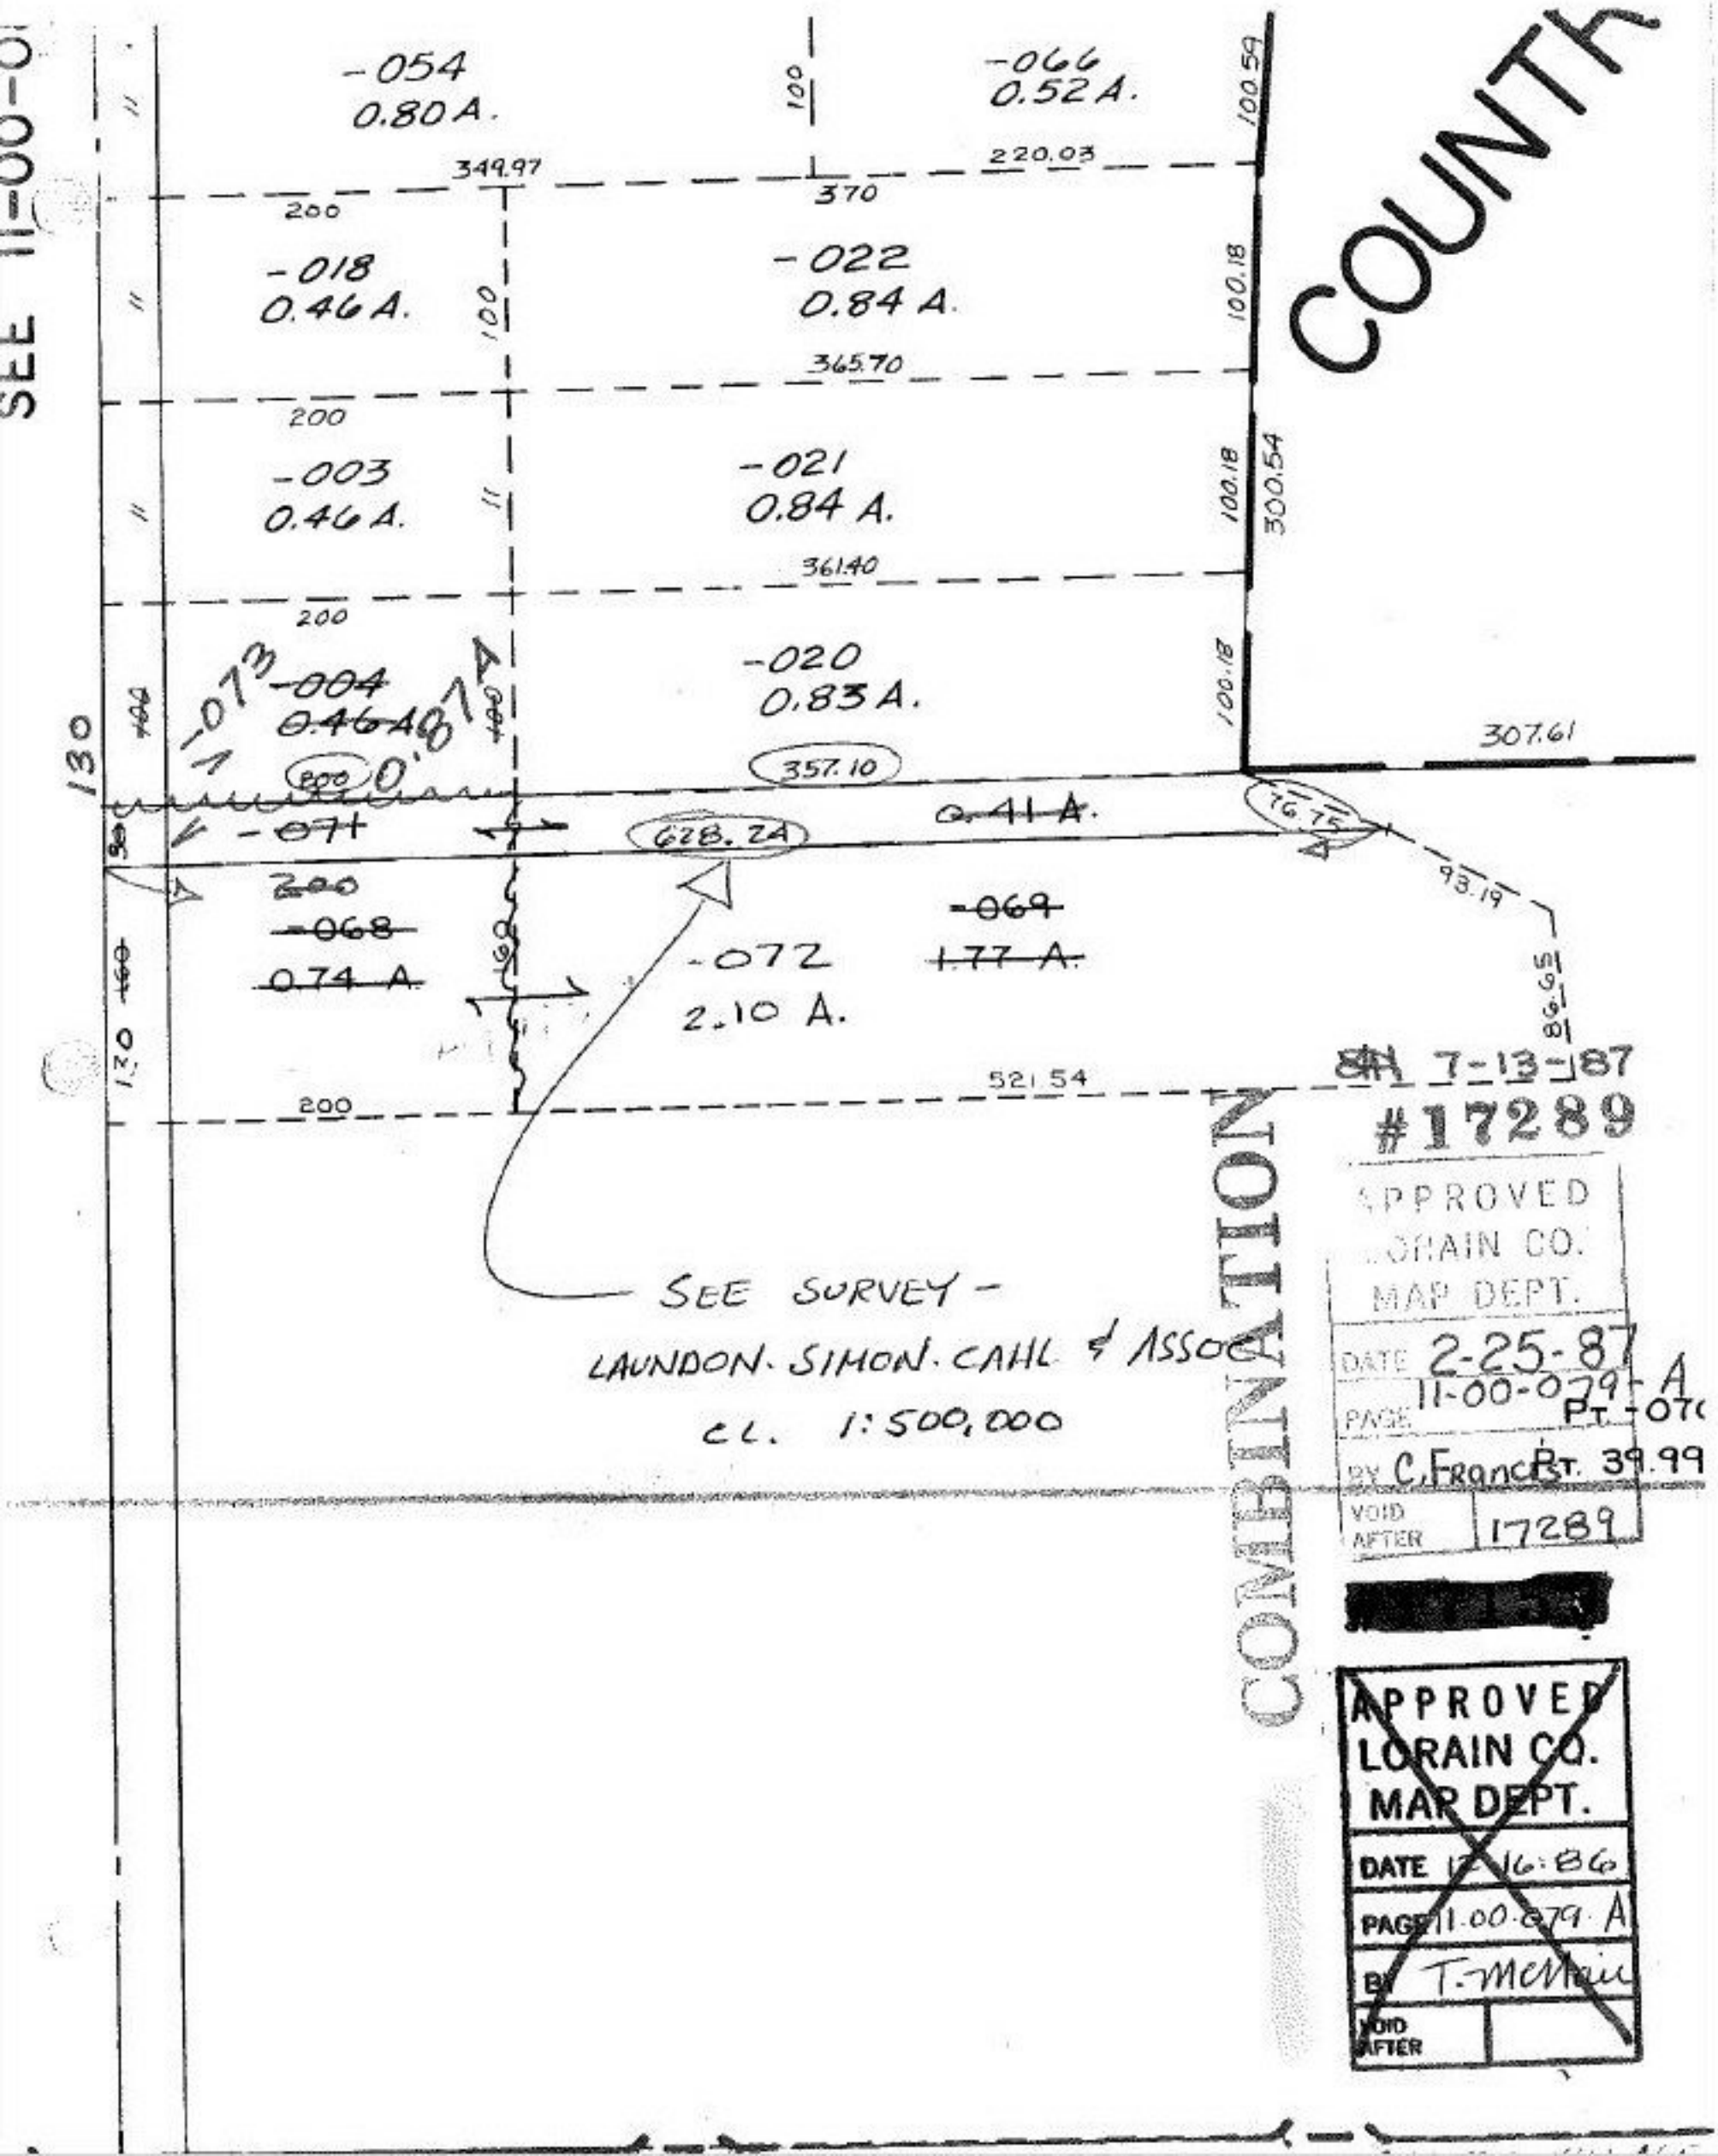
SEE 11-00-0
COUNTR
-054
0.80 A.
-066
0.52 A.
100
100.59
349.97
220.03
370
200
-018
0.46 A.
-022
0.84 A.
100.18
365.70
200
-003
0.46 A.
-021
0.84 A.
100.18
300.54
361.40
200
-073
-004
0.46 A
0.87 A
-020
0.83 A.
100.18
307.61
130
357.10
-071
628.24
0.41 A.
76.75
93.19
200
-068
0.74 A.
-069
1.77 A.
-072
2.10 A.
86.65
130
521.54
200
SEE SURVEY -
LAUNDON. SIMON. CAHL & ASSOC
CL. 1:500,000
COMBINATION
7-13-87
#17289
APPROVED
LORAIN CO.
MAP DEPT.
DATE 2-25-87
PAGE 11-00-079-A
PT. -070
BY C. Francis
PT. 39.99
VOID AFTER 17289
[redacted]
APPROVED
LORAIN CO.
MAP DEPT.
DATE 12-16-86
PAGE 11-00-079-A
BY T. McNair
VOID AFTER