2/26

-003
4.31 A.

-004
4.31 A.

-005
8.62 A.

COMBINATION

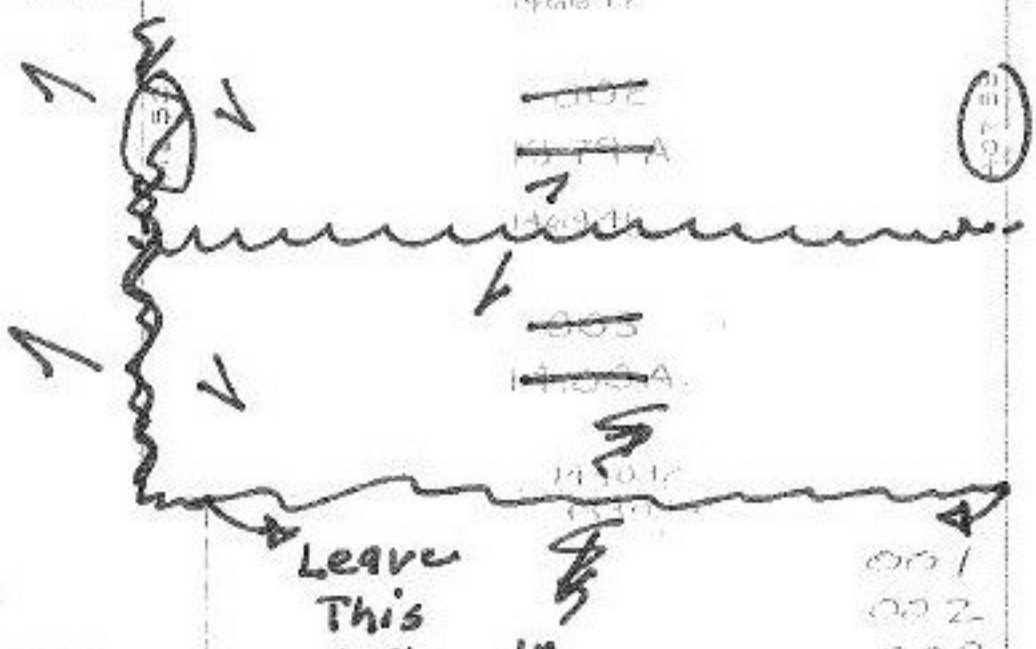

-009
108.95 A

001 81.16 A.
002 13.79 A.
003 14.00 A.
108.95 A

68

-006
59.84 A.

SEE 12-E

AKINS
(60)

-002
1.50 A.

-004
1.00 A.

R.C. 7-21-87
#17293
APPROVED
LORAIN CO.
MAP DEPT.
DATE 2-26-87
PAGE 12-F
BY C. Francis
VOID AFTER 17293

12-F