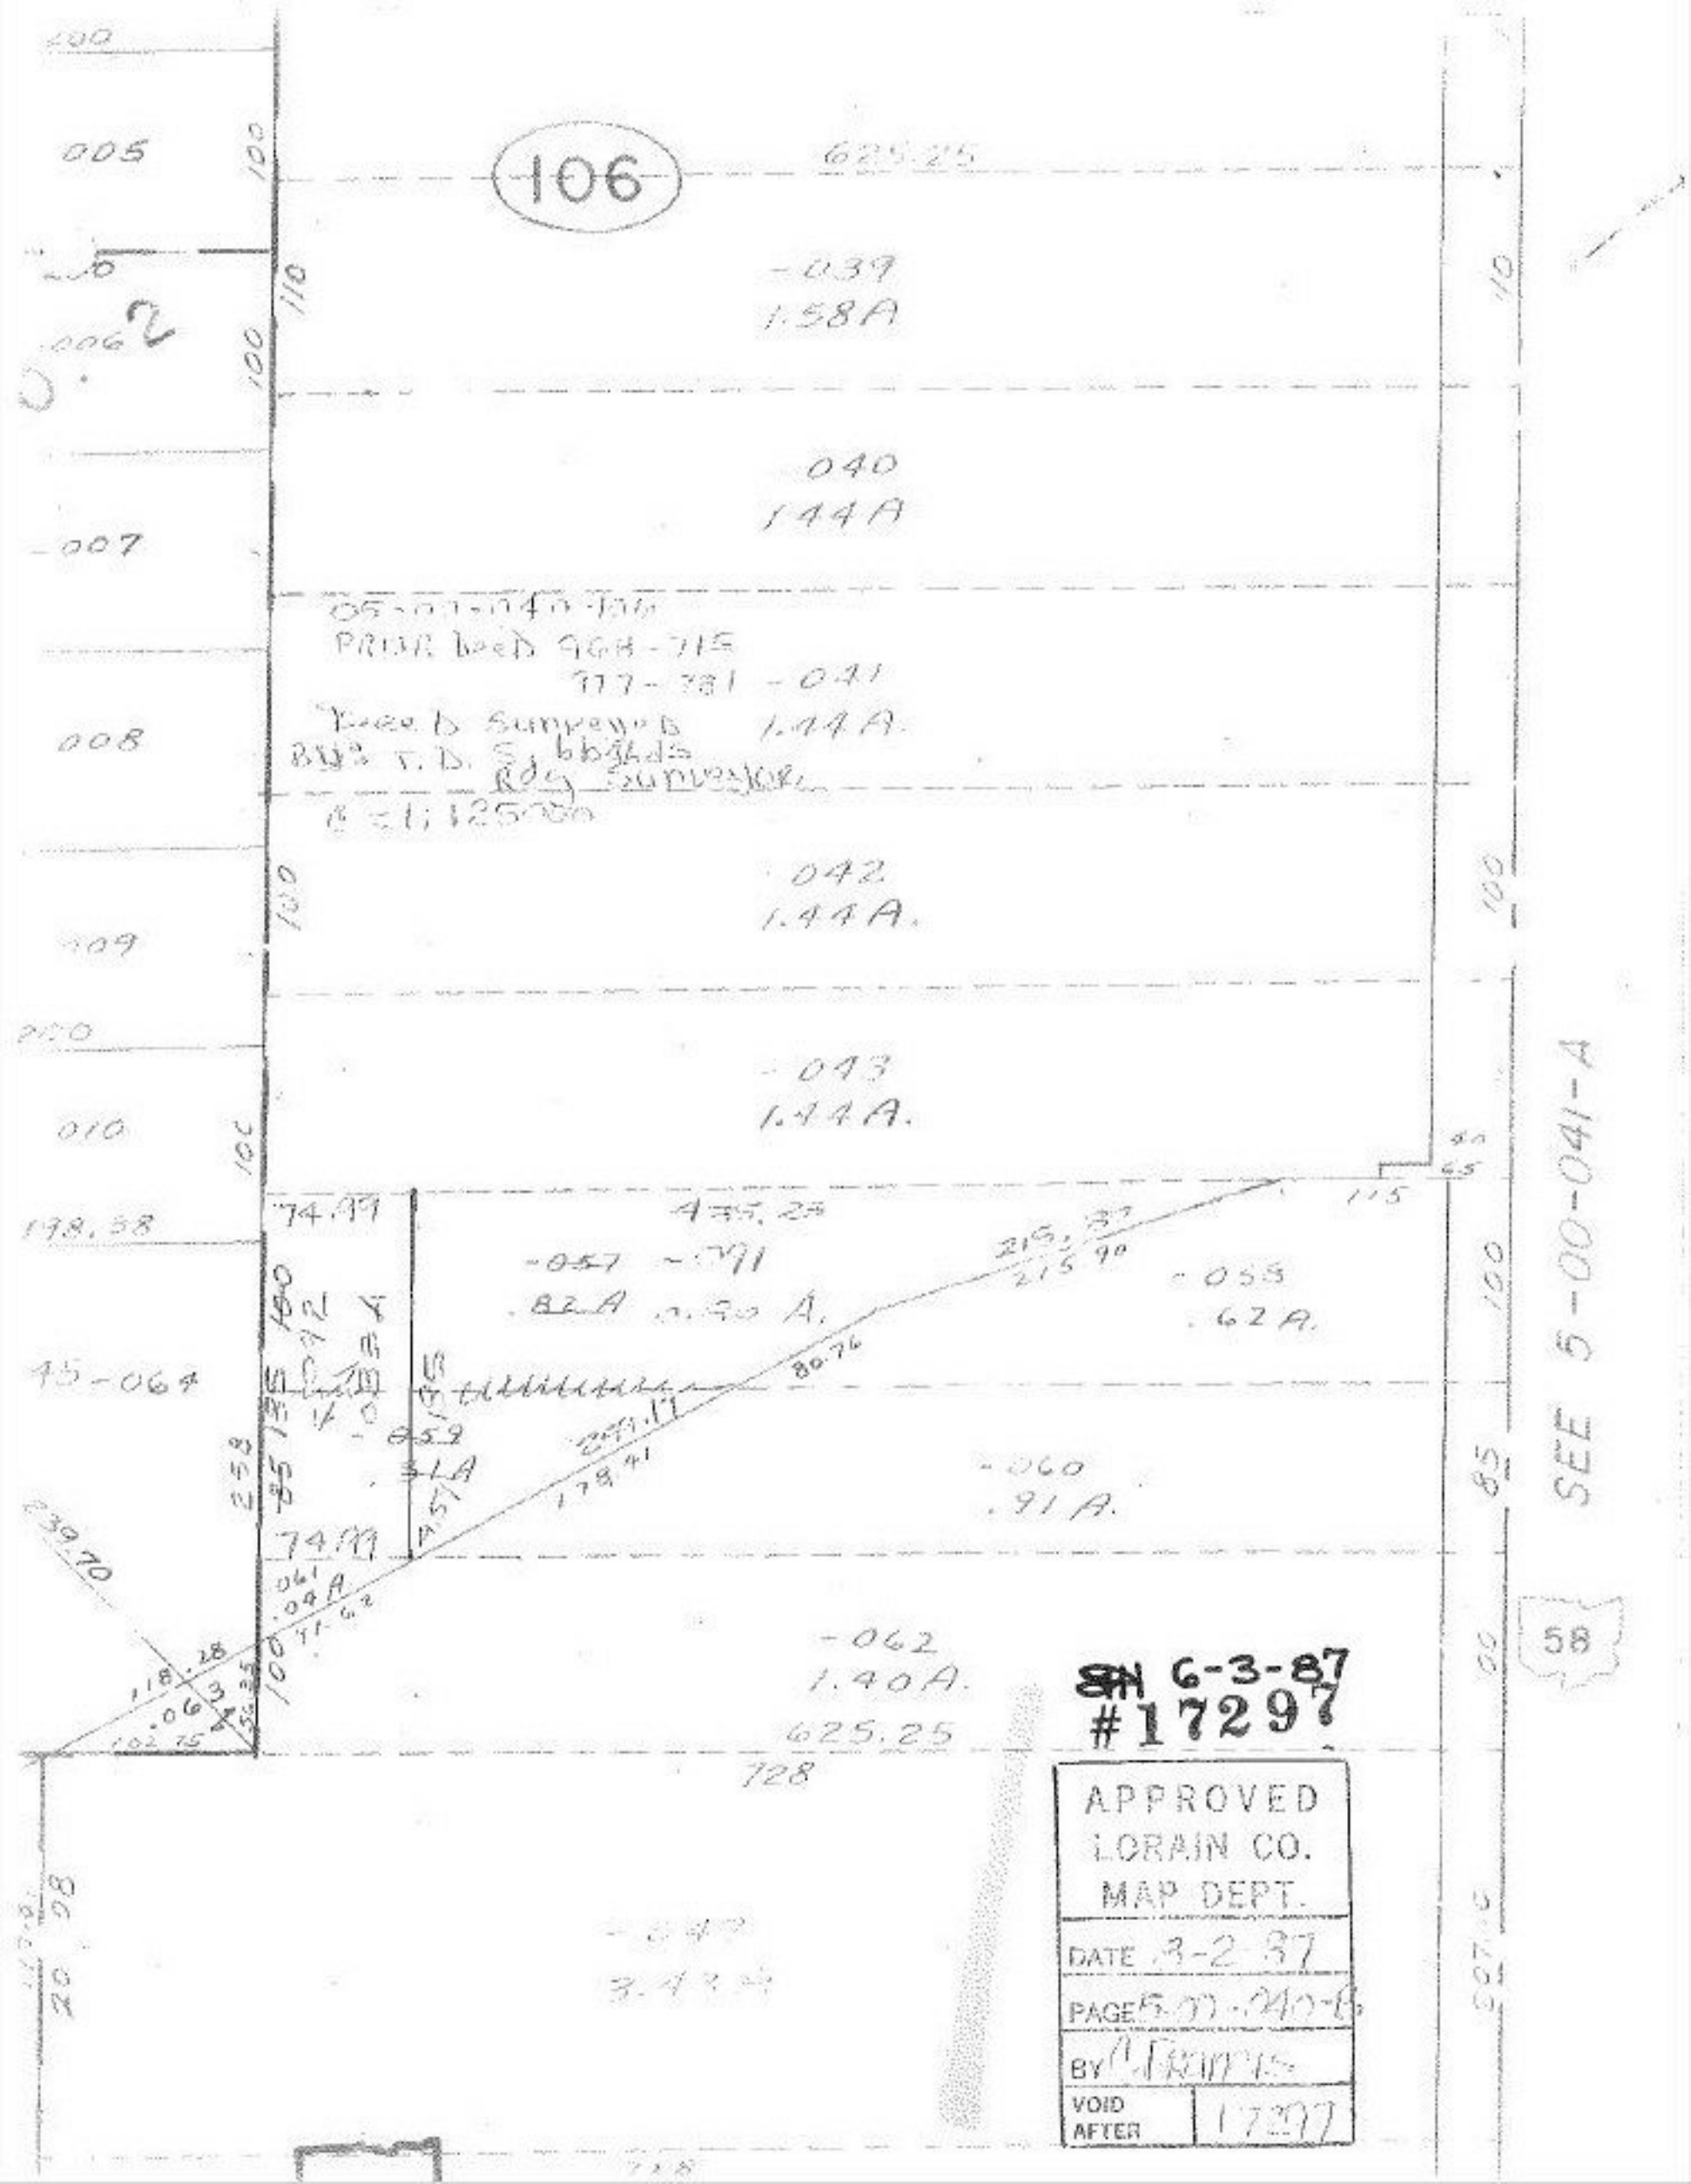
106
625.25
-039
1.58A
040
1.44A
05-00-040-106
PRIOR DEED 968-715
977-781
-041
1.44A.
Deed Surveyed
BY: T.D. S. Bbgads
Rdg Surveyor
042
1.44A.
-043
1.44A.
74.99
-057
.82A
-058
.62A.
-059
.31A
-060
.91A.
-062
1.40A.
625.25
728
SEE 5-00-041-A
58
SH 6-3-87
#17297
APPROVED
LORAIN CO.
MAP DEPT.
DATE 3-2-87
PAGE 5-00-040-B
BY
VOID AFTER 17297