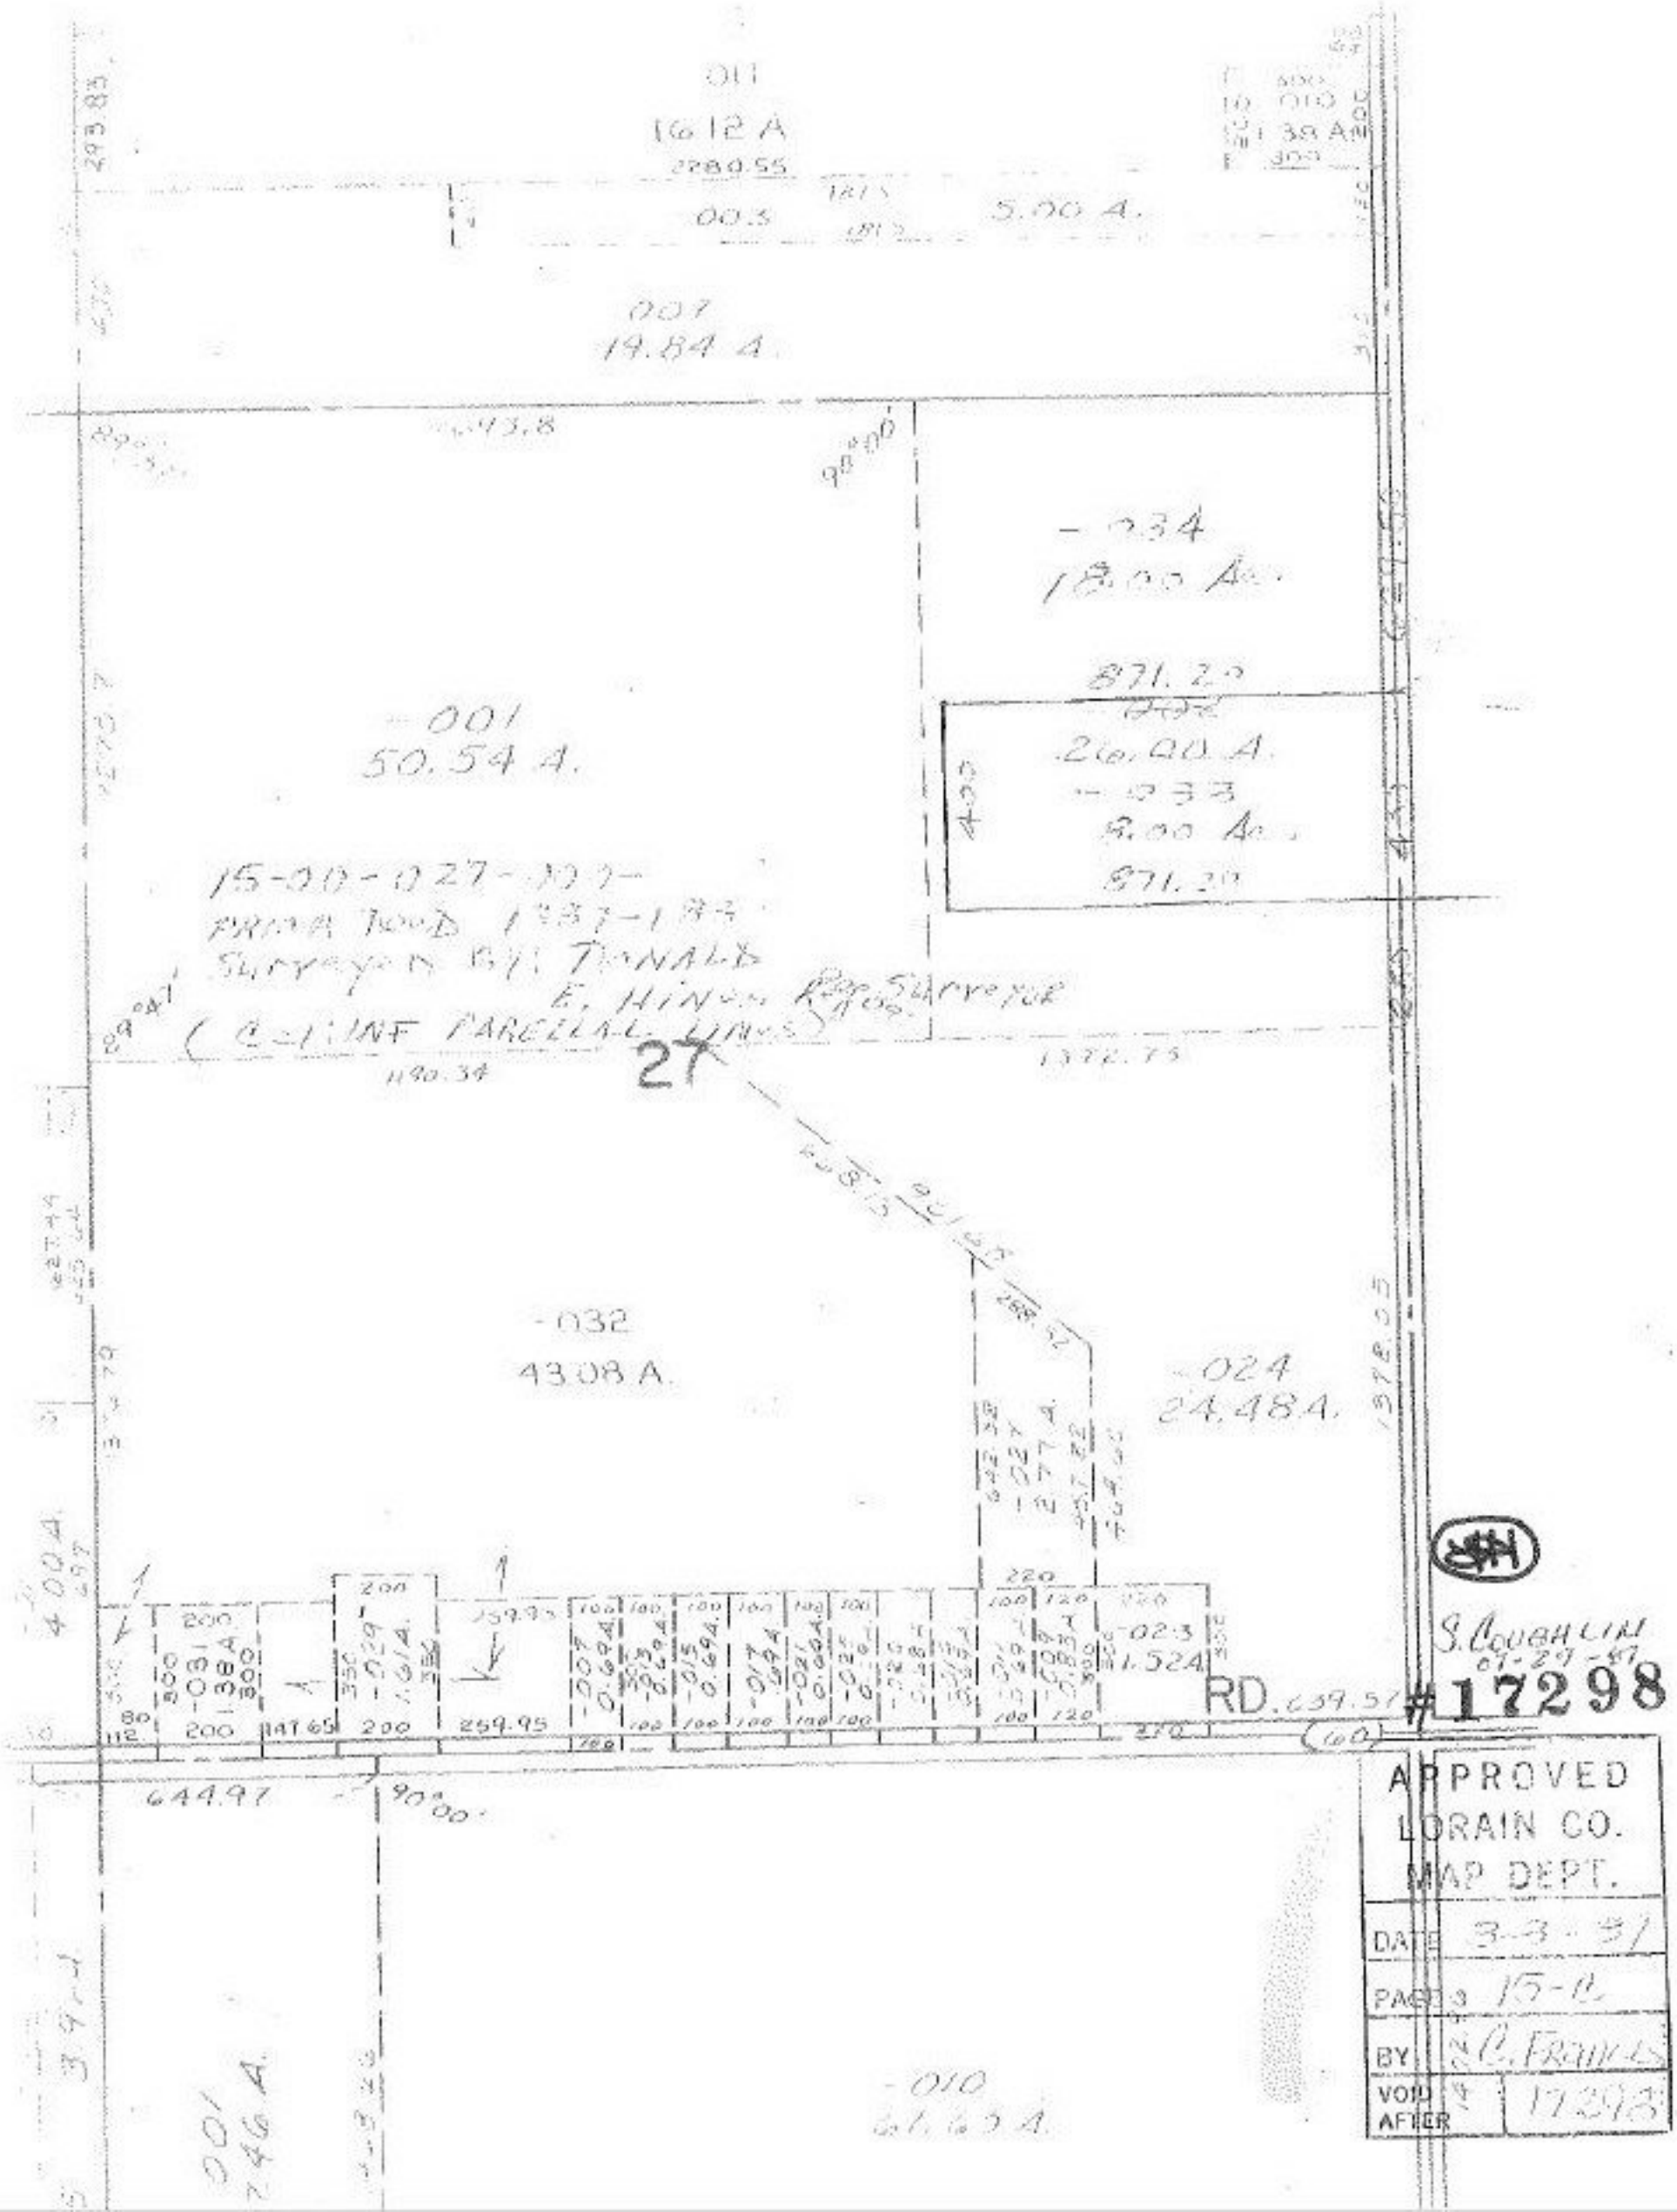

011
16.12 A
2280.55
003
5.00 A.
007
19.84 A.
-034
18.00 Ac.
871.20
-001
50.54 A.
26.00 A.
-033
8.00 Ac.
871.20
15-00-027-007-
PRIOR DOCD 1387-183
Surveyed By: DONALD
E. HINON Reg. Surveyor
(C-1 INF PARCELAL LINES)
27
-032
43.08 A.
-024
24.48 A.
-023
1.52 A.
RD. 639.57
644.97
-010
61.63 A.
S. COUGHLIN
07-29-87
#17298
APPROVED
LORAIN CO.
MAP DEPT.
DATE 3-3-87
PAGE 15-C
BY C. FRANCIS
VOID AFTER 17298