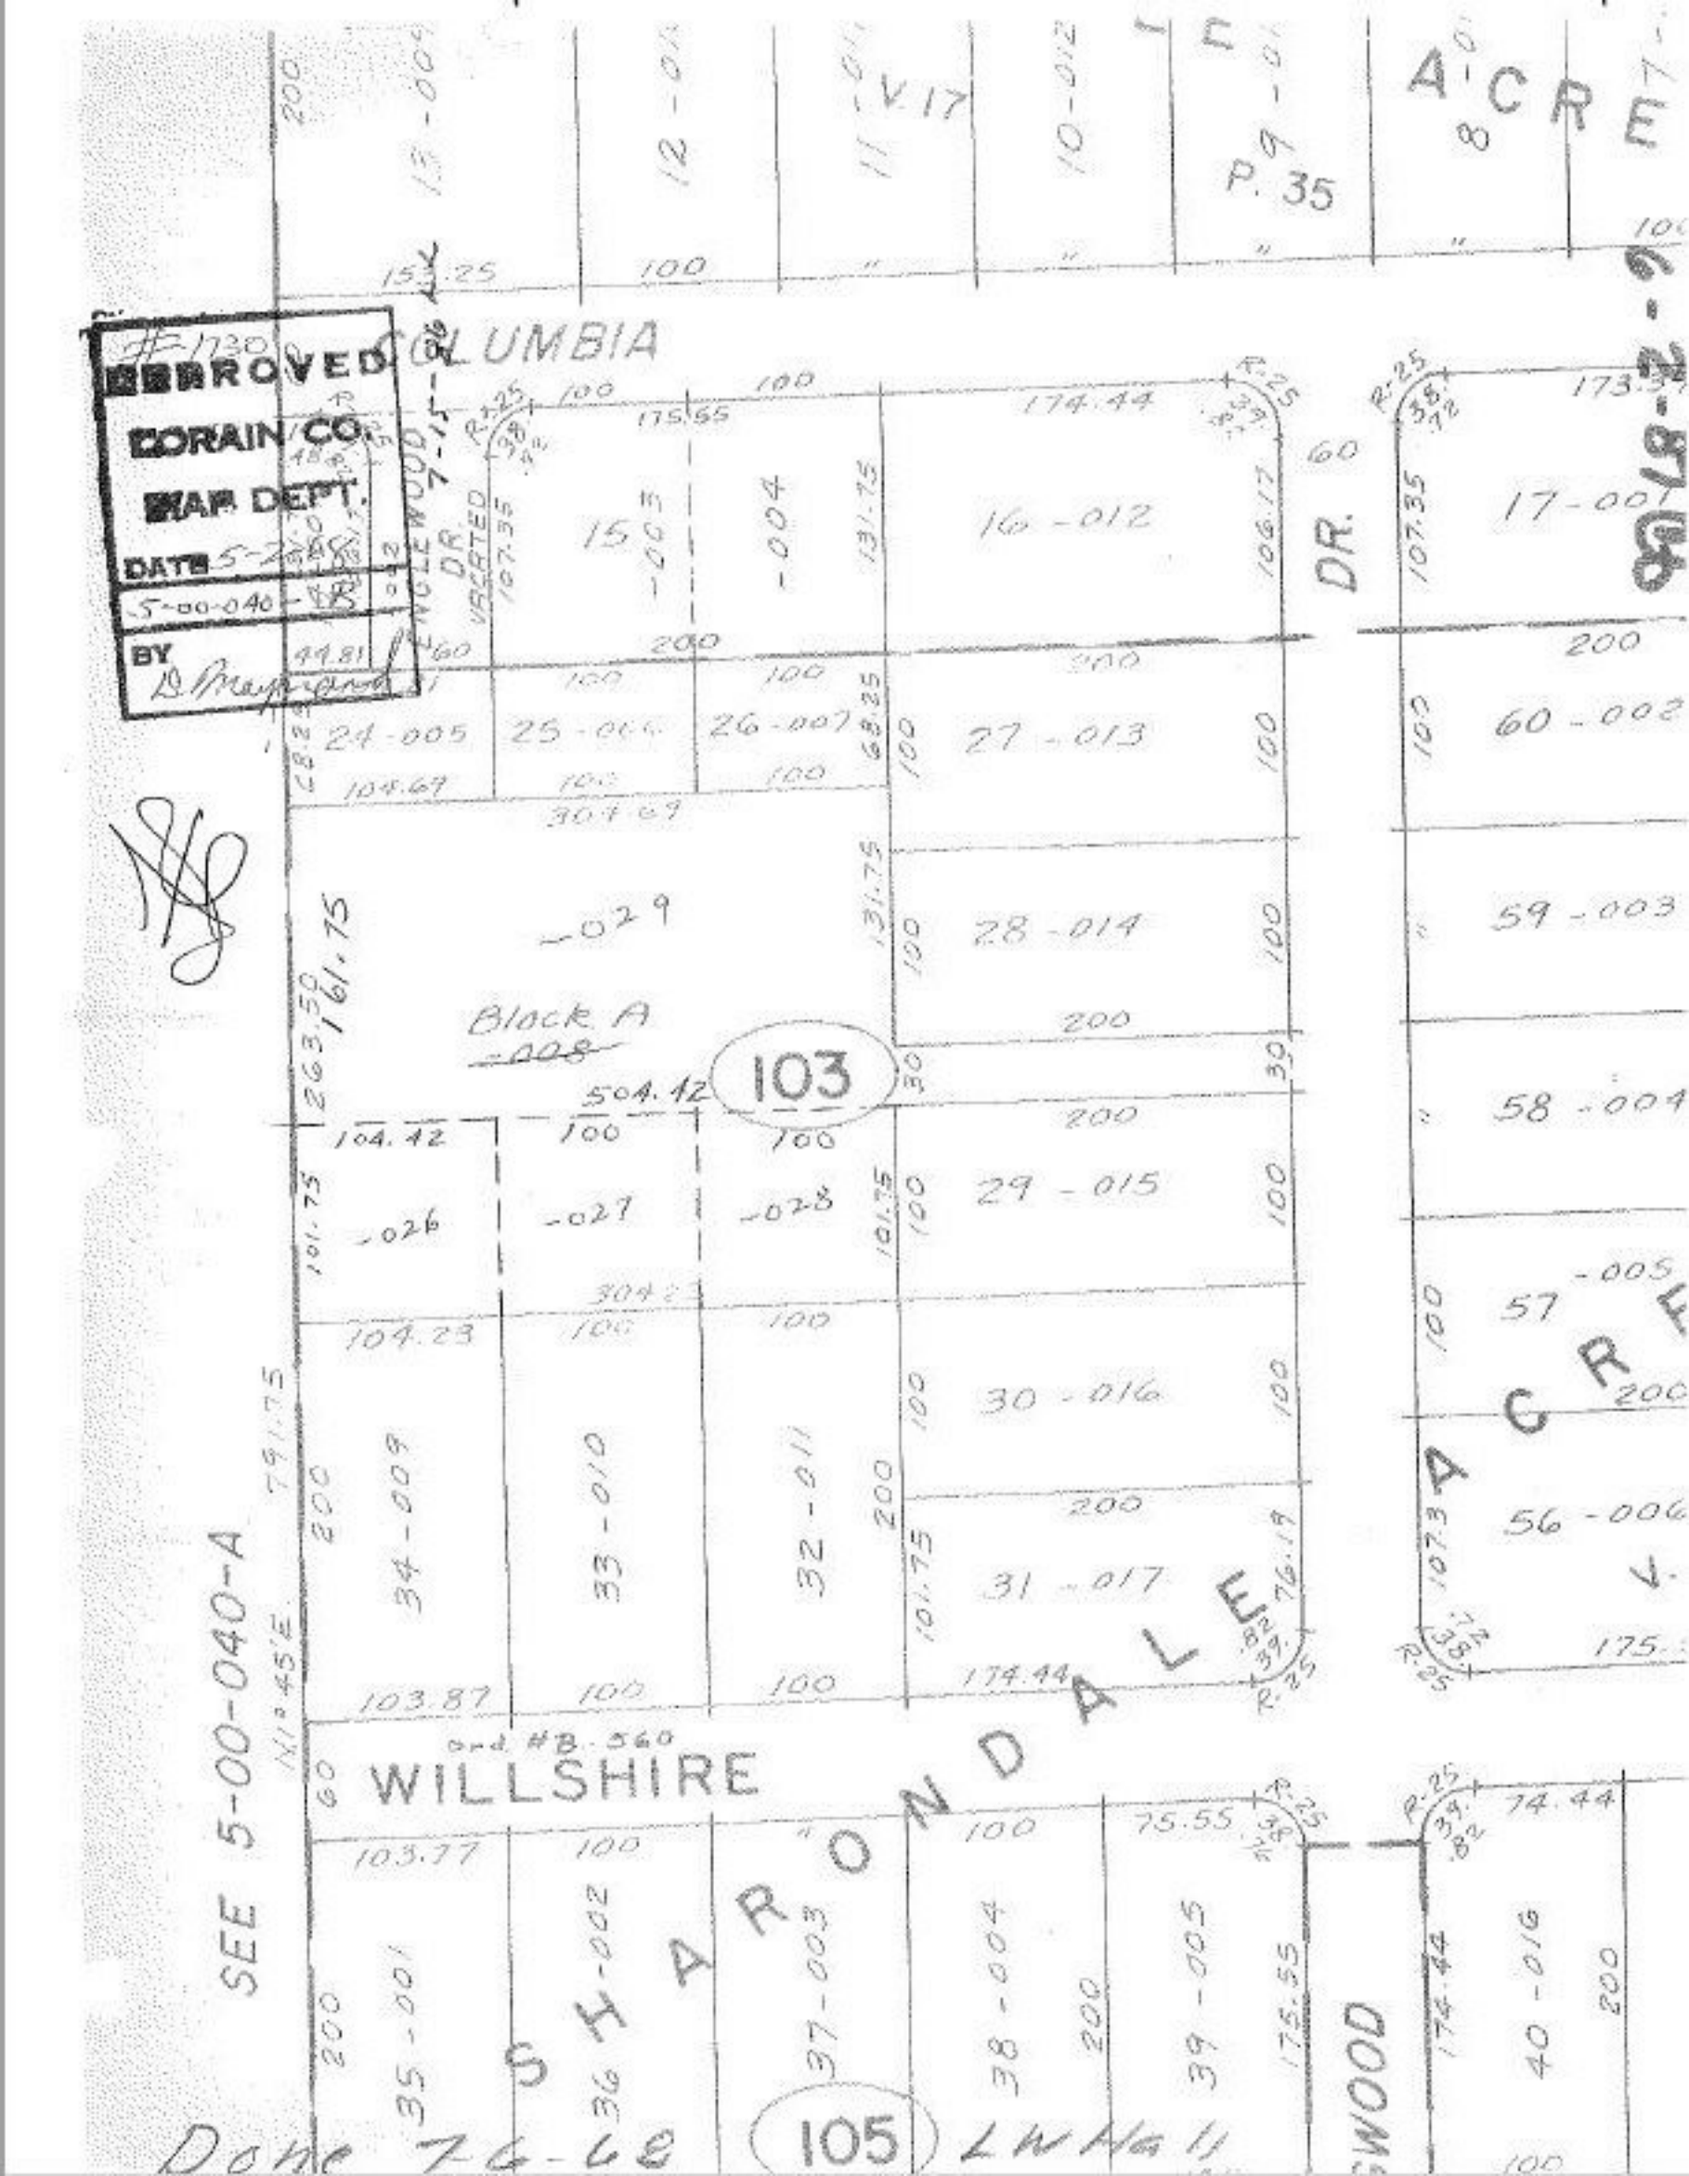
APPROVED
CORAIN CO.
MAP DEPT.
DATE 5-2
5-00-040-
BY
COLUMBIA
ENGLEWOOD DR. VACATED 7-15-
DR.
ACRE
Block A
-008
103
WILLSHIRE
Ord. #B-560
SHARONDALE
SEE 5-00-040-A
Done 7-6-6
105
15-003
-004
16-012
17-001
24-005
25-006
26-007
27-013
-029
28-014
59-003
58-004
-026
-027
-028
29-015
57-005
30-016
56-006
34-009
33-010
32-011
31-017
35-001
36-002
37-003
38-004
39-005
40-016
263.50
161.75
504.12
304.69
304.23
103.87
174.44
175.55
104.67
104.42
104.23
103.77
101.75
131.75
107.35
106.17
76.19
79.75
N1°45'E.