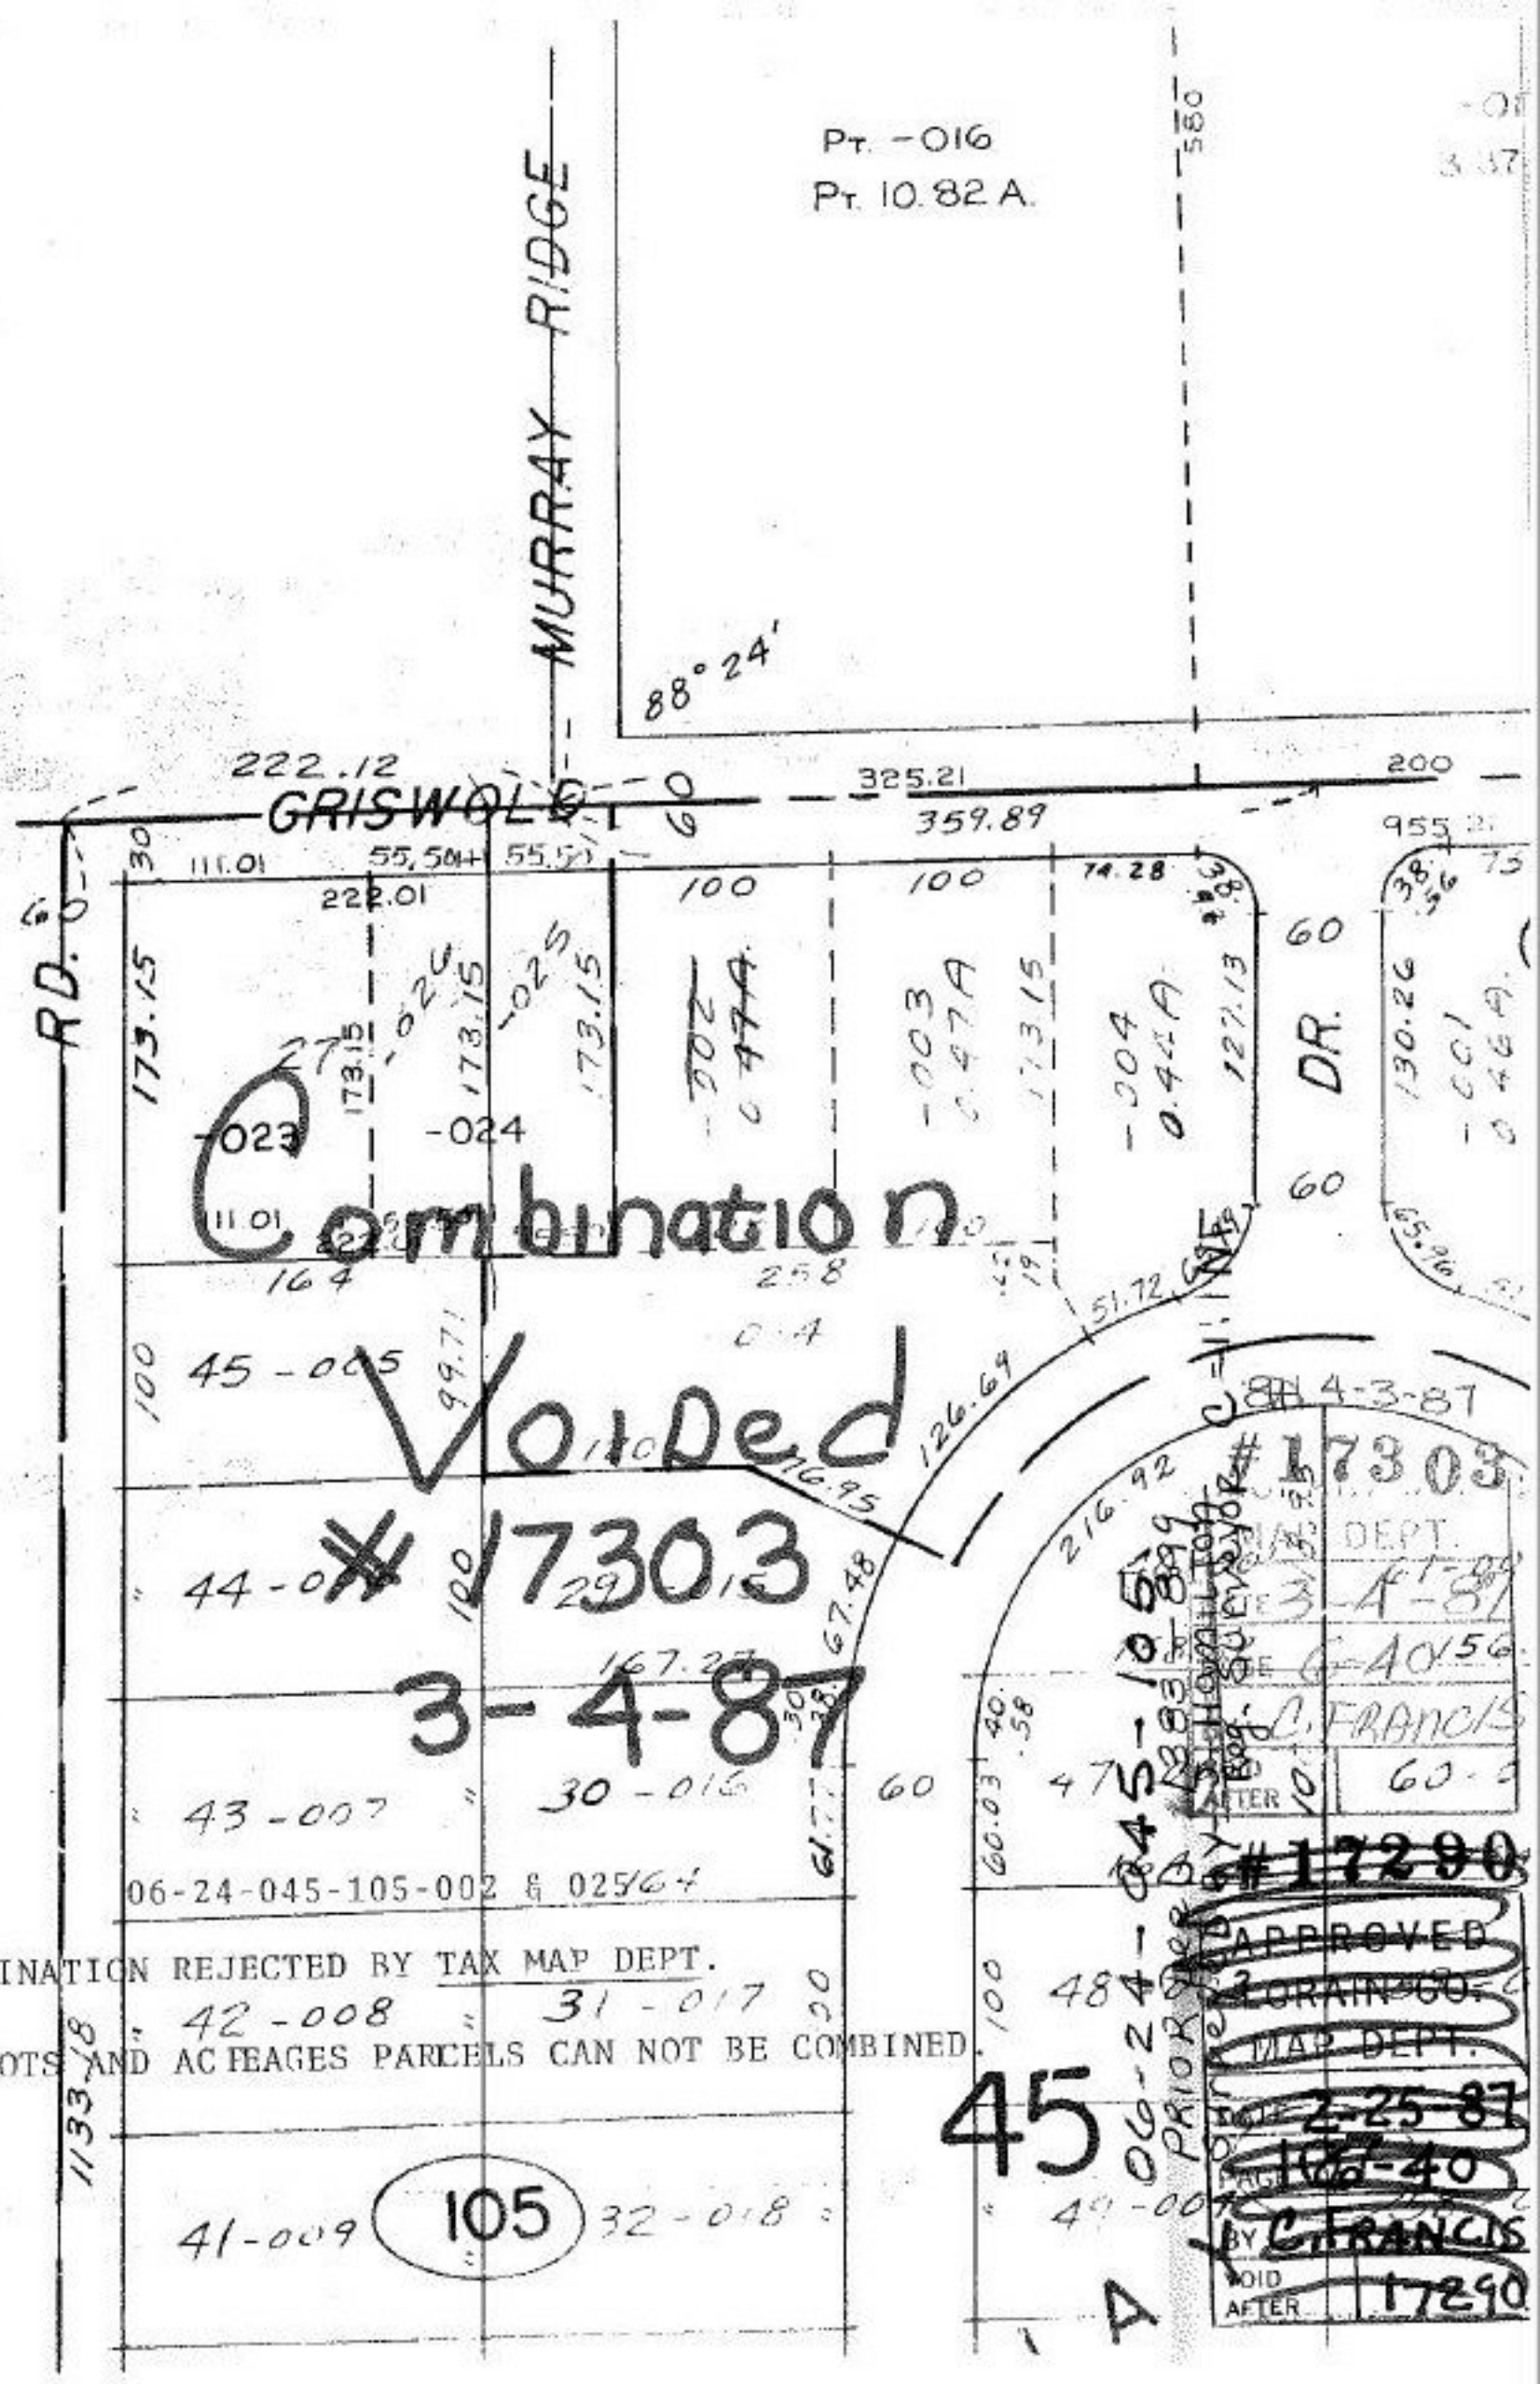

Pt. -016
Pt. 10.82 A.
MURRAY RIDGE
GRISWOLD
RD.
DR.
88° 24'
222.12
325.21
359.89
200
100
60
173.15
-023
-024
-025
-026
-002
-003
-004
-001
45-005
44-0
43-007
30-016
42-008
31-017
41-009
32-018
105
45
Combination
Voided
#17303
3-4-87
06-24-045-105-002 & 025
COMBINATION REJECTED BY TAX MAP DEPT.
SUBLOTS AND ACREAGES PARCELS CAN NOT BE COMBINED.
#17303
MAP DEPT.
3-4-87
6-40
C. FRANCIS
#17290
APPROVED
LORAIN CO.
MAP DEPT.
2-25-87
106-40
C. FRANCIS
17290