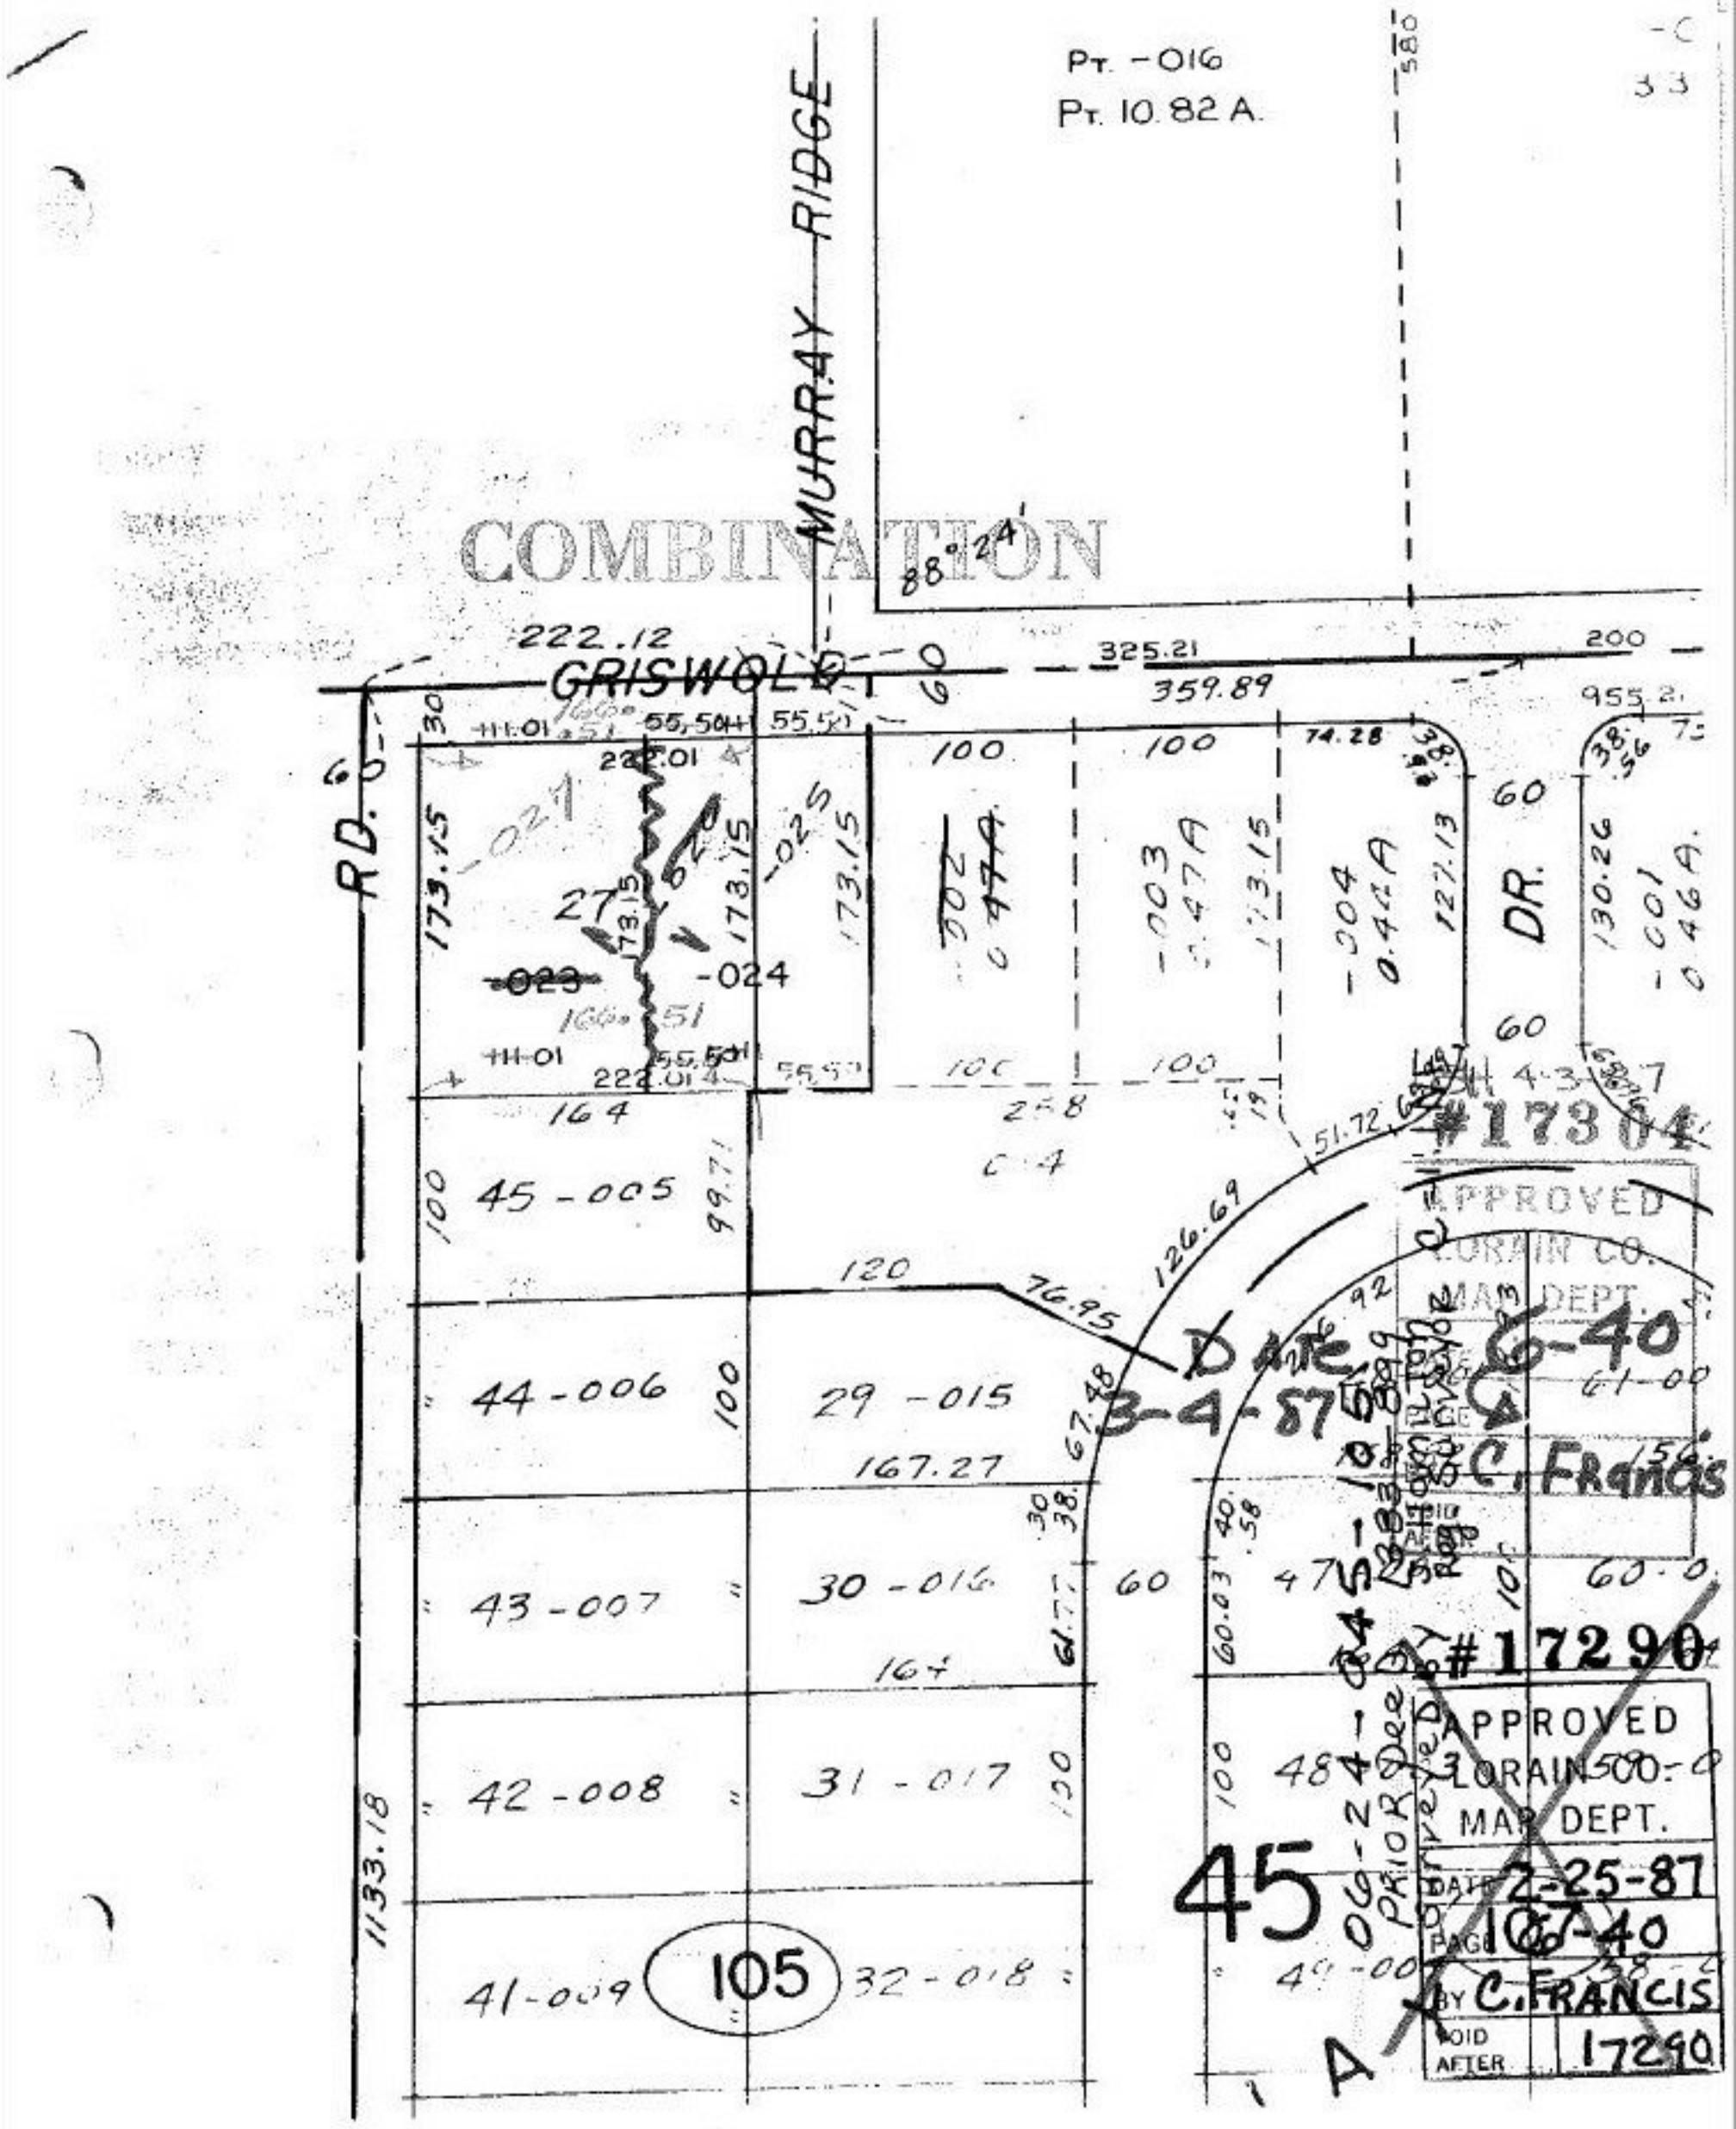

Pt. -016
Pt. 10.82 A.
MURRAY RIDGE
COMBINATION
GRISWOLD
RD.
DR.
222.12
325.21
359.89
200
88°24'
100
74.28
173.15
-024
-025
-027
-003
-004
-001
130.26
127.13
164
45-005
44-006
29-015
167.27
43-007
30-016
42-008
31-017
41-009
32-018
105
126.69
76.95
51.72
67.48
61.77
60.03
1133.18
#17304
APPROVED
LORAIN CO.
MAP DEPT.
DATE 6-40
3-4-87
C. Francis
#17290
APPROVED
LORAIN CO.
MAP DEPT.
DATE 2-25-87
PAGE 107-40
BY C. FRANCIS
VOID AFTER 17290
45
A