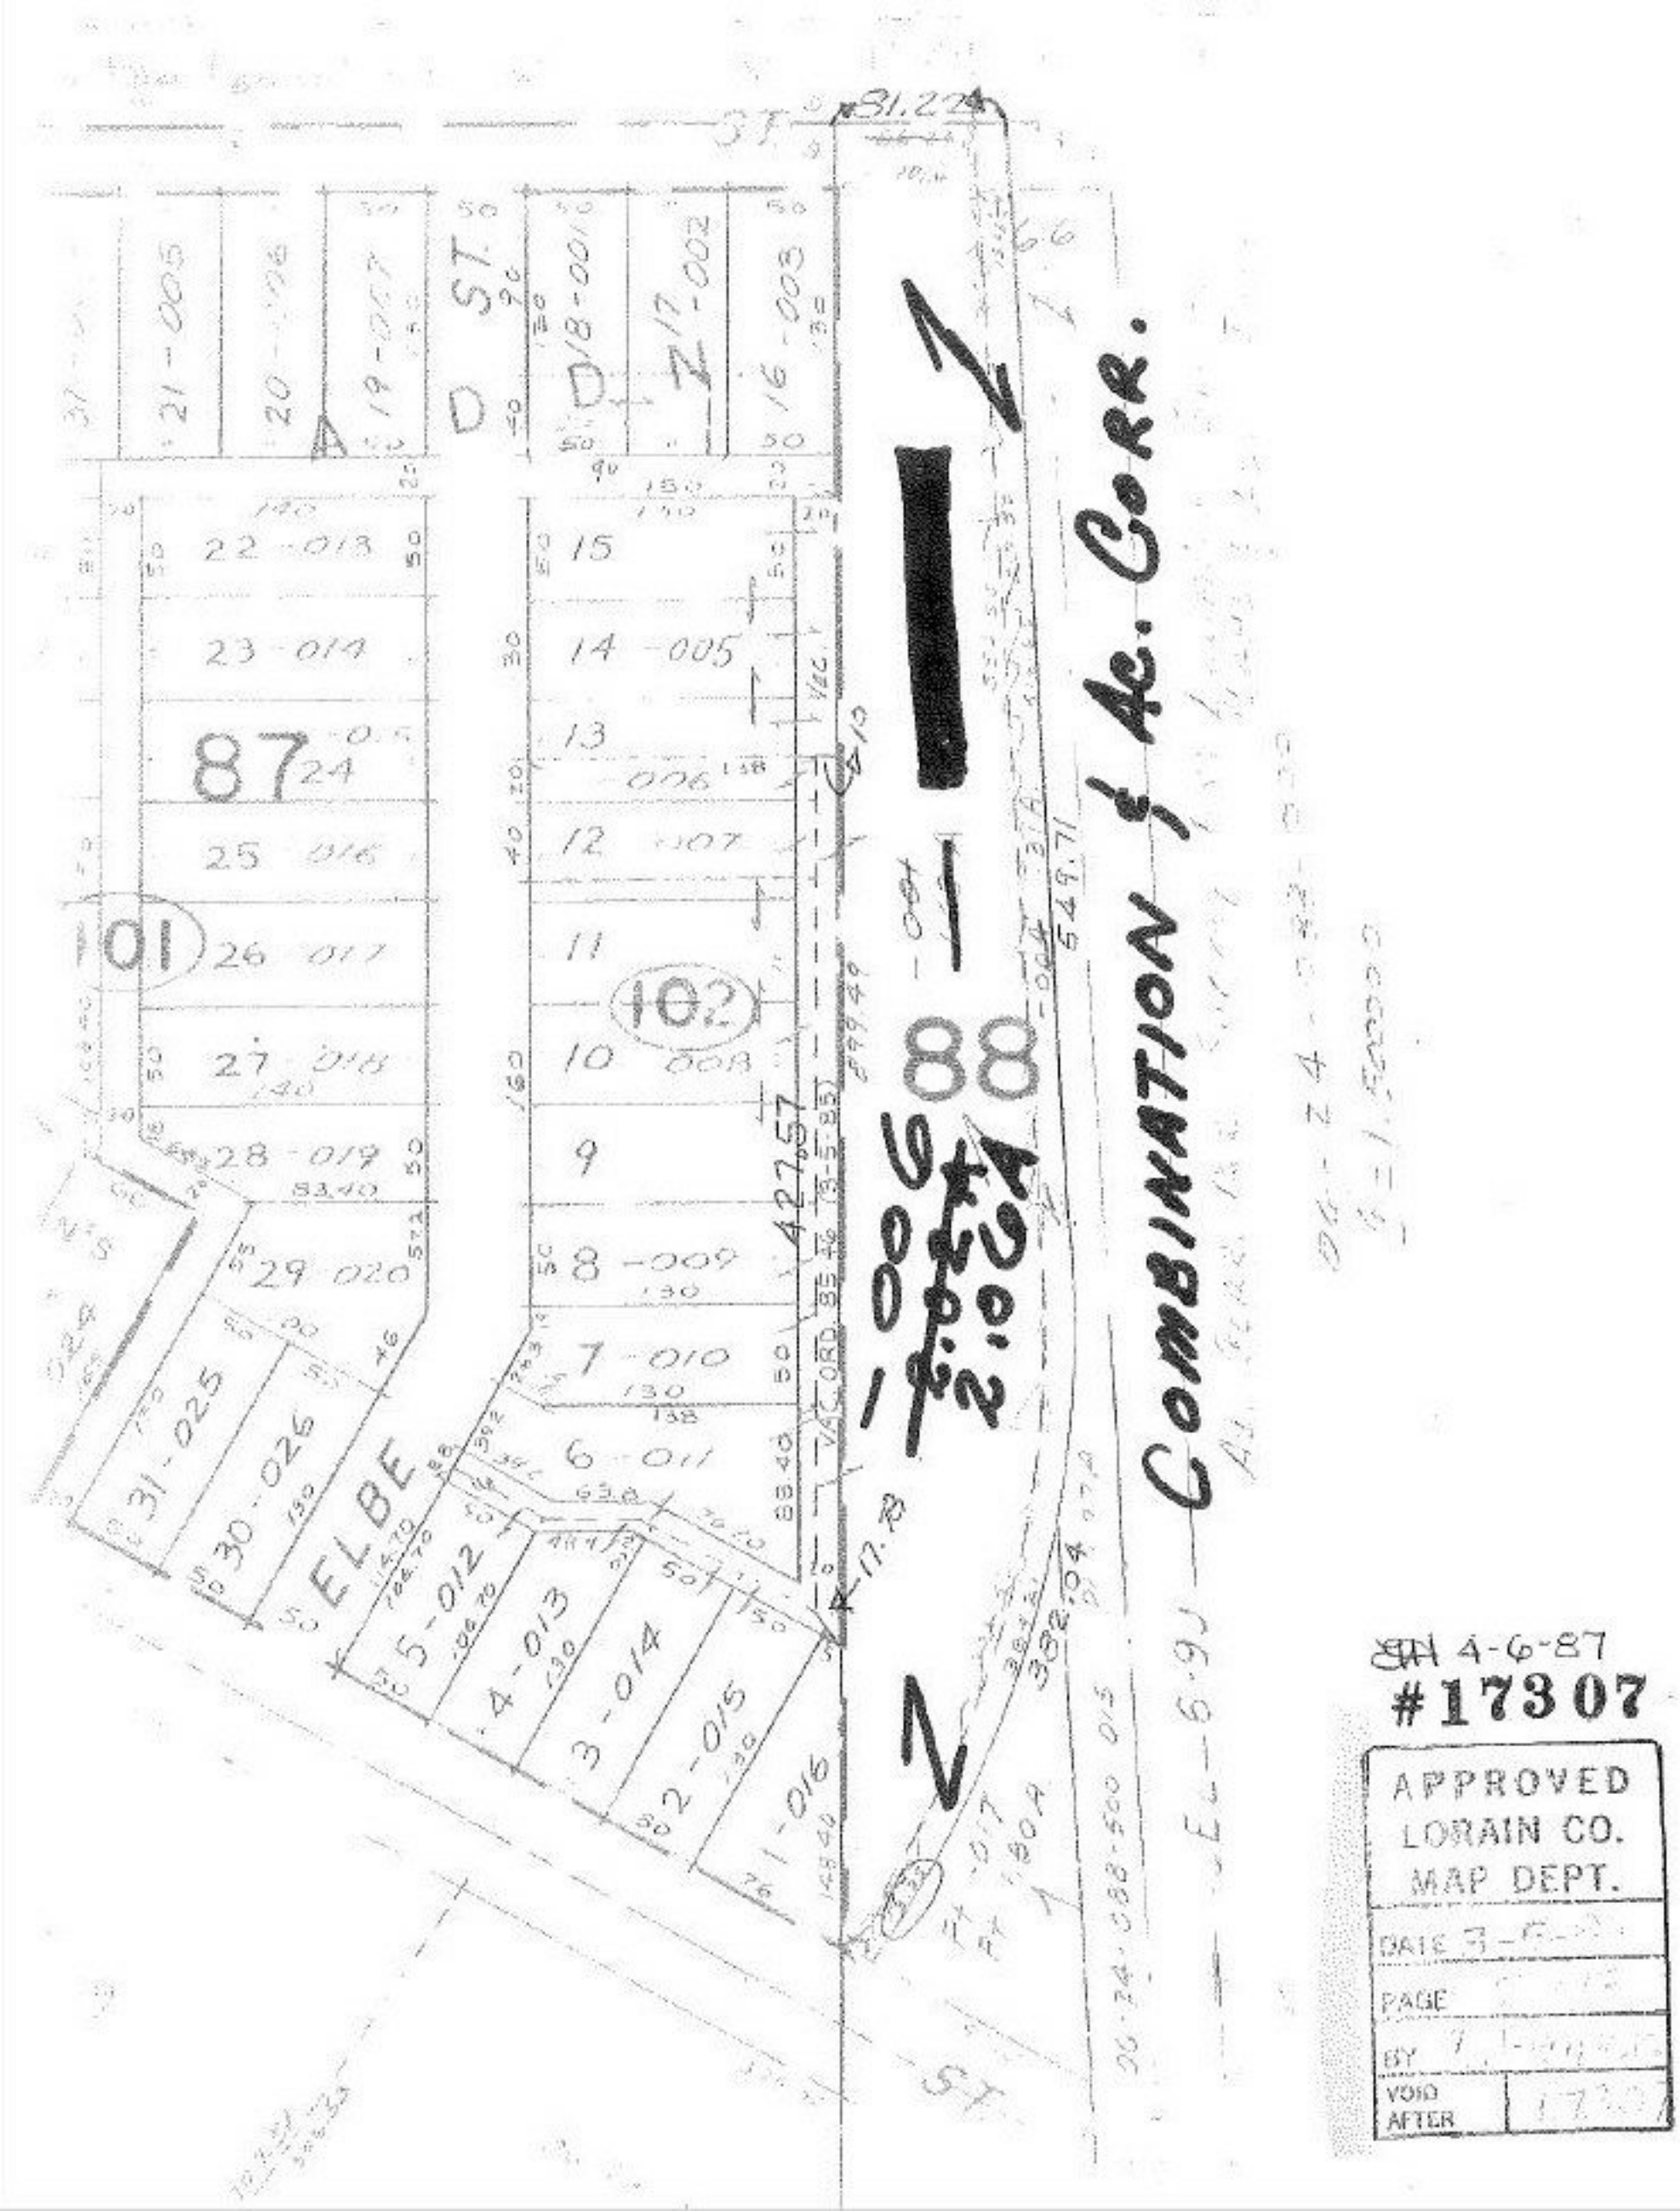

4-6-87

#17307

APPROVED
LORAIN CO.
MAP DEPT.

DATE 3-6-87

PAGE

BY

VOID AFTER