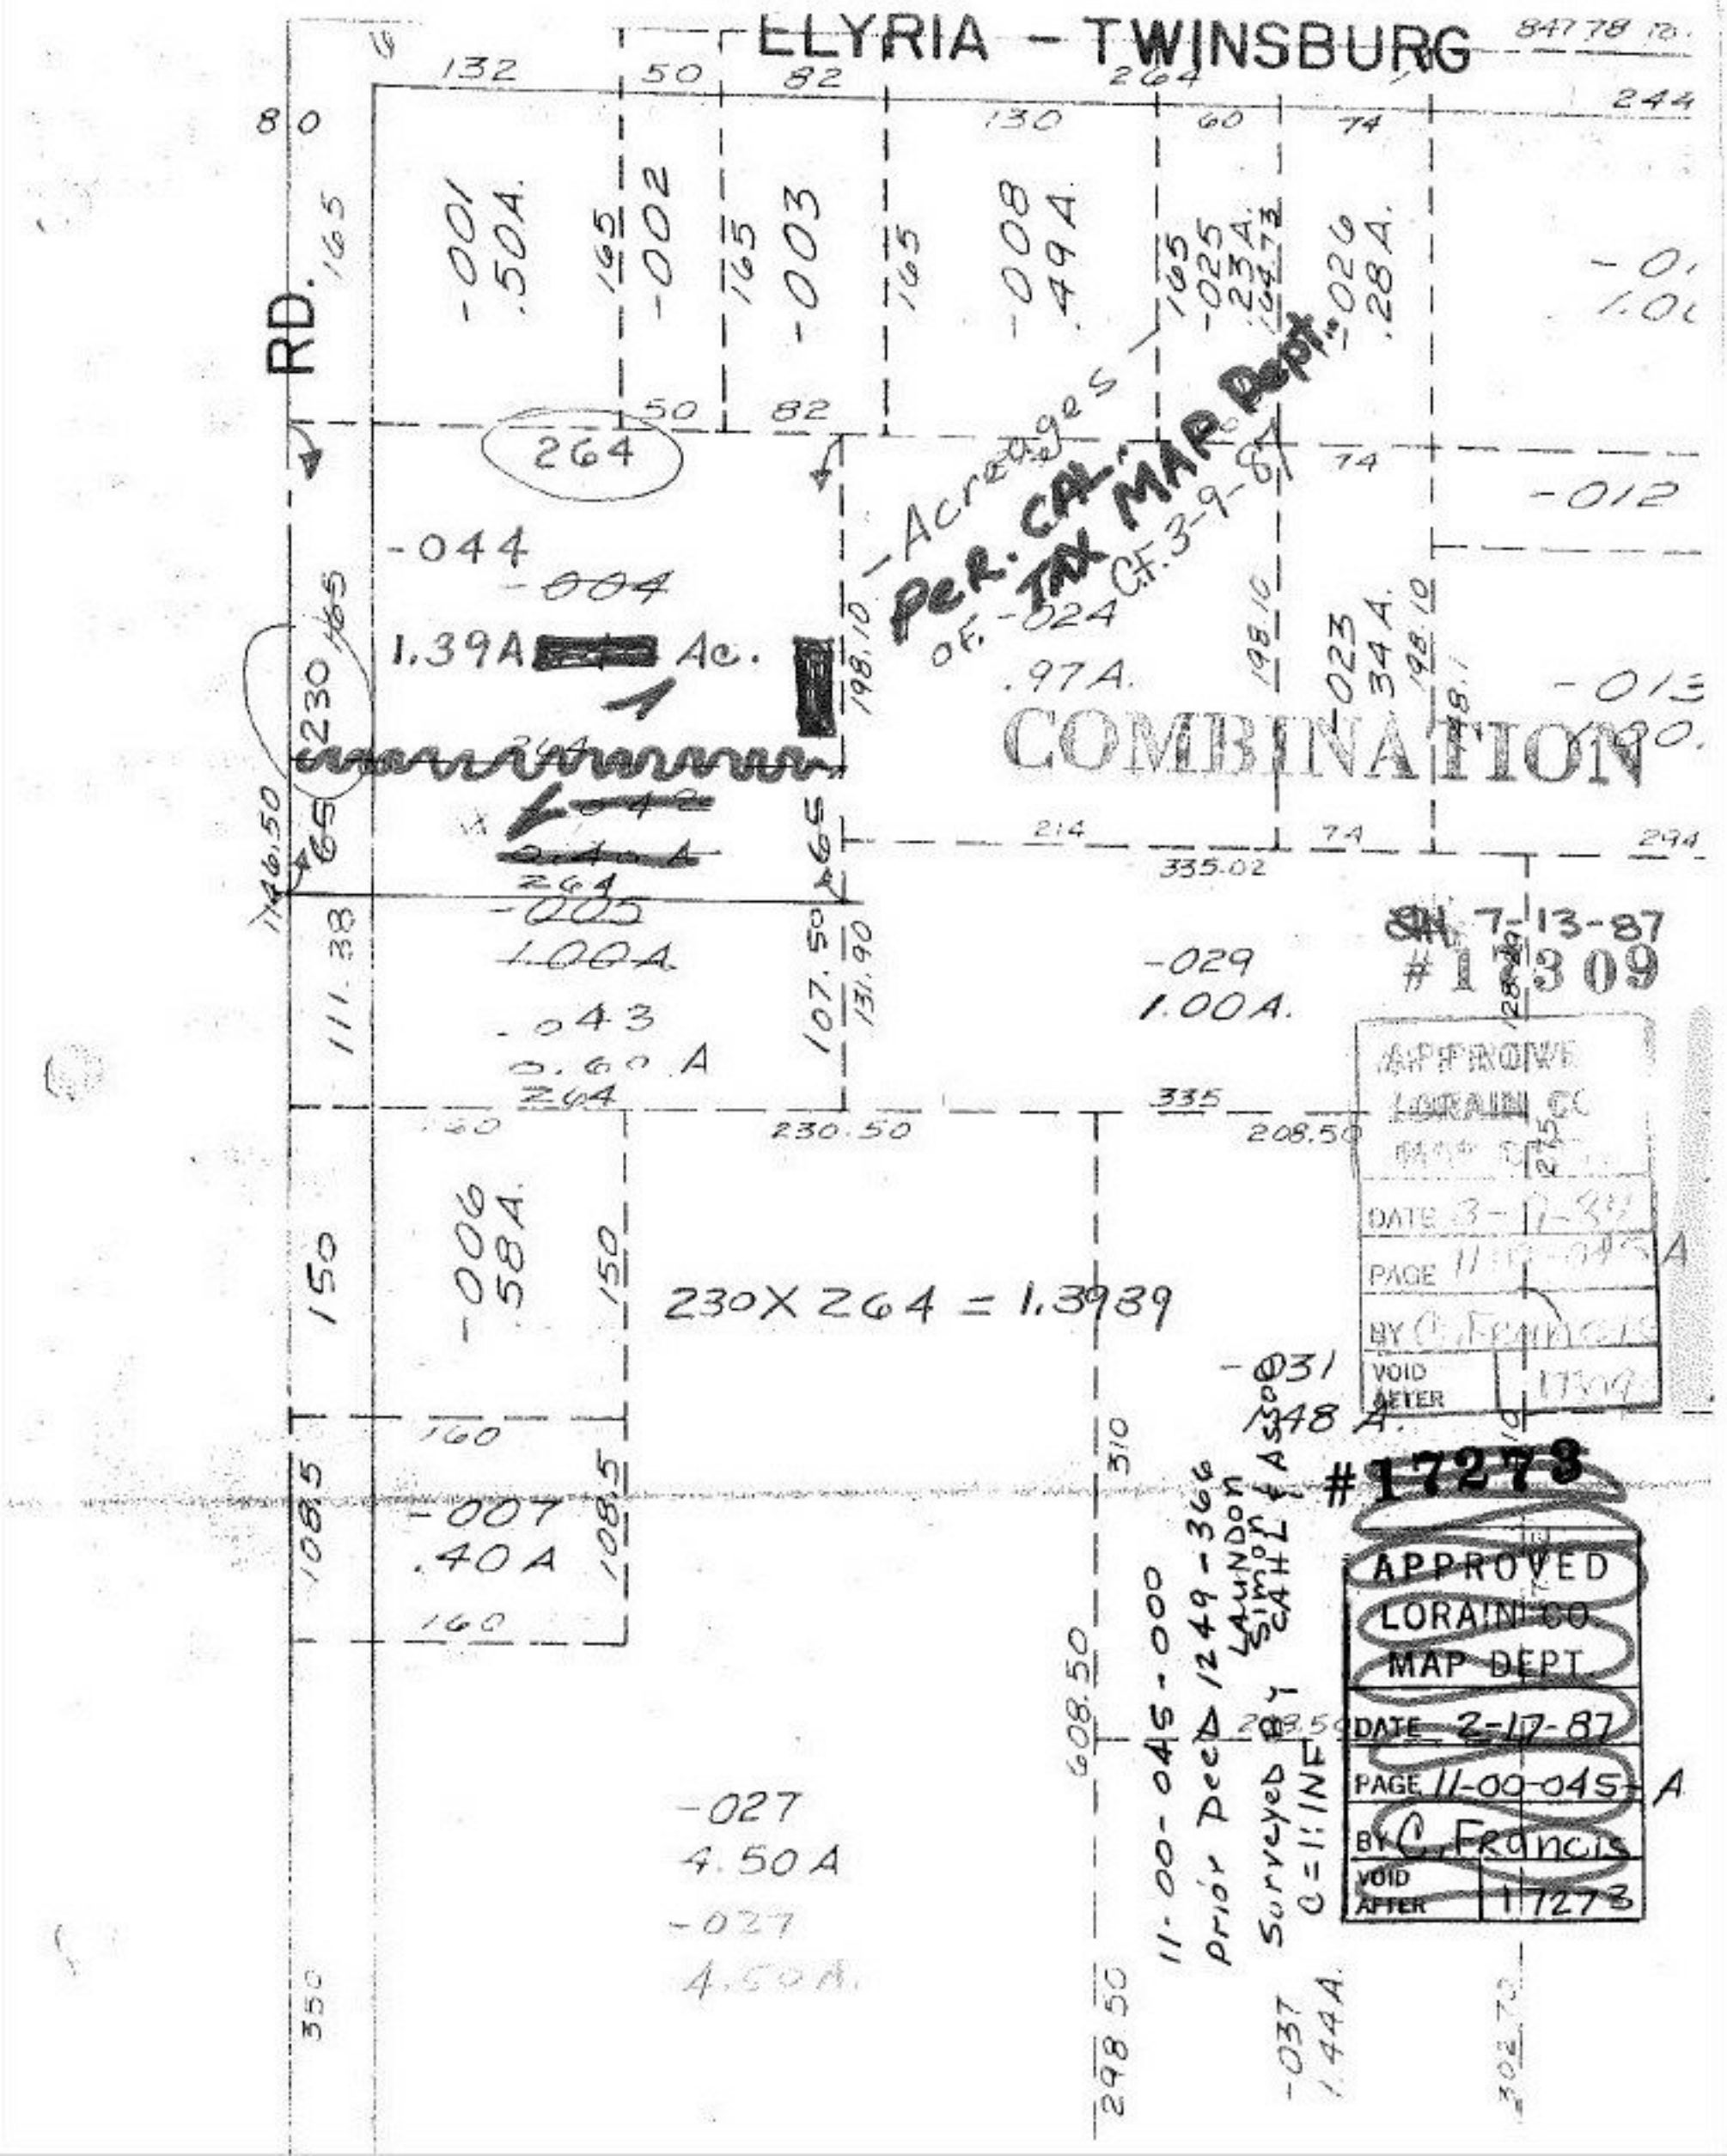
ELYRIA - TWINSBURG
RD.
-001 .50A.
-002
-003
-008 .49A.
-025 .23A.
-026 .28A.
-012
-044
-004
1.39A Ac.
-024 .97A.
-023 .34A.
-013
COMBINATION
-005 1.00A
-043 0.60 A
-029 1.00A.
-006 .58A.
230X264 = 1.3939
-031 1.48 A.
-007 .40A
-027 4.50A
-027 4.50A.
-037 1.44A.
-Acreages
Per. Cal. of TAX MAP Dept. C.F. 3-9-87
11-00-045-000
Prior Deed 1249-366
Laundon Simon & Assoc
Surveyed by CAHL
C=1:INF
#17309
APPROVED LORAIN CO MAP DEPT
DATE 3-17-87
PAGE 11-00-045-A
BY C. Francis
VOID AFTER 17309
#17273
APPROVED LORAIN CO MAP DEPT
DATE 2-17-87
PAGE 11-00-045-A
BY C. Francis
VOID AFTER 17273