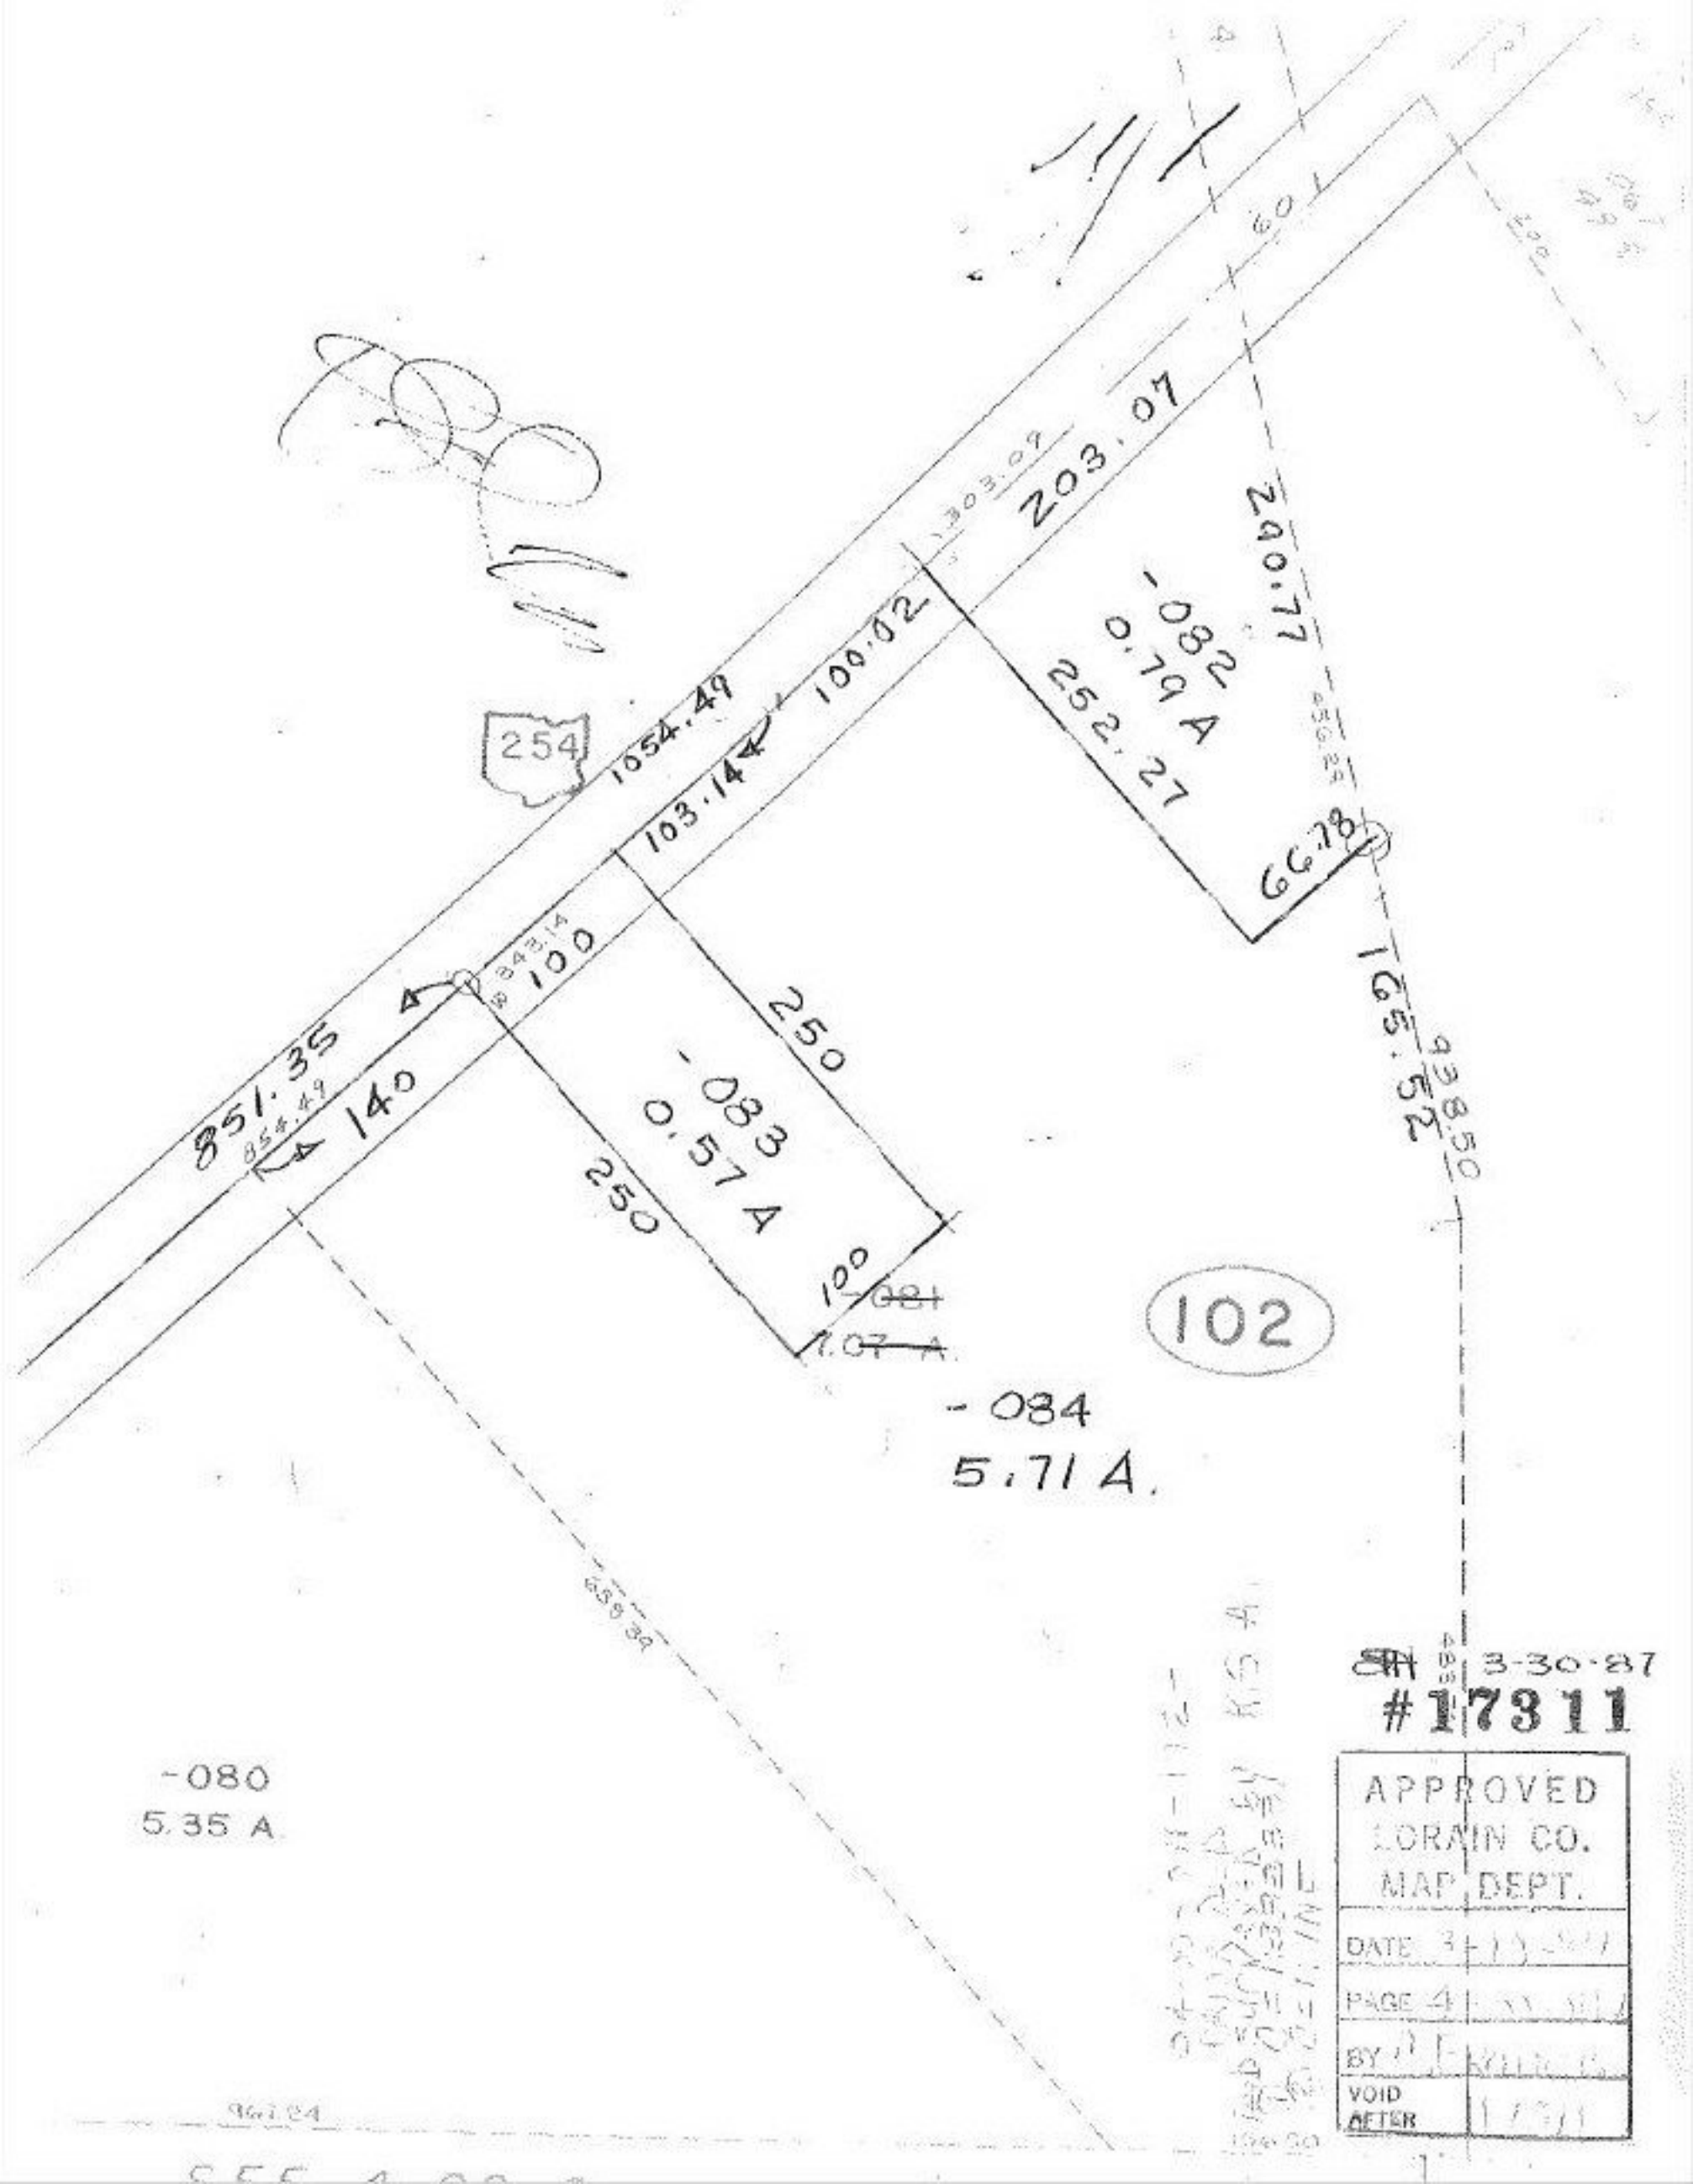

203.07
303.09
100.02
1054.49
103.14
254
240.77
-082
0.79 A
252.27
66.78
165.52
938.50
851.35
854.49
140
843.14
100
250
-083
0.57 A
250
100
~~-081~~
~~7.07 A~~
102
-084
5.71 A.
-080
5.35 A
3-30-87
#17311
APPROVED
LORAIN CO.
MAP DEPT.
DATE
PAGE
BY
VOID
AFTER