0400-011-102

PRIOR DEED

Deed Surveyed By: K.S.A

① C=1
② C=1: INF.
③ C=1: INF
④ C=1: INF

#17312

3-30-87

APPROVED
DRAIN CO.
MAP DEPT.

DATE 3-10-87
PAGE 4-00-011-A
BY C. Francis
VOID AFTER 17312

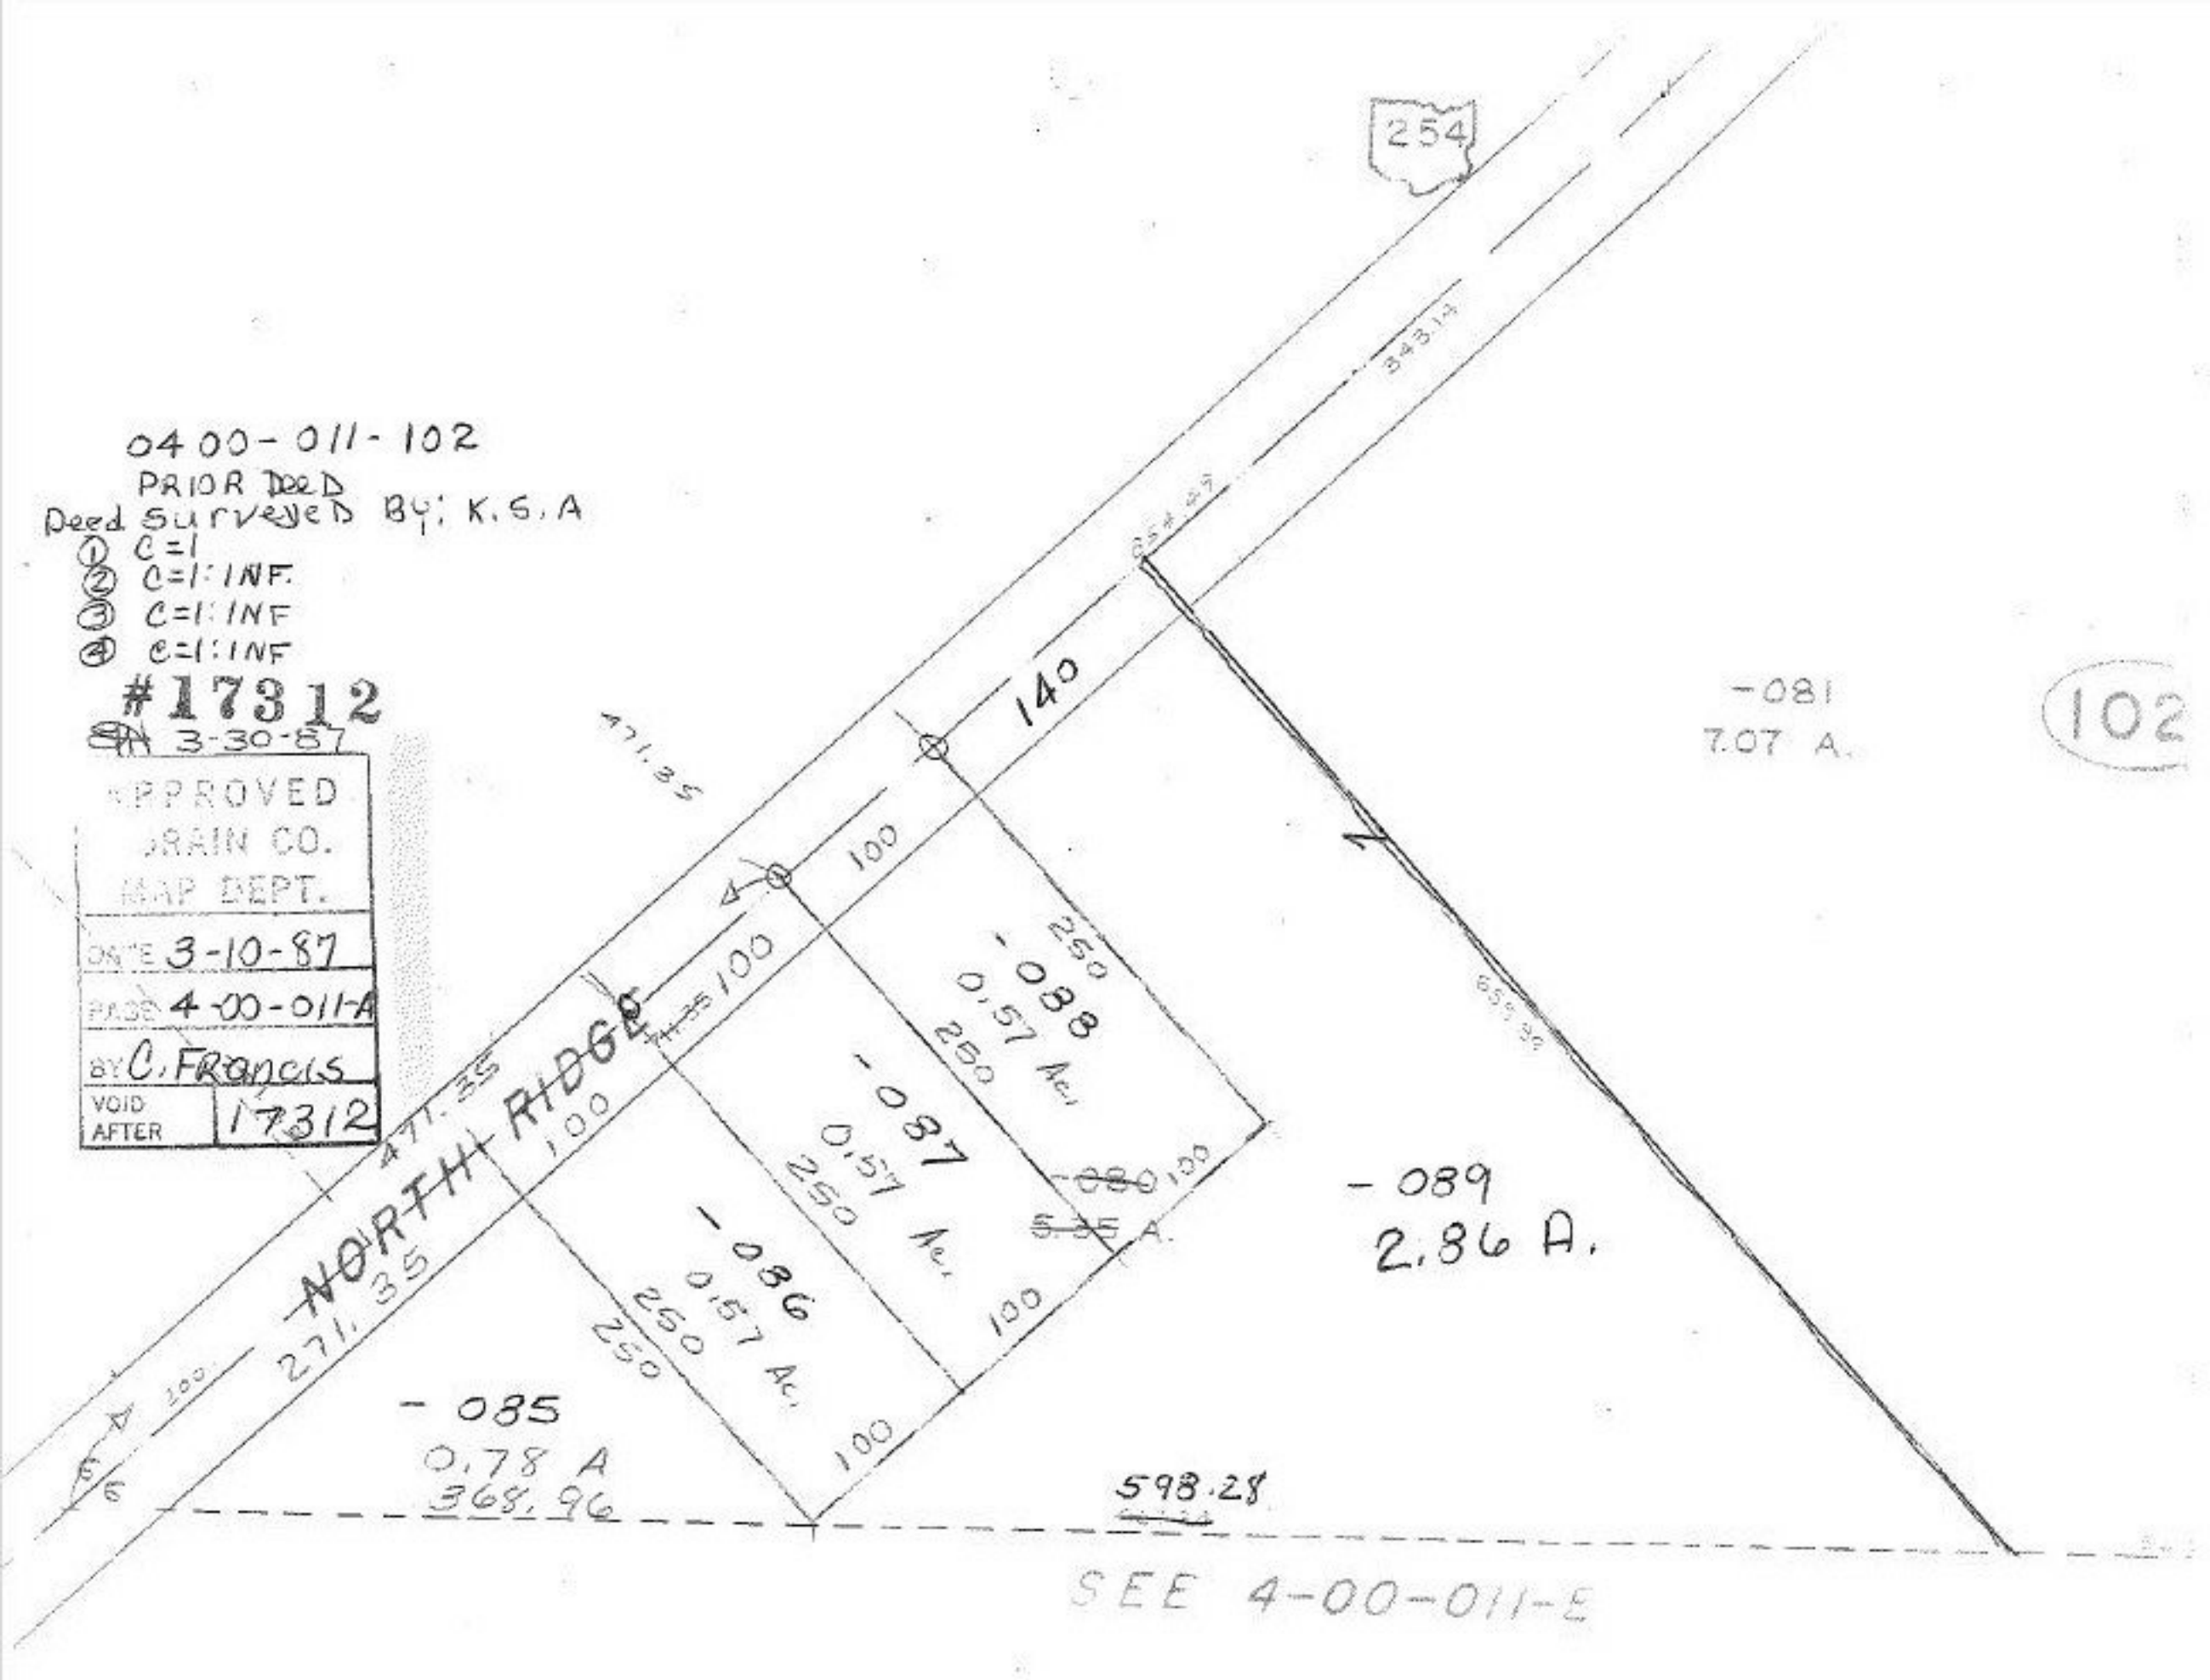

-081
7.07 A.

102