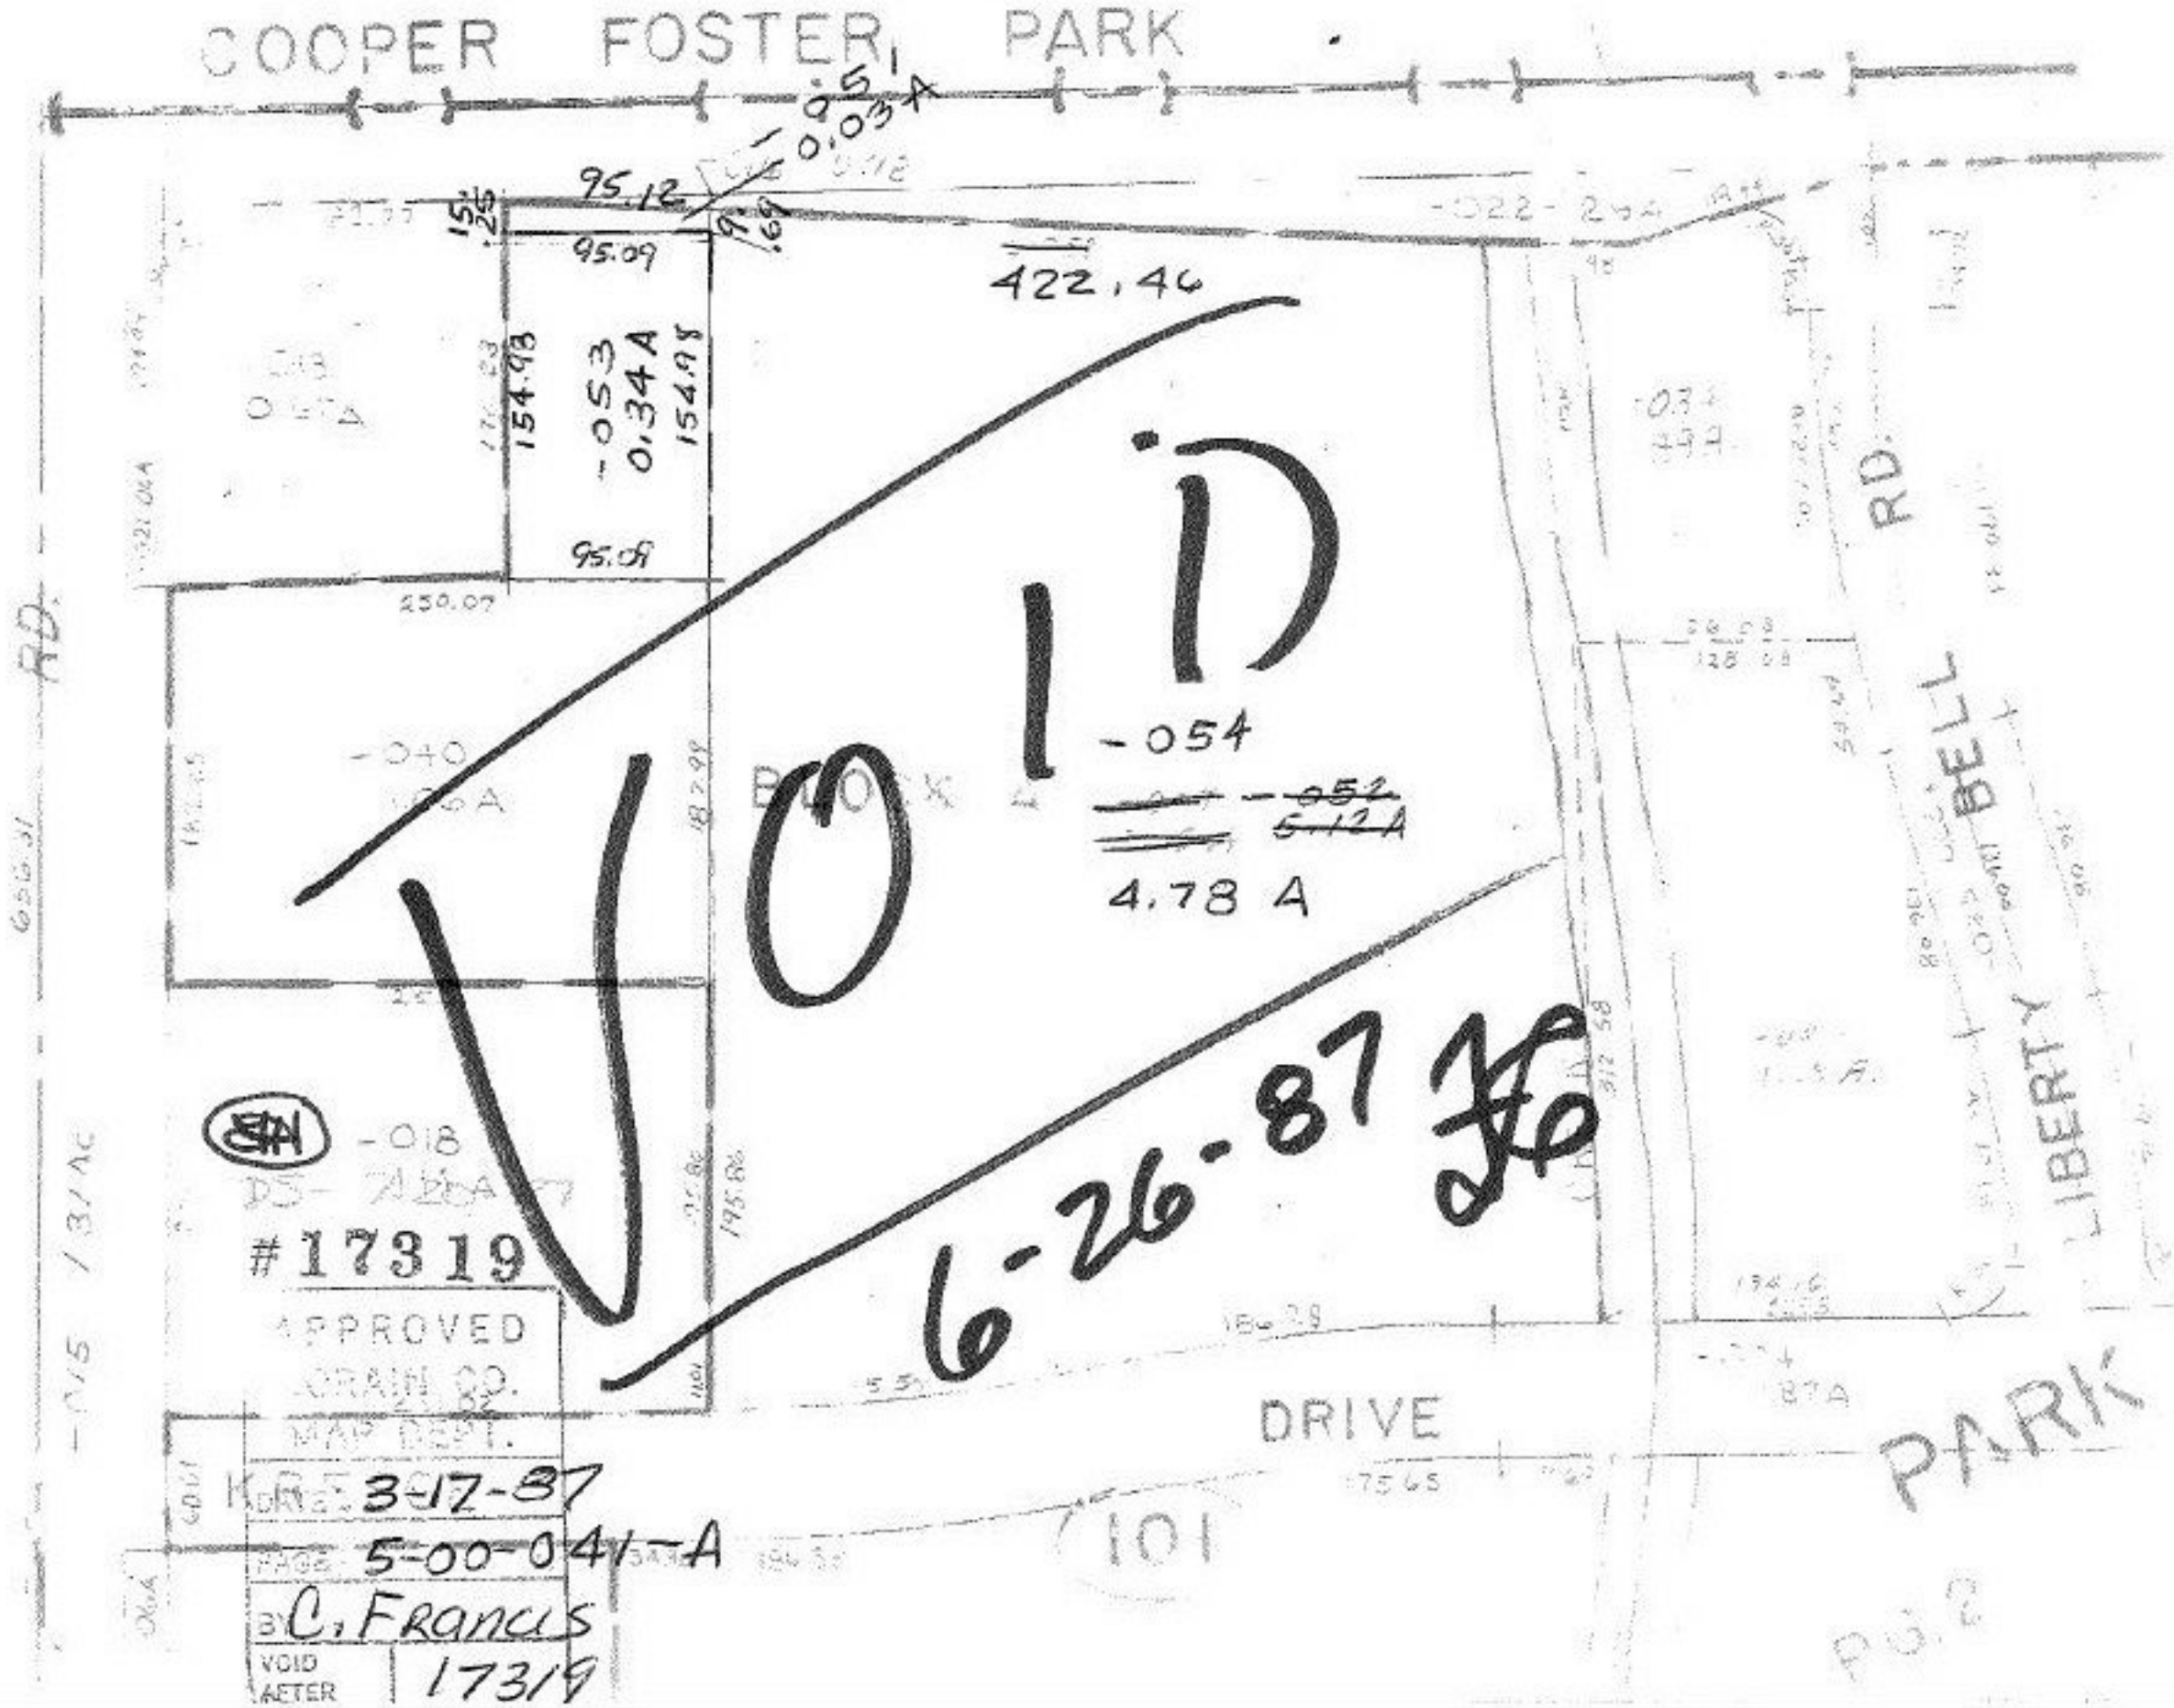
COOPER FOSTER PARK
95.12
95.09
422.46
154.98
-053
0.34 A
154.98
95.09
250.07
-040
-054
4.78 A
-018
#17319
APPROVED
LORAIN CO.
MAP DEPT.
DRIVE
101
RD.
BELL
LIBERTY
PARK
6-26-87
3-17-87
5-00-041-A
C. Francis
17319