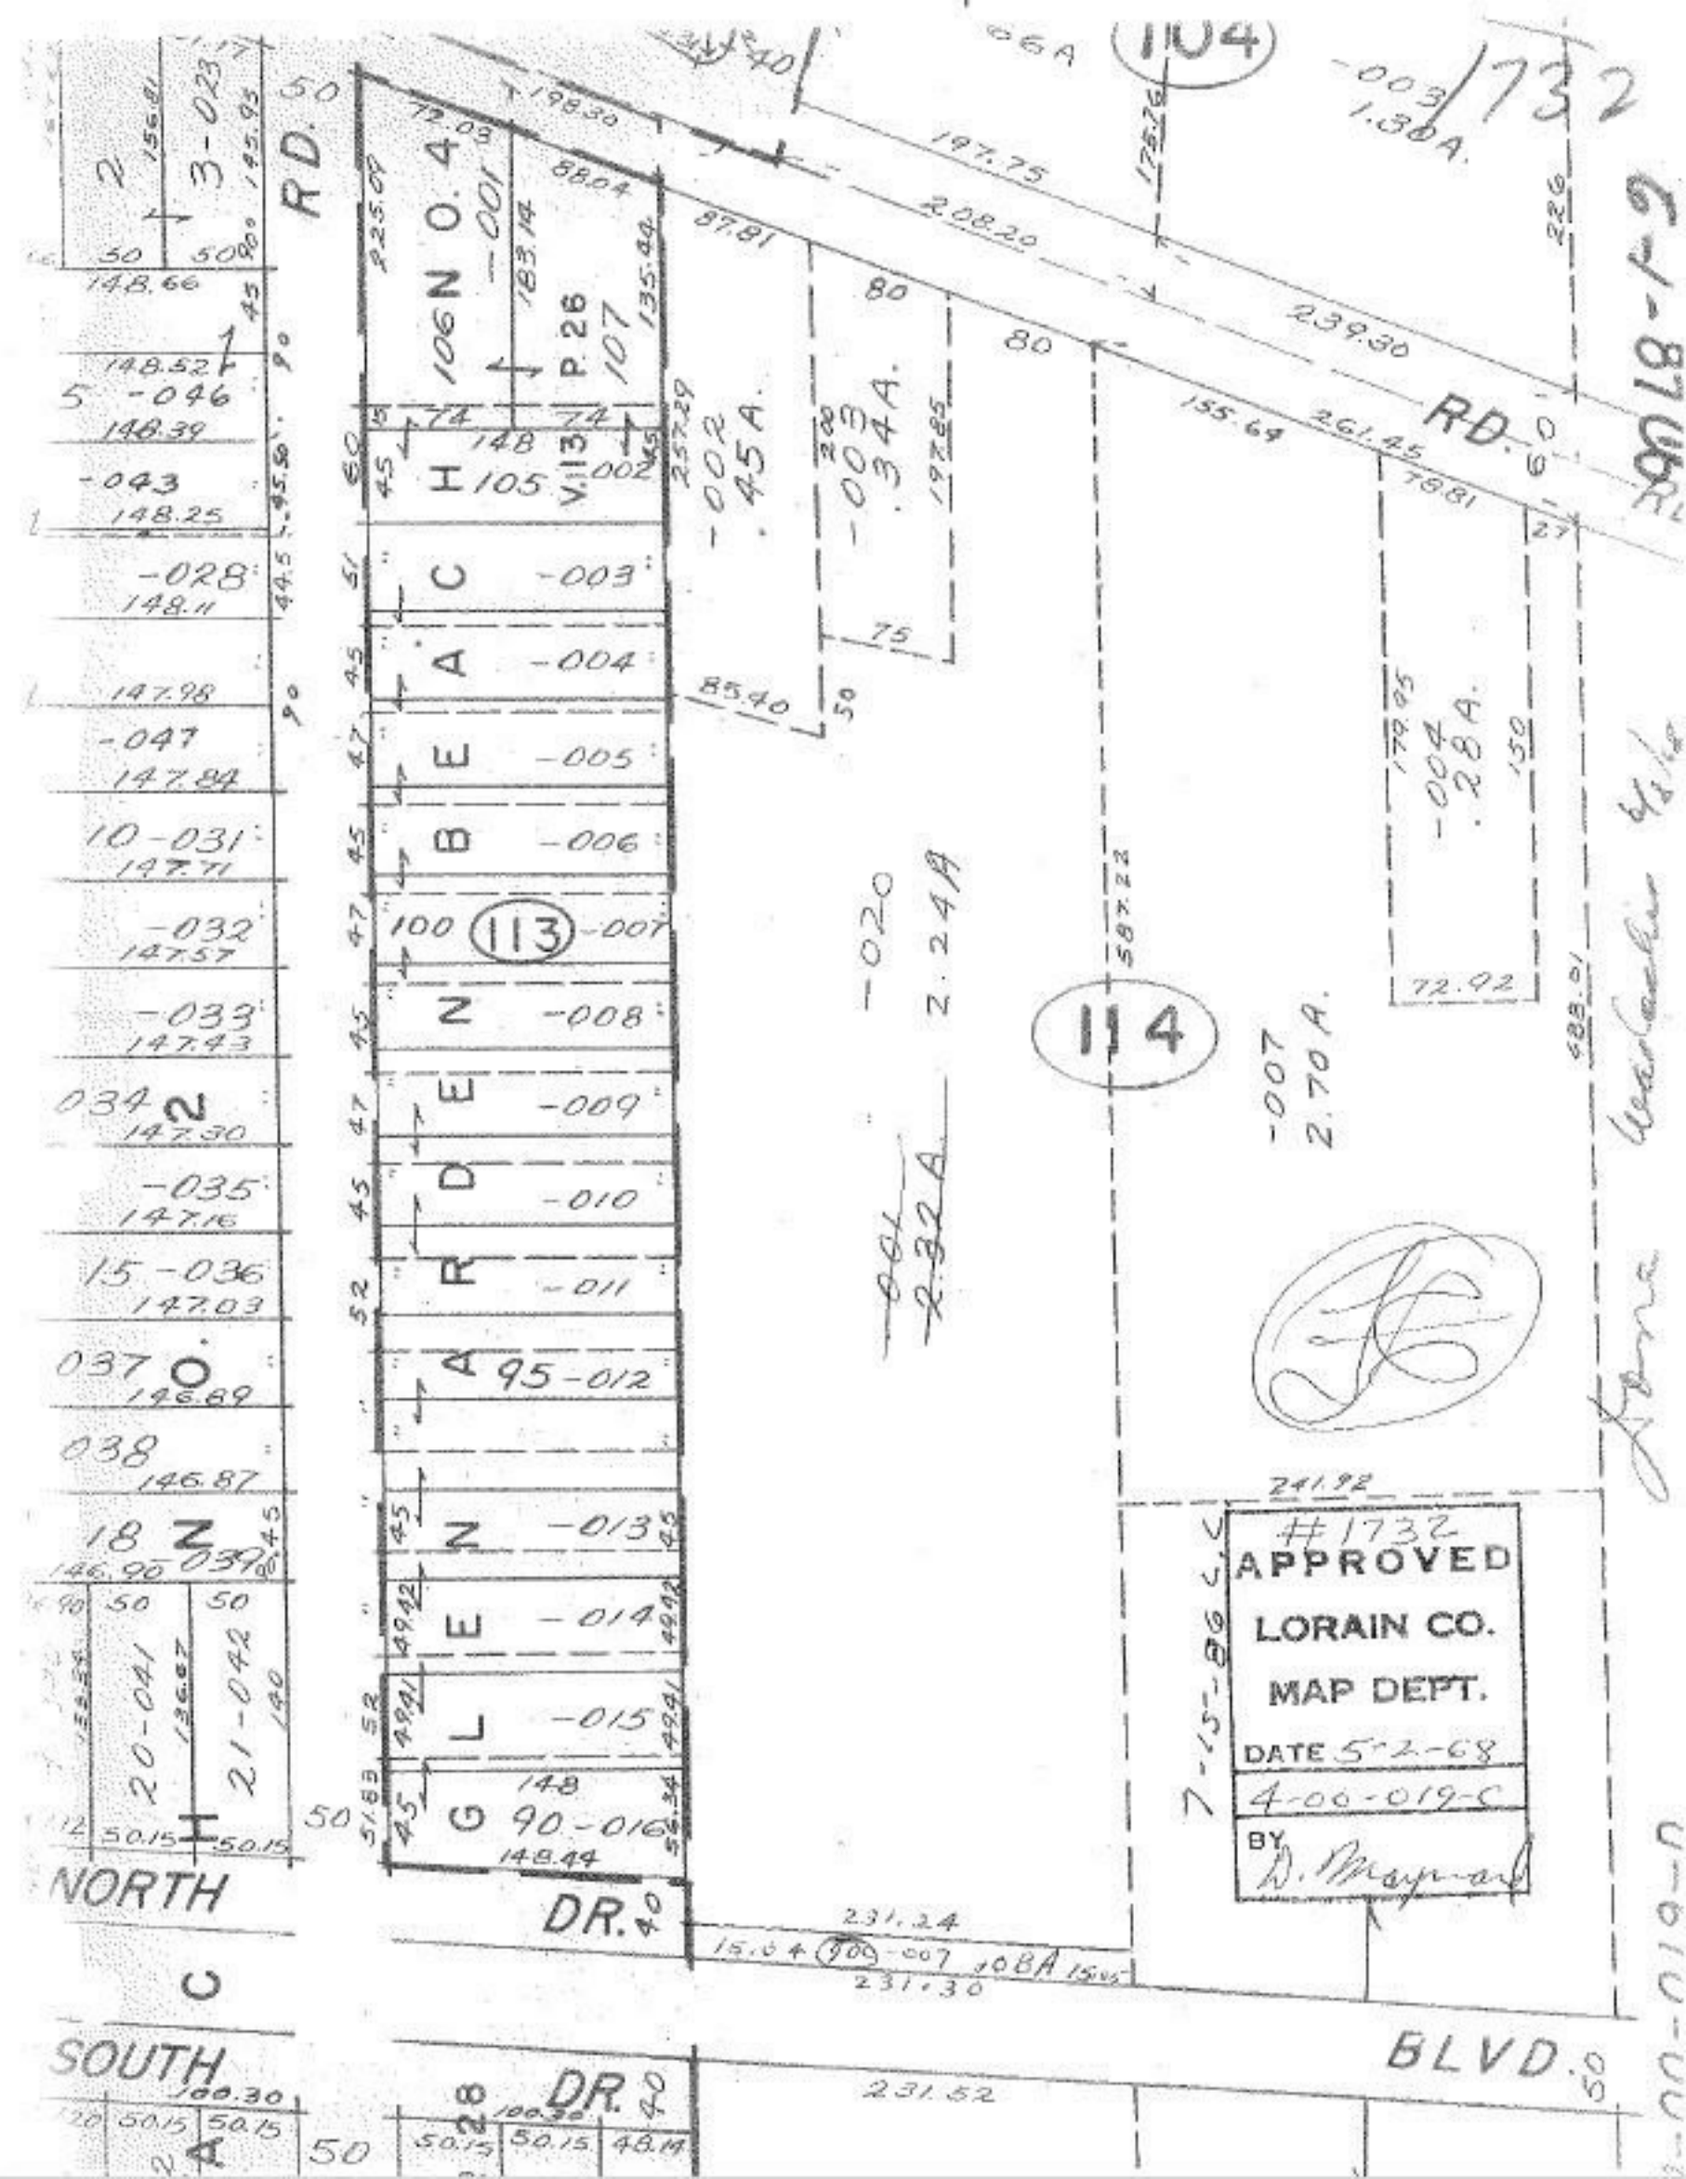
#1732
APPROVED
LORAIN CO.
MAP DEPT.
DATE 5-2-68
4-00-019-C
BY D. Maynard
7-15-86
NORTH
SOUTH
RD.
DR.
BLVD.
106 N O. 4
P. 26
107
105
V. 113
H
C
A
E
B
N
D
R
A
E
L
G
113
114
-001
-002
-003
-004
-005
-006
-007
-008
-009
-010
-011
-012
-013
-014
-015
-016
-020
-039
-041
-042
-043
-046
-047
-028
-031
-032
-033
-035
-036
-037
-038
1.30A.
.34A.
.45A.
2.84A.
2.70A.
2.24A
2.32A
1732