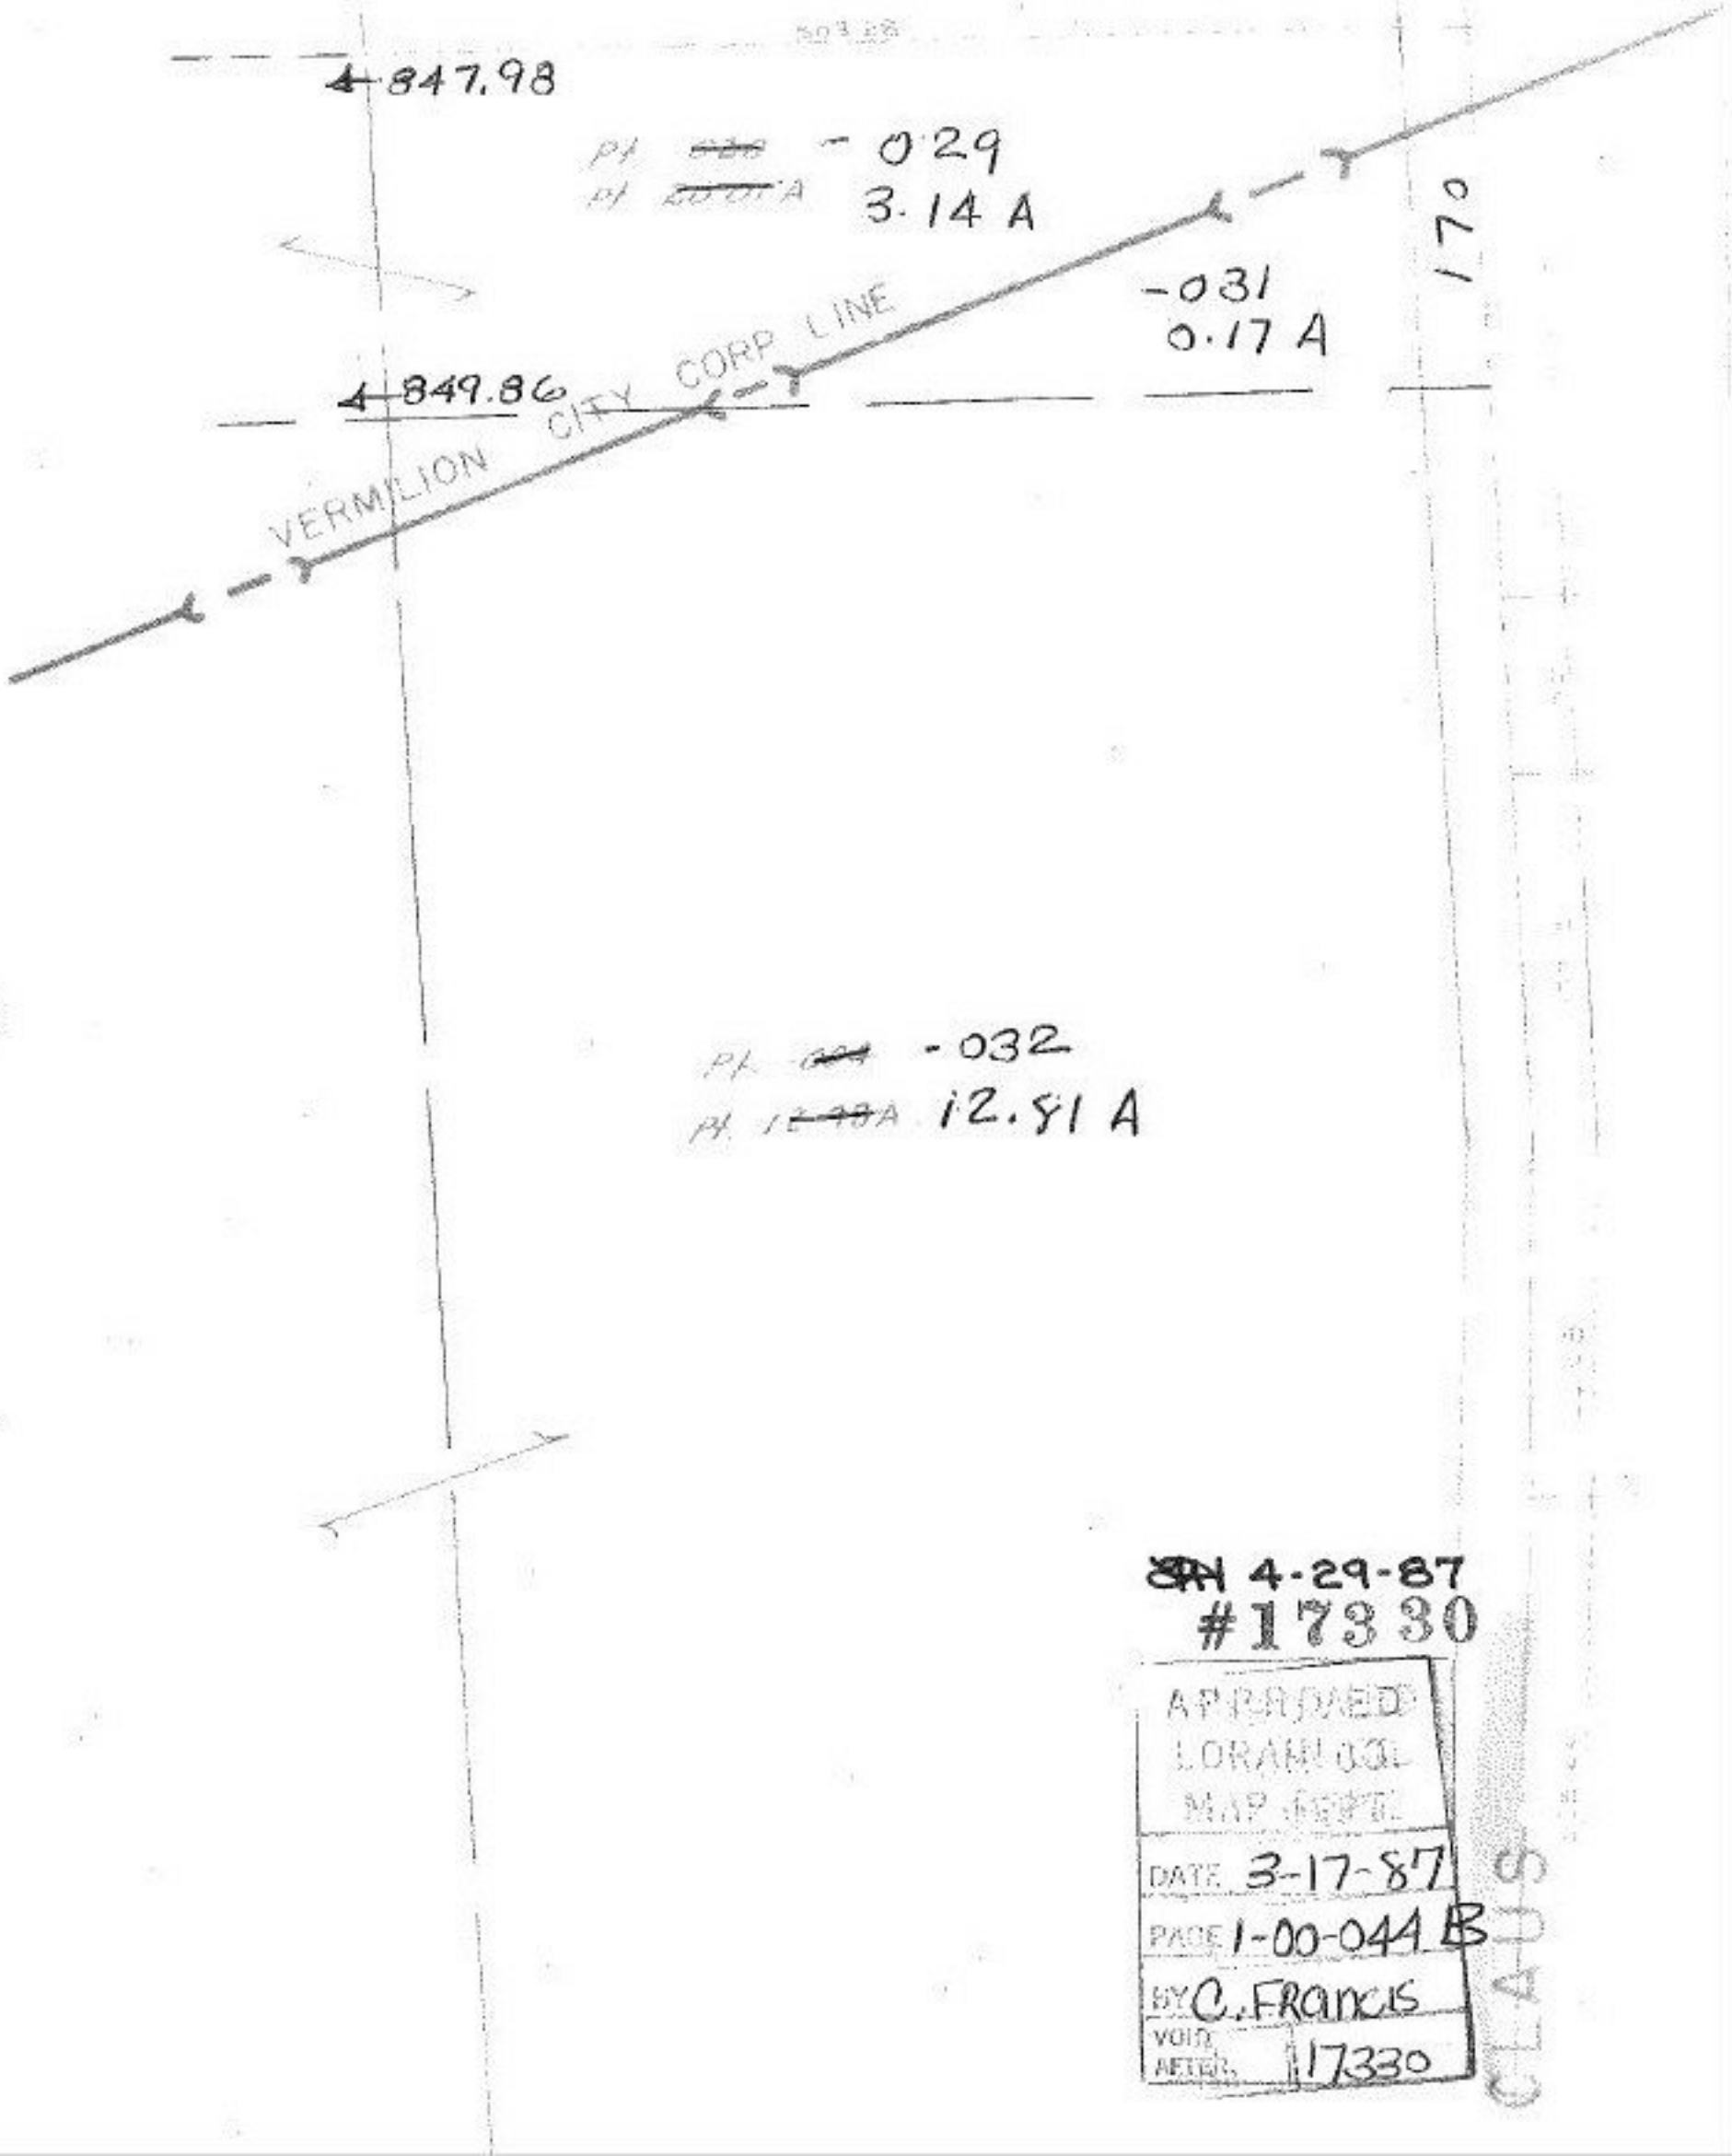

4-29-87
#17330
APPROVED
LORAN CO.
MAP DEPT.
DATE 3-17-87
PAGE 1-00-044 B
BY C. FRANCIS
VOID AFTER 17330
CLAUS