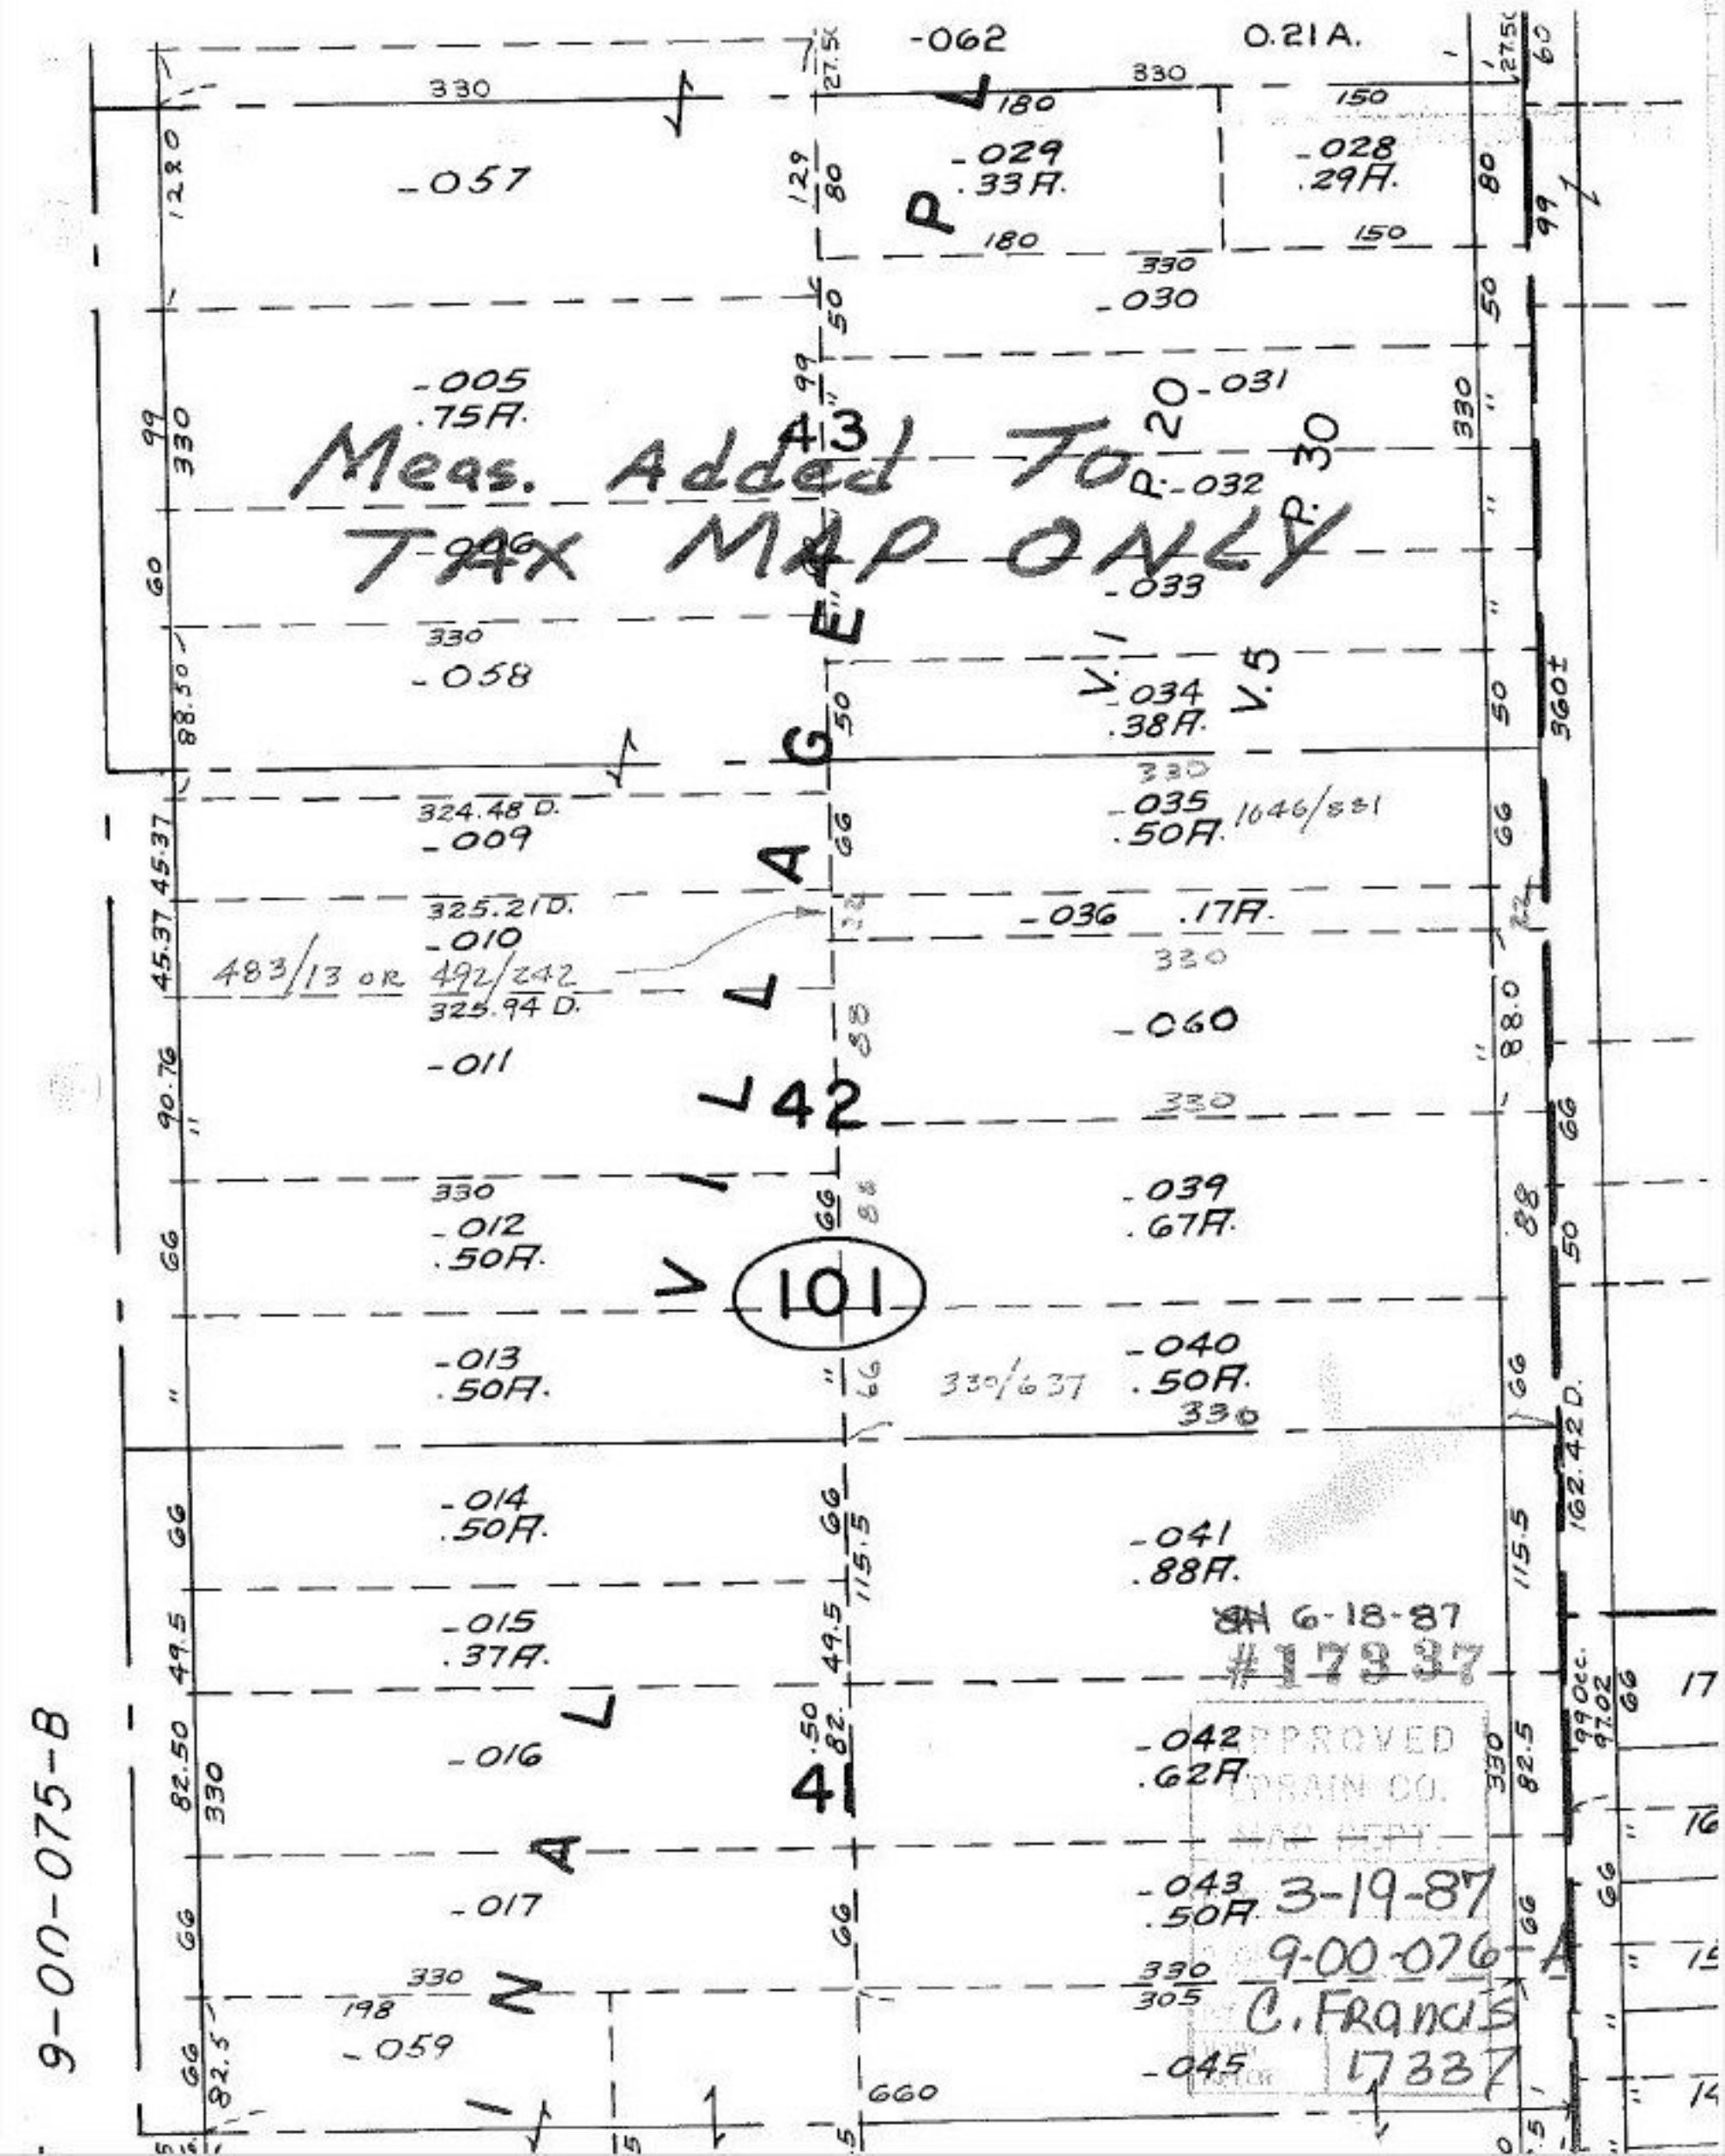

Meas. Added To
TAX MAP ONLY
-062
0.21A.
-057
-029
.33A.
-028
.29A.
-030
-005
.75A.
-031
-032
-033
-058
-034
.38A.
-035
.50A.
1046/881
324.48 D.
-009
325.21 D.
-010
483/13 OR 492/242
325.94 D.
-011
-036
.17A.
-060
-012
.50A.
-039
.67A.
-013
.50A.
-040
.50A.
330/637
-014
.50A.
-041
.88A.
-015
.37A.
-016
-042
.62A.
-017
-043
.50A.
-059
-045
43
42
41
101
P.20
P.30
V.1
V.5
6-18-87
#17337
APPROVED
DRAIN CO.
3-19-87
9-00-076-A
C. Francis
17337
9-00-075-B