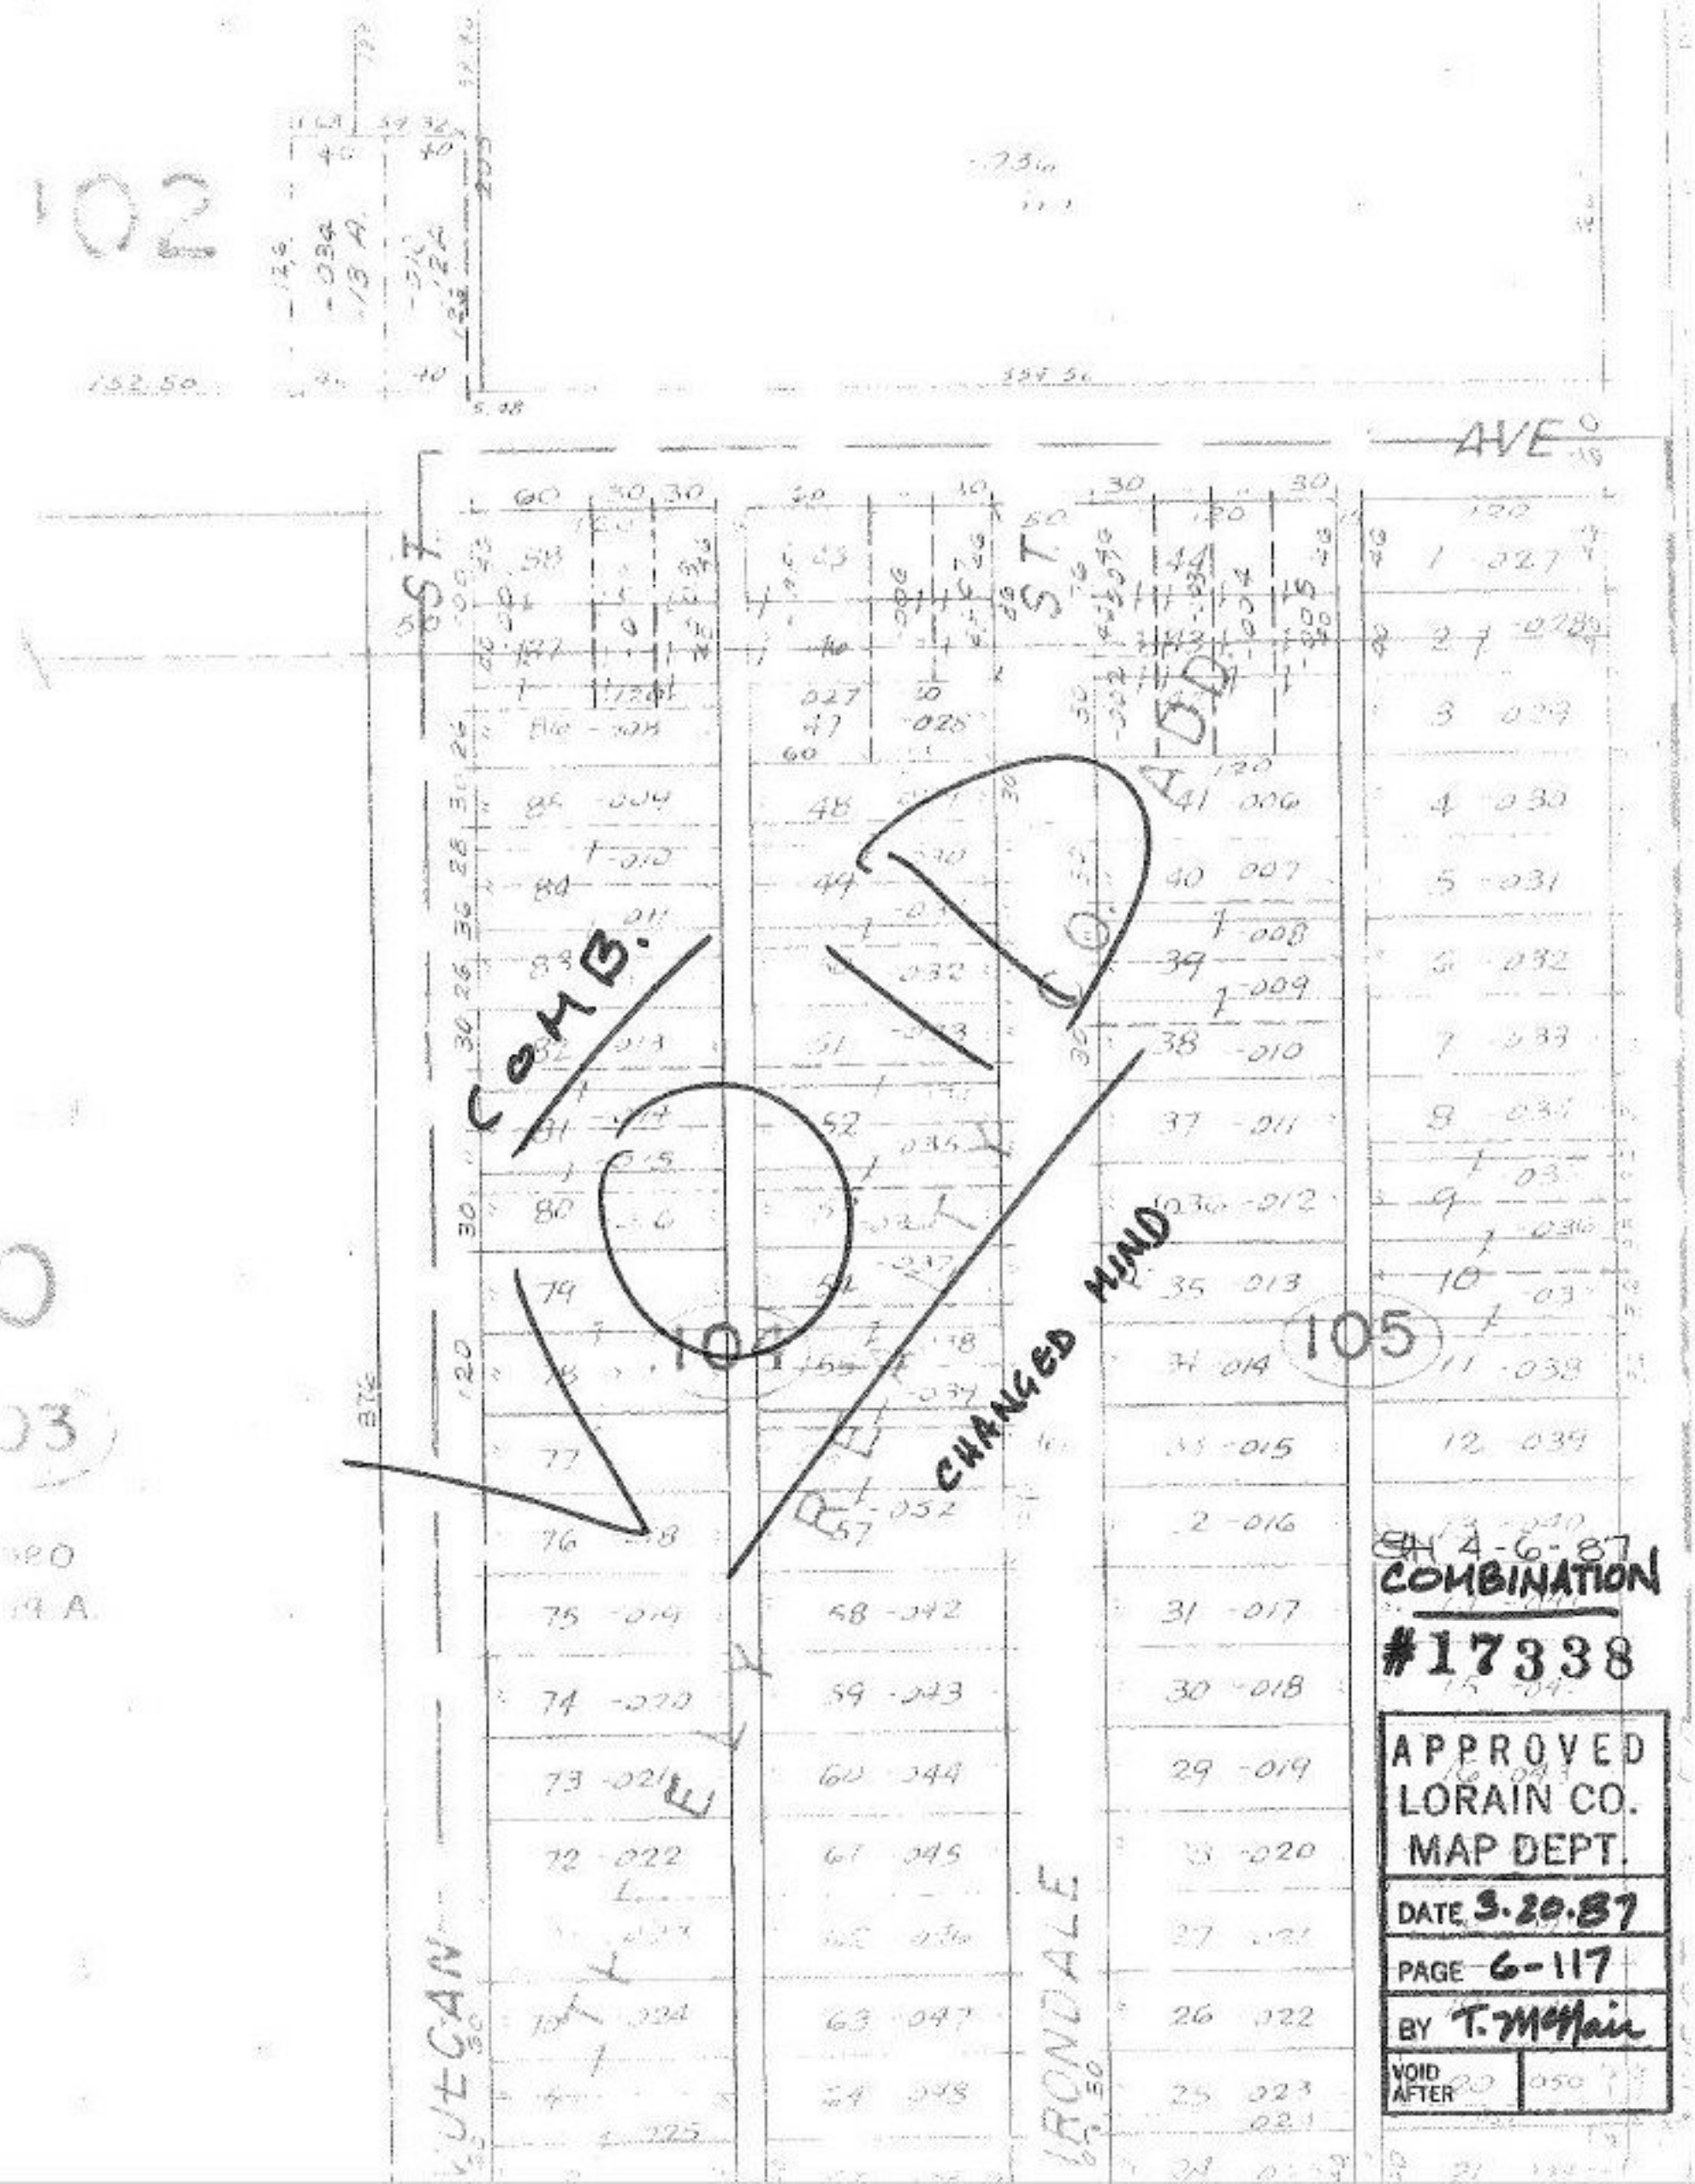
AVE
ST
ADD
COMB.
CHANGED MIND
104
105
IRONDALE
COMBINATION
#17338
APPROVED
LORAIN CO.
MAP DEPT.
DATE 3.20.87
PAGE 6-117
BY T. McMain
VOID AFTER