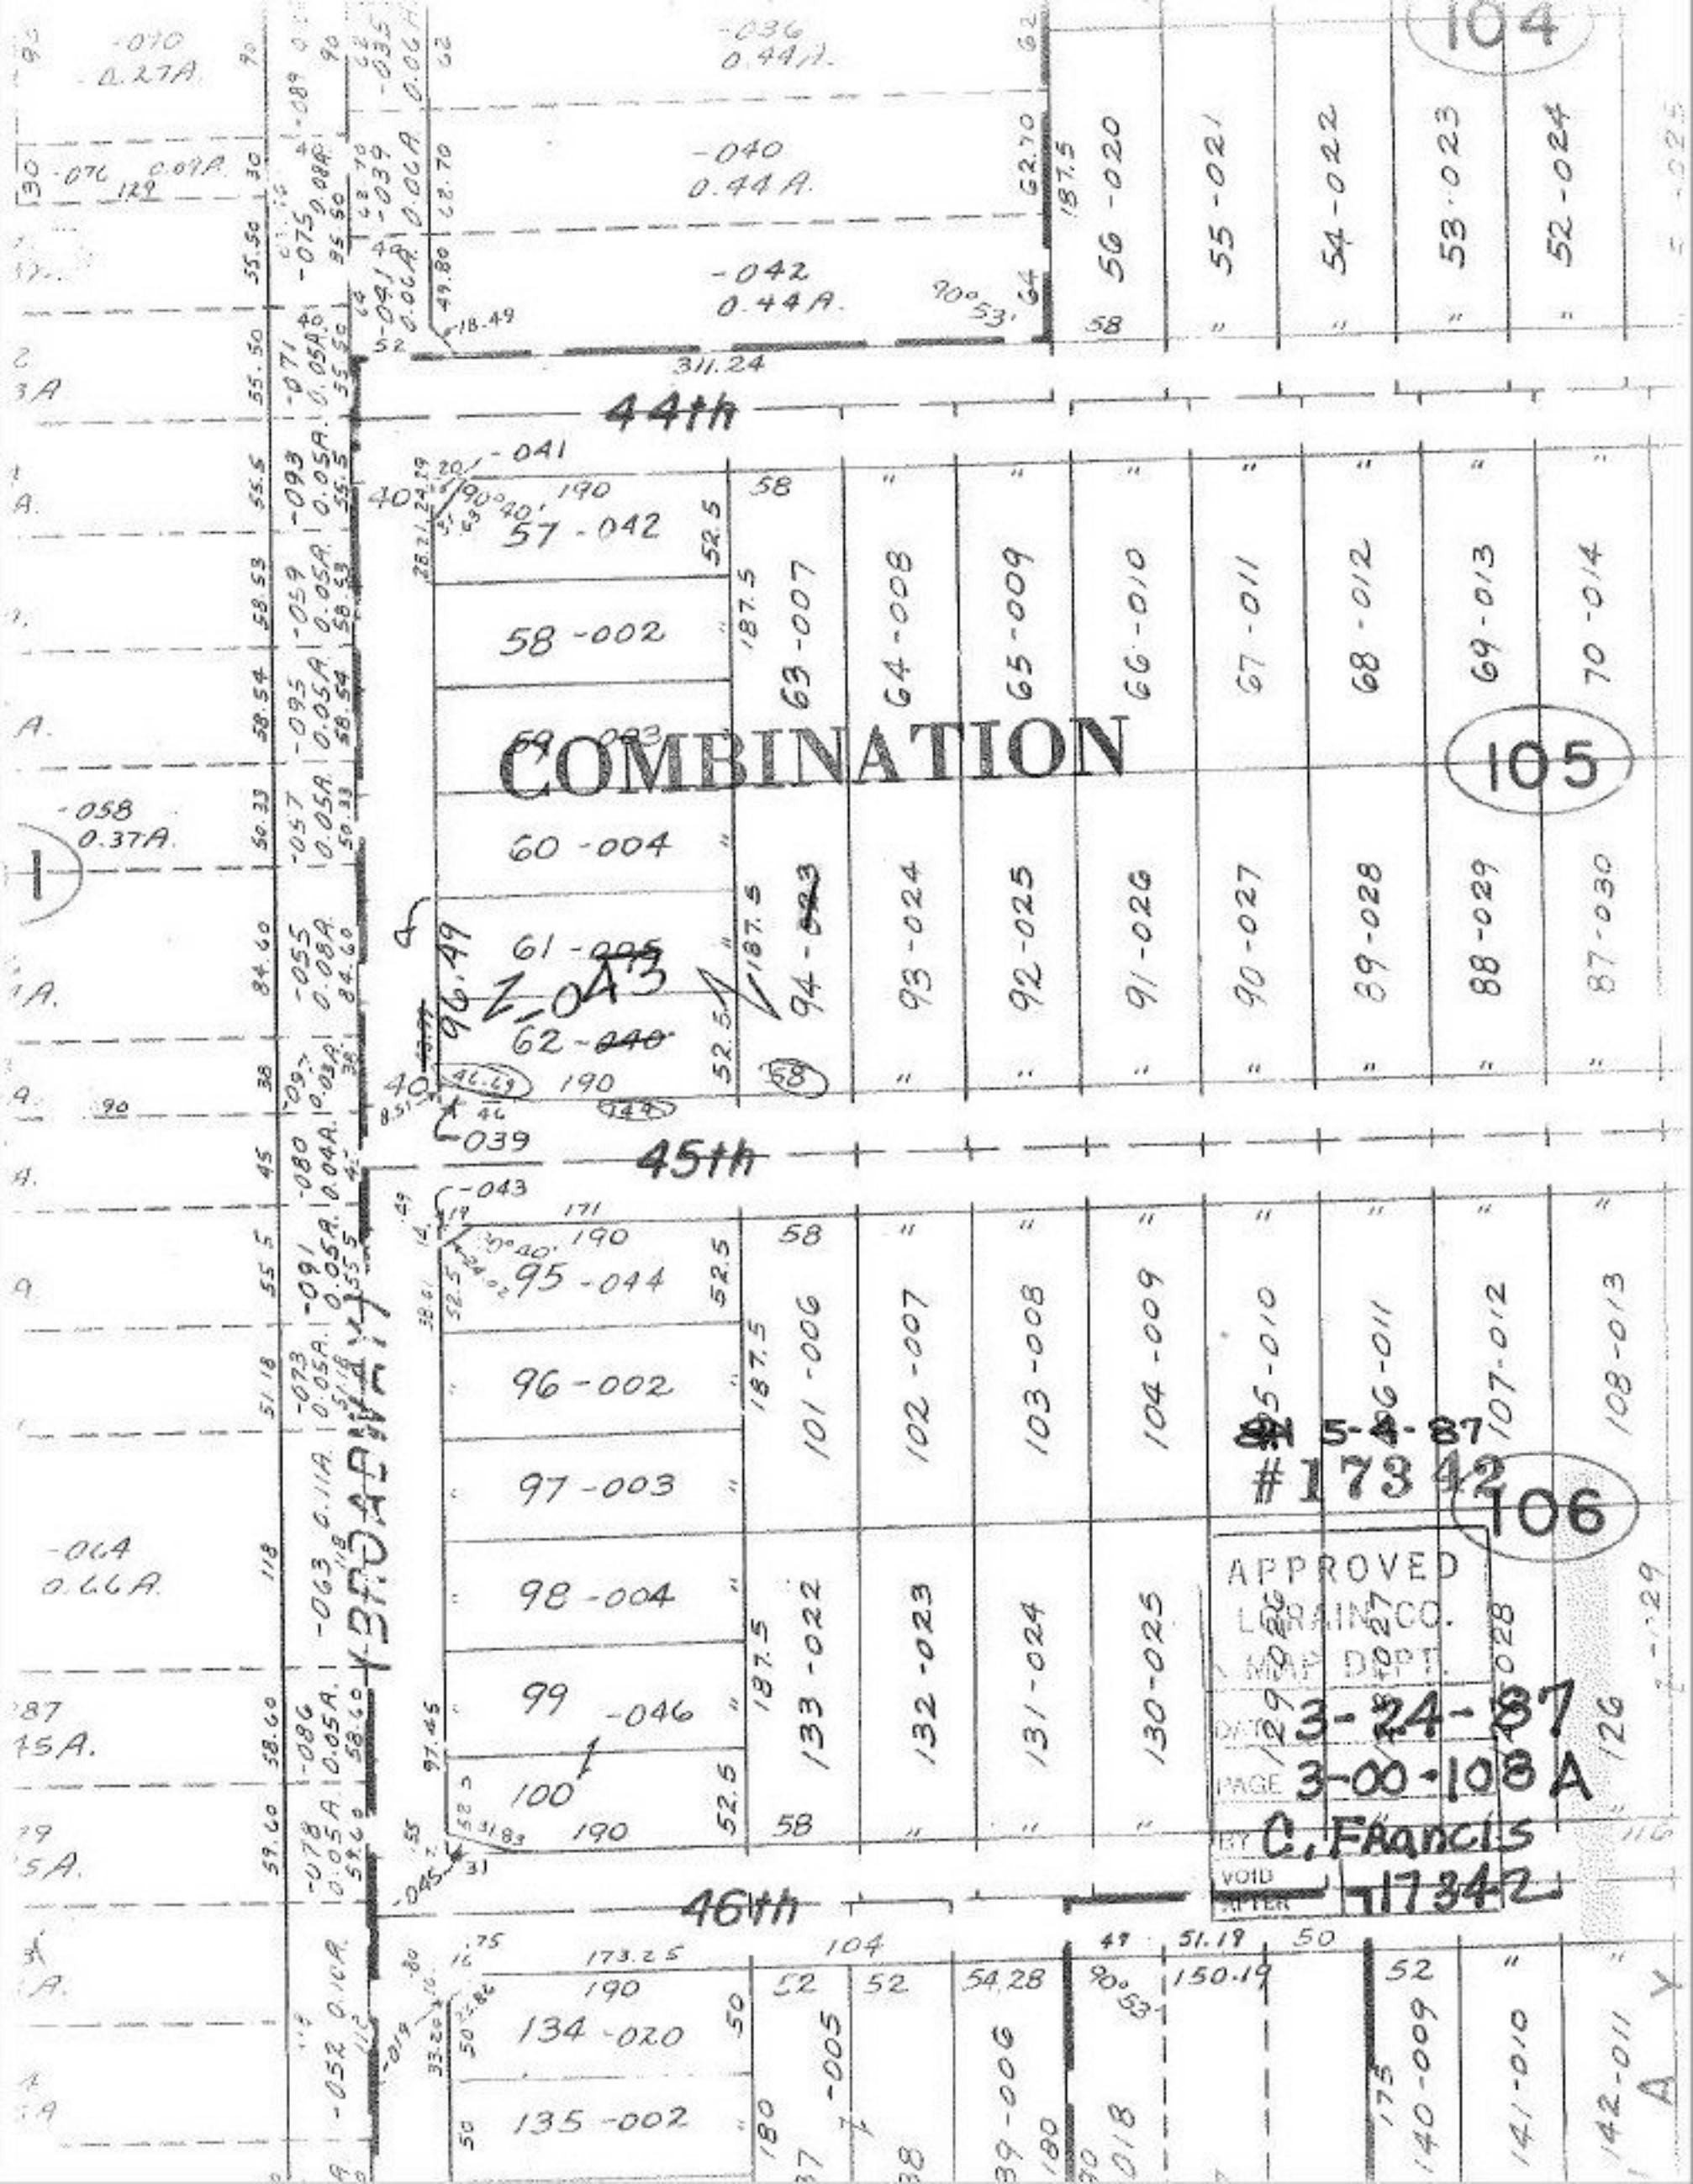

104
105
106
44th
45th
46th
COMBINATION
Z-043
BROADWAY
5-4-87
#17342
APPROVED
LORAIN CO.
MAP DEPT.
DATE 3-24-87
PAGE 3-00-108A
BY C. Francis
VOID
AFTER 17342