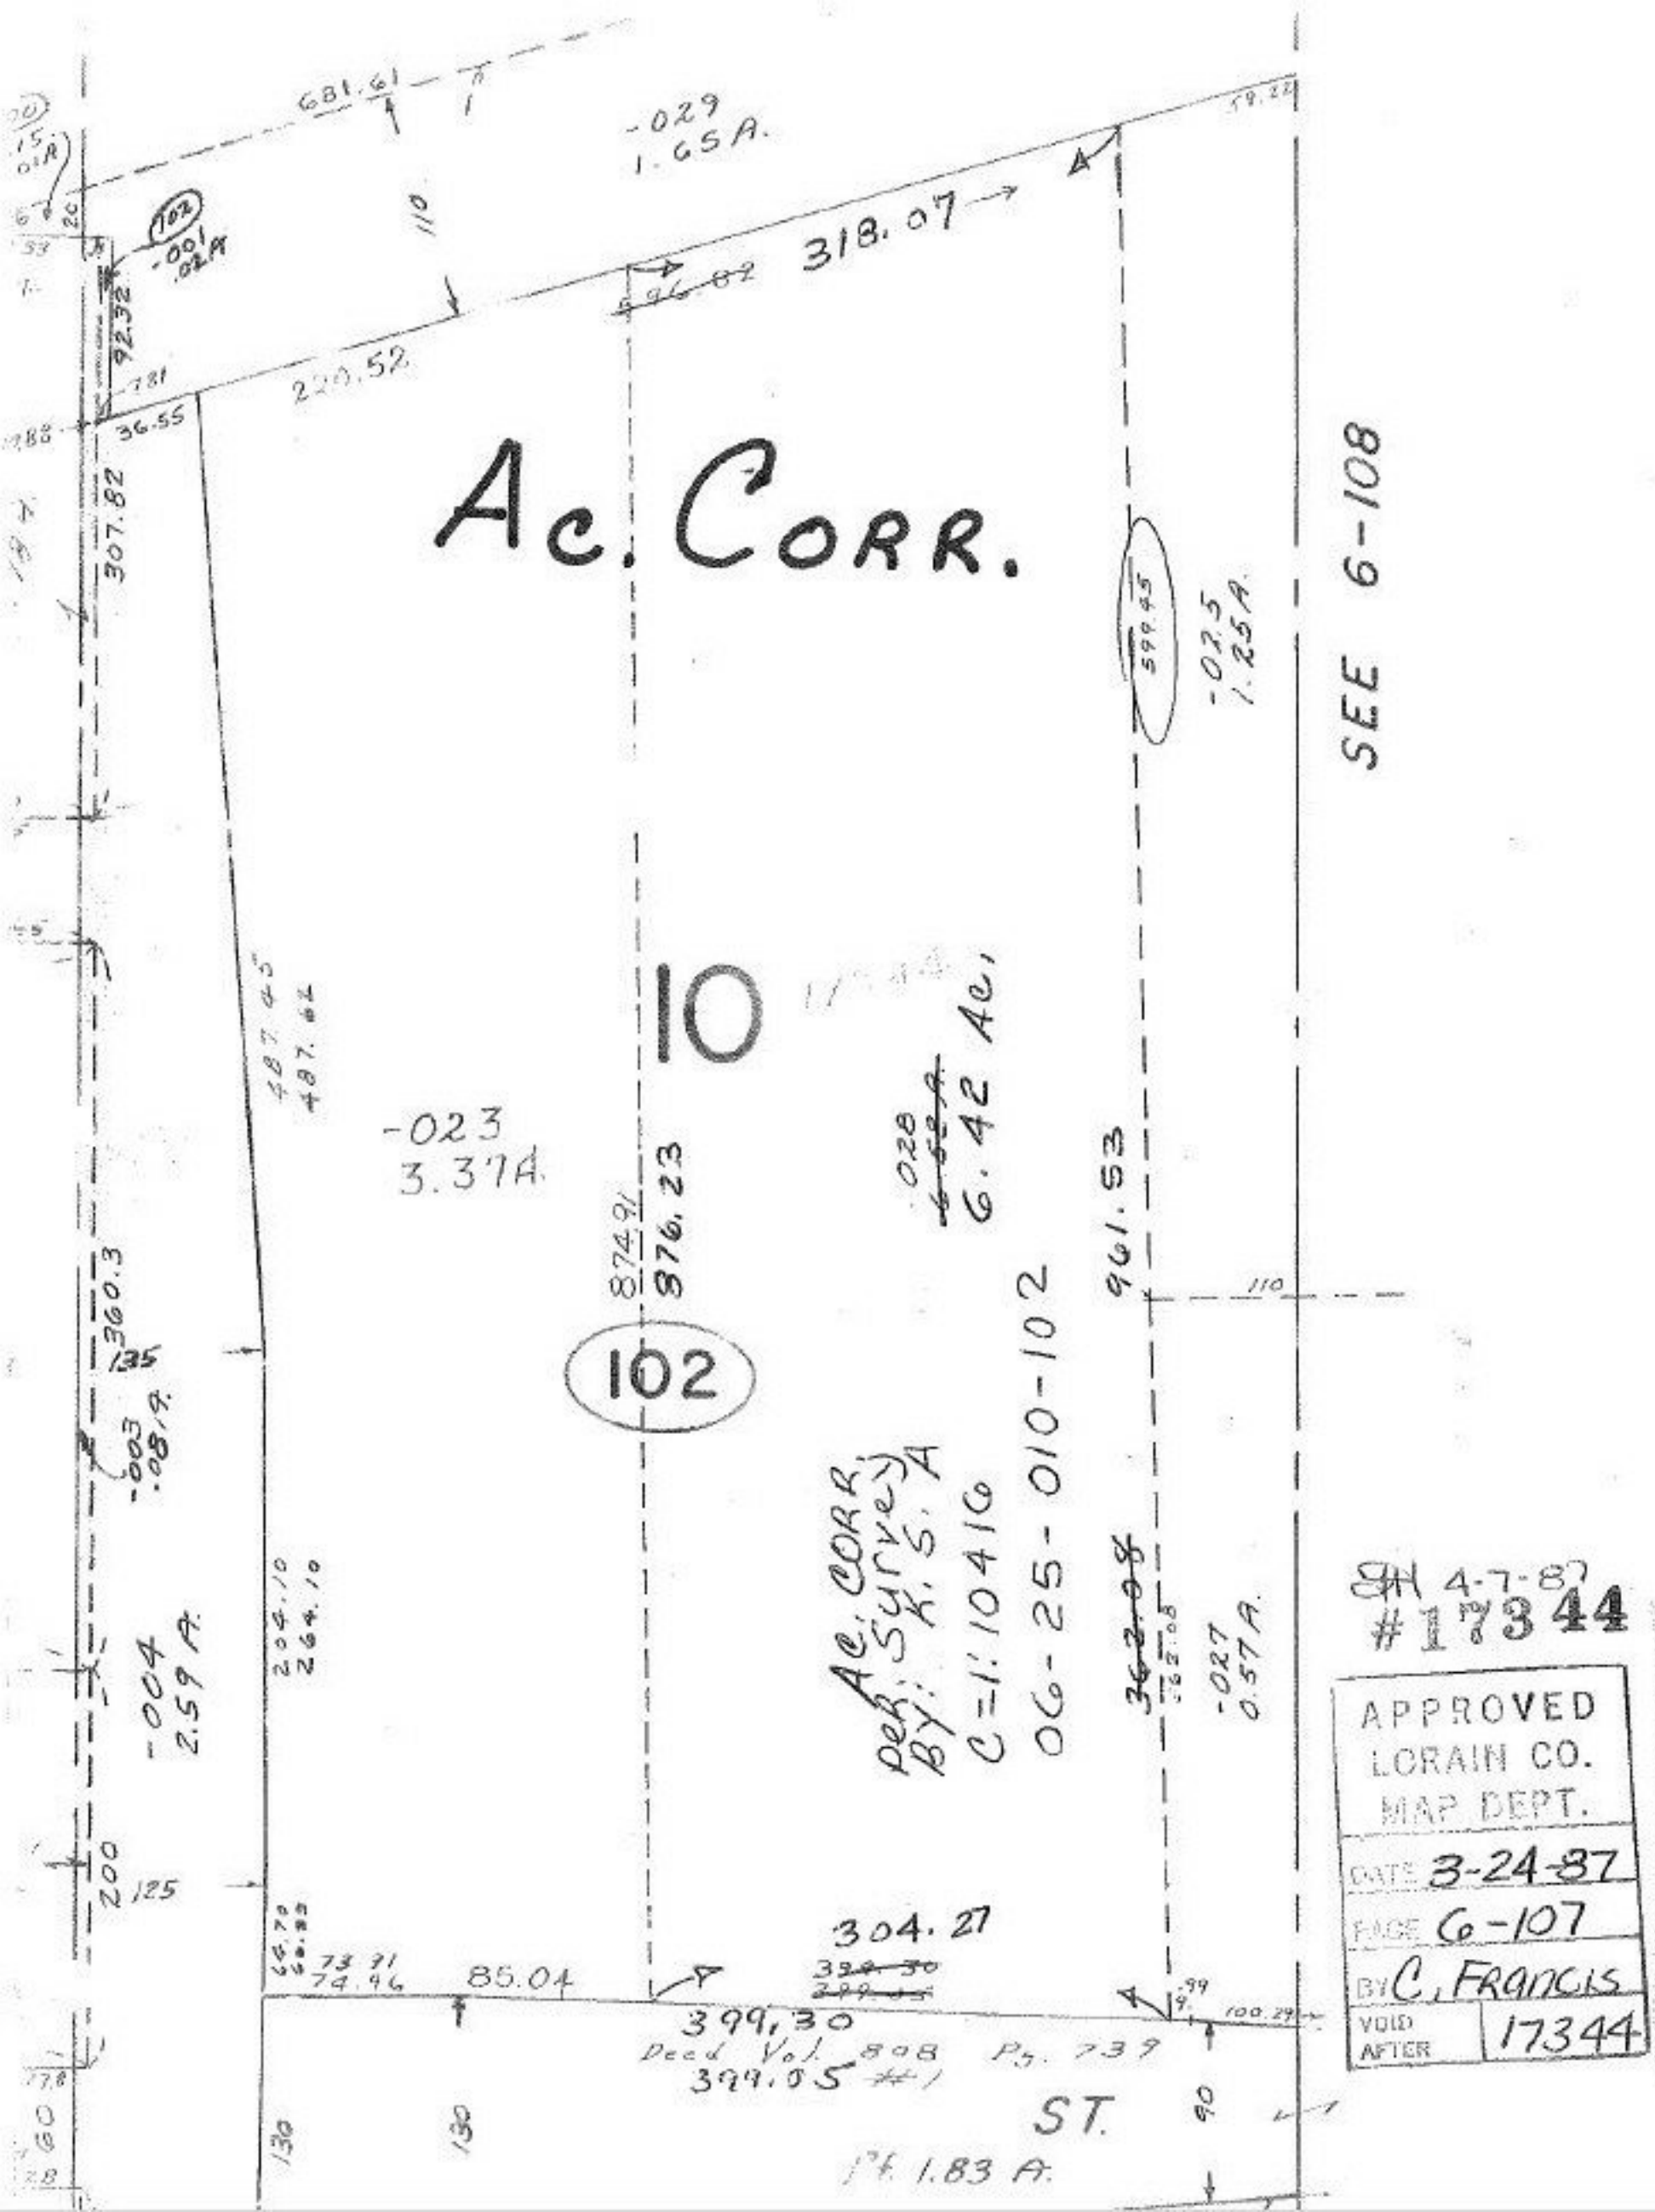

SH 4-7-87
#17344

APPROVED
LORAIN CO.
MAP DEPT.
DATE 3-24-87
PAGE 6-107
BY C. FRANCIS
VOID AFTER 17344