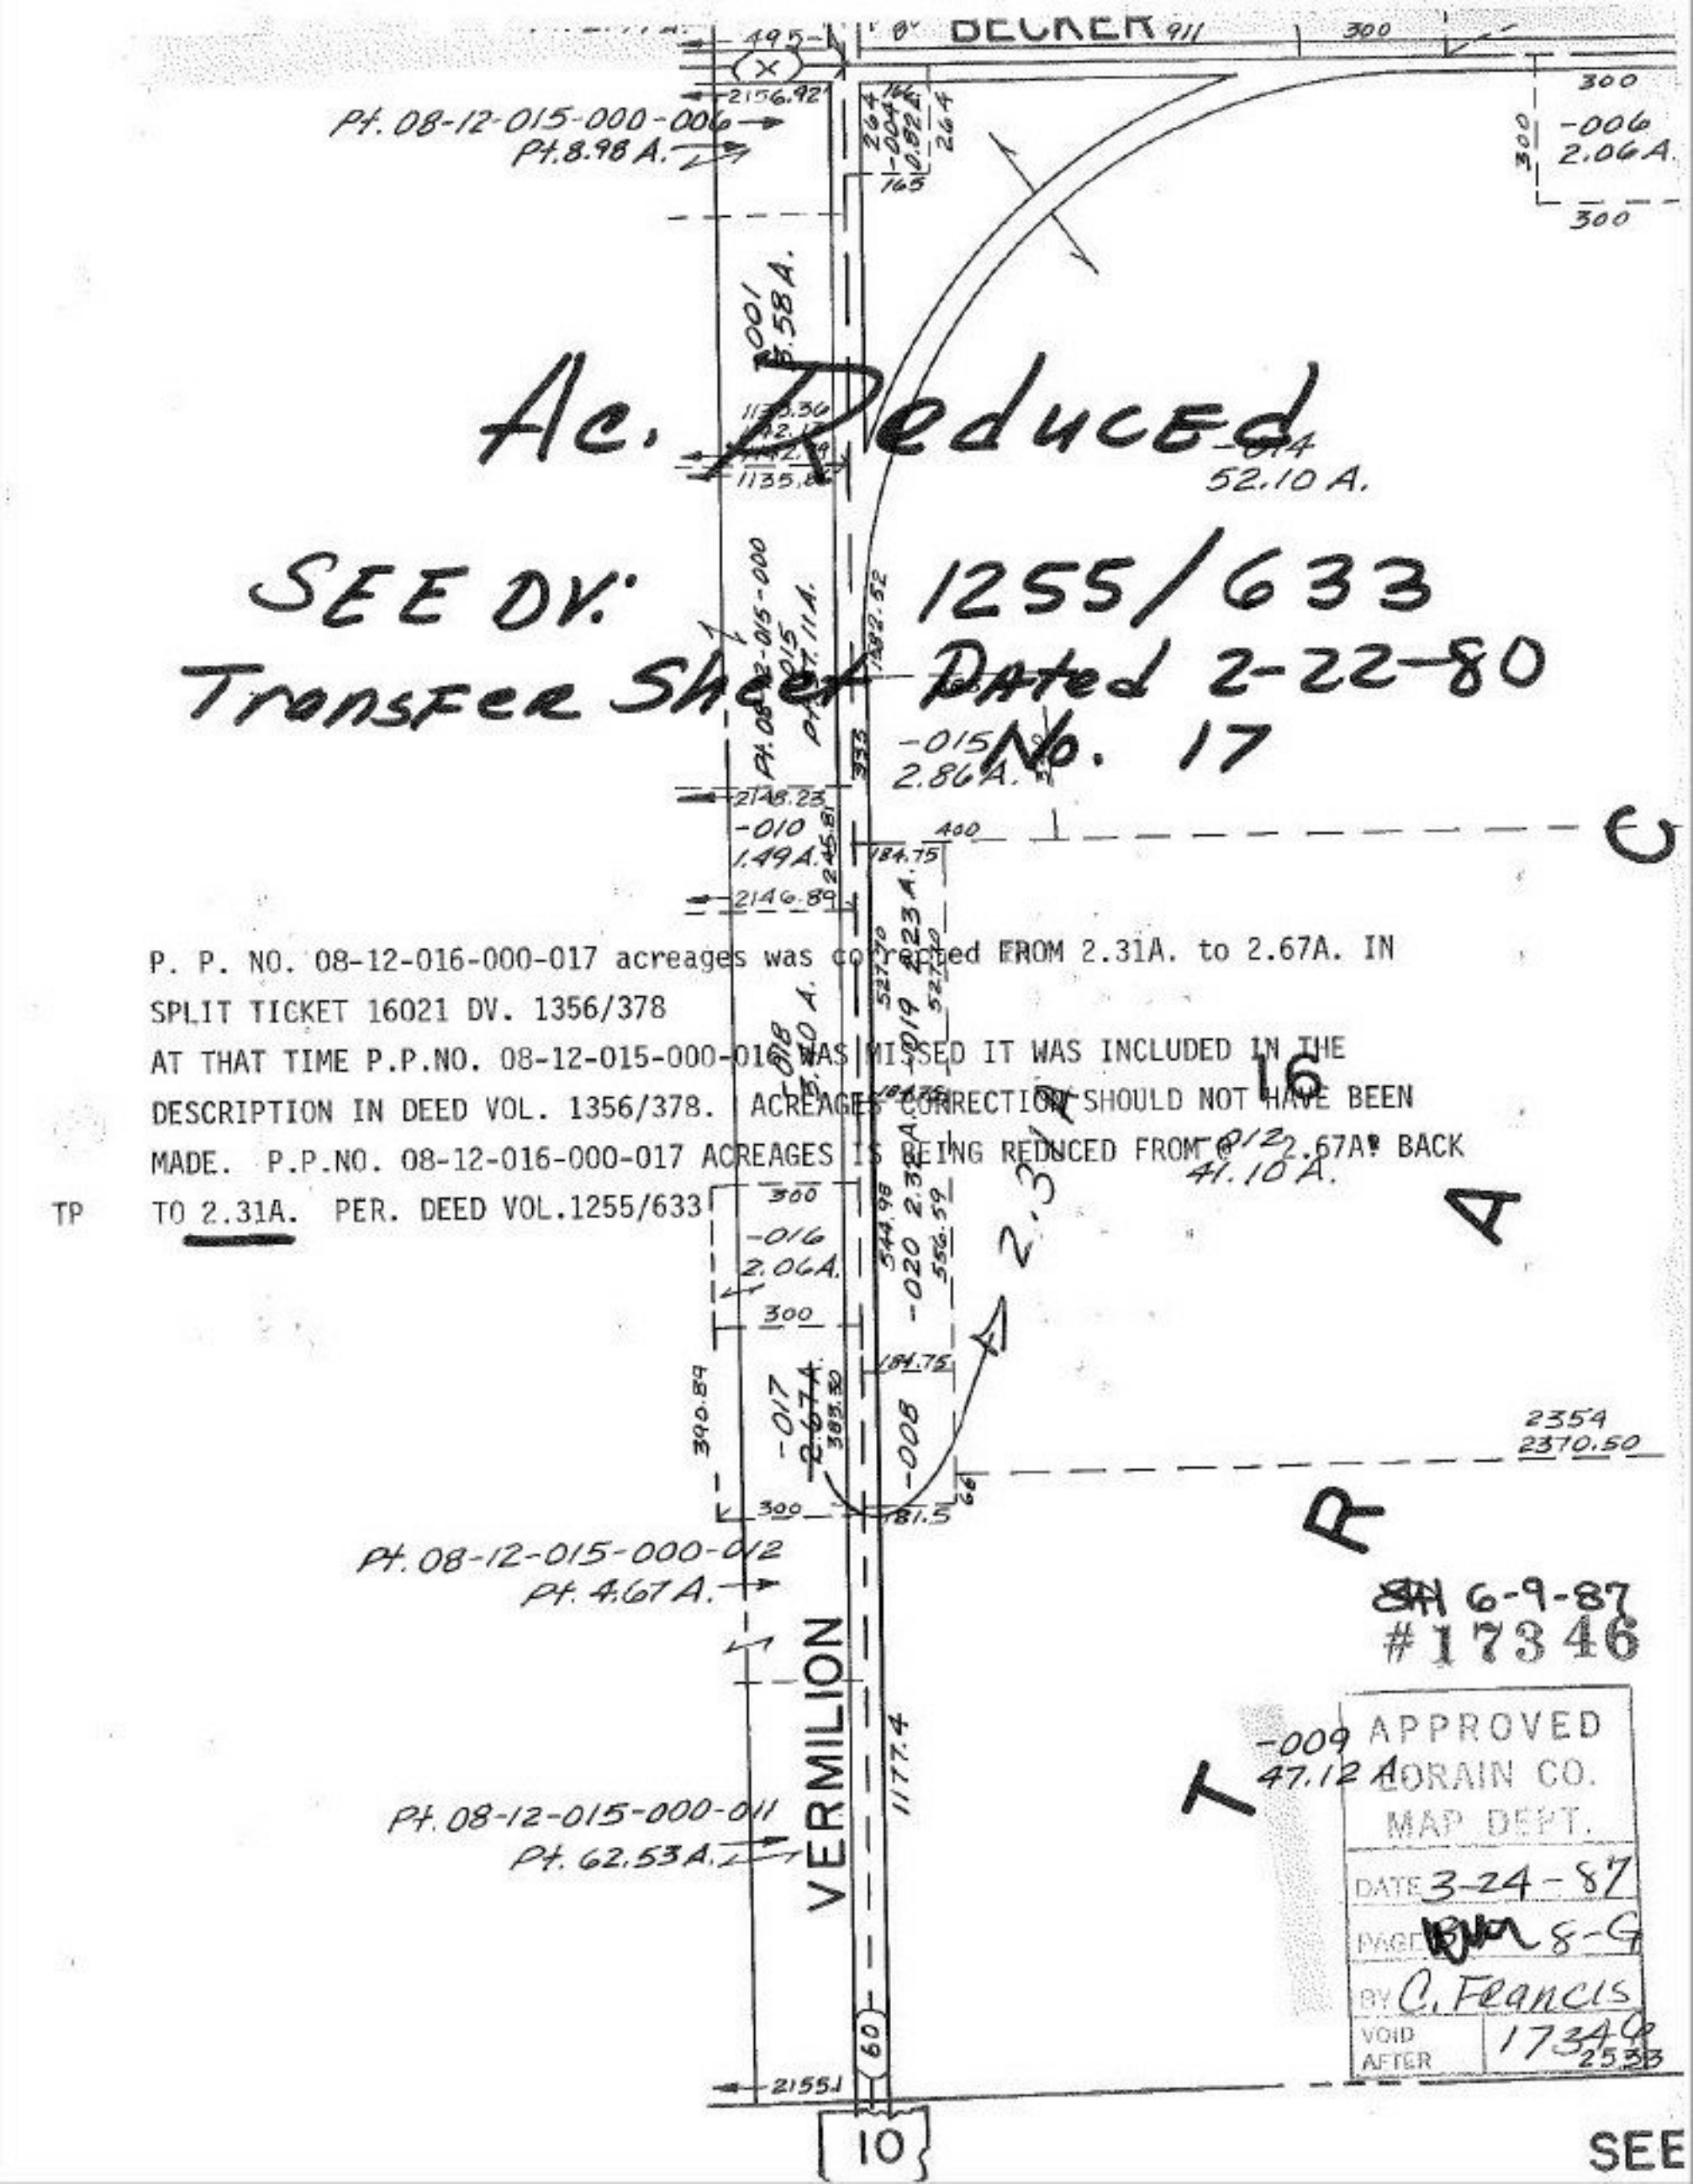

P. P. NO. 08-12-016-000-017 acreages was corrected FROM 2.31A. to 2.67A. IN SPLIT TICKET 16021 DV. 1356/378

AT THAT TIME P.P.NO. 08-12-015-000-016 WAS MISSED IT WAS INCLUDED IN THE DESCRIPTION IN DEED VOL. 1356/378. ACREAGES CORRECTION SHOULD NOT HAVE BEEN MADE. P.P.NO. 08-12-016-000-017 ACREAGES IS BEING REDUCED FROM 2.67A BACK TO 2.31A. PER. DEED VOL.1255/633

TP