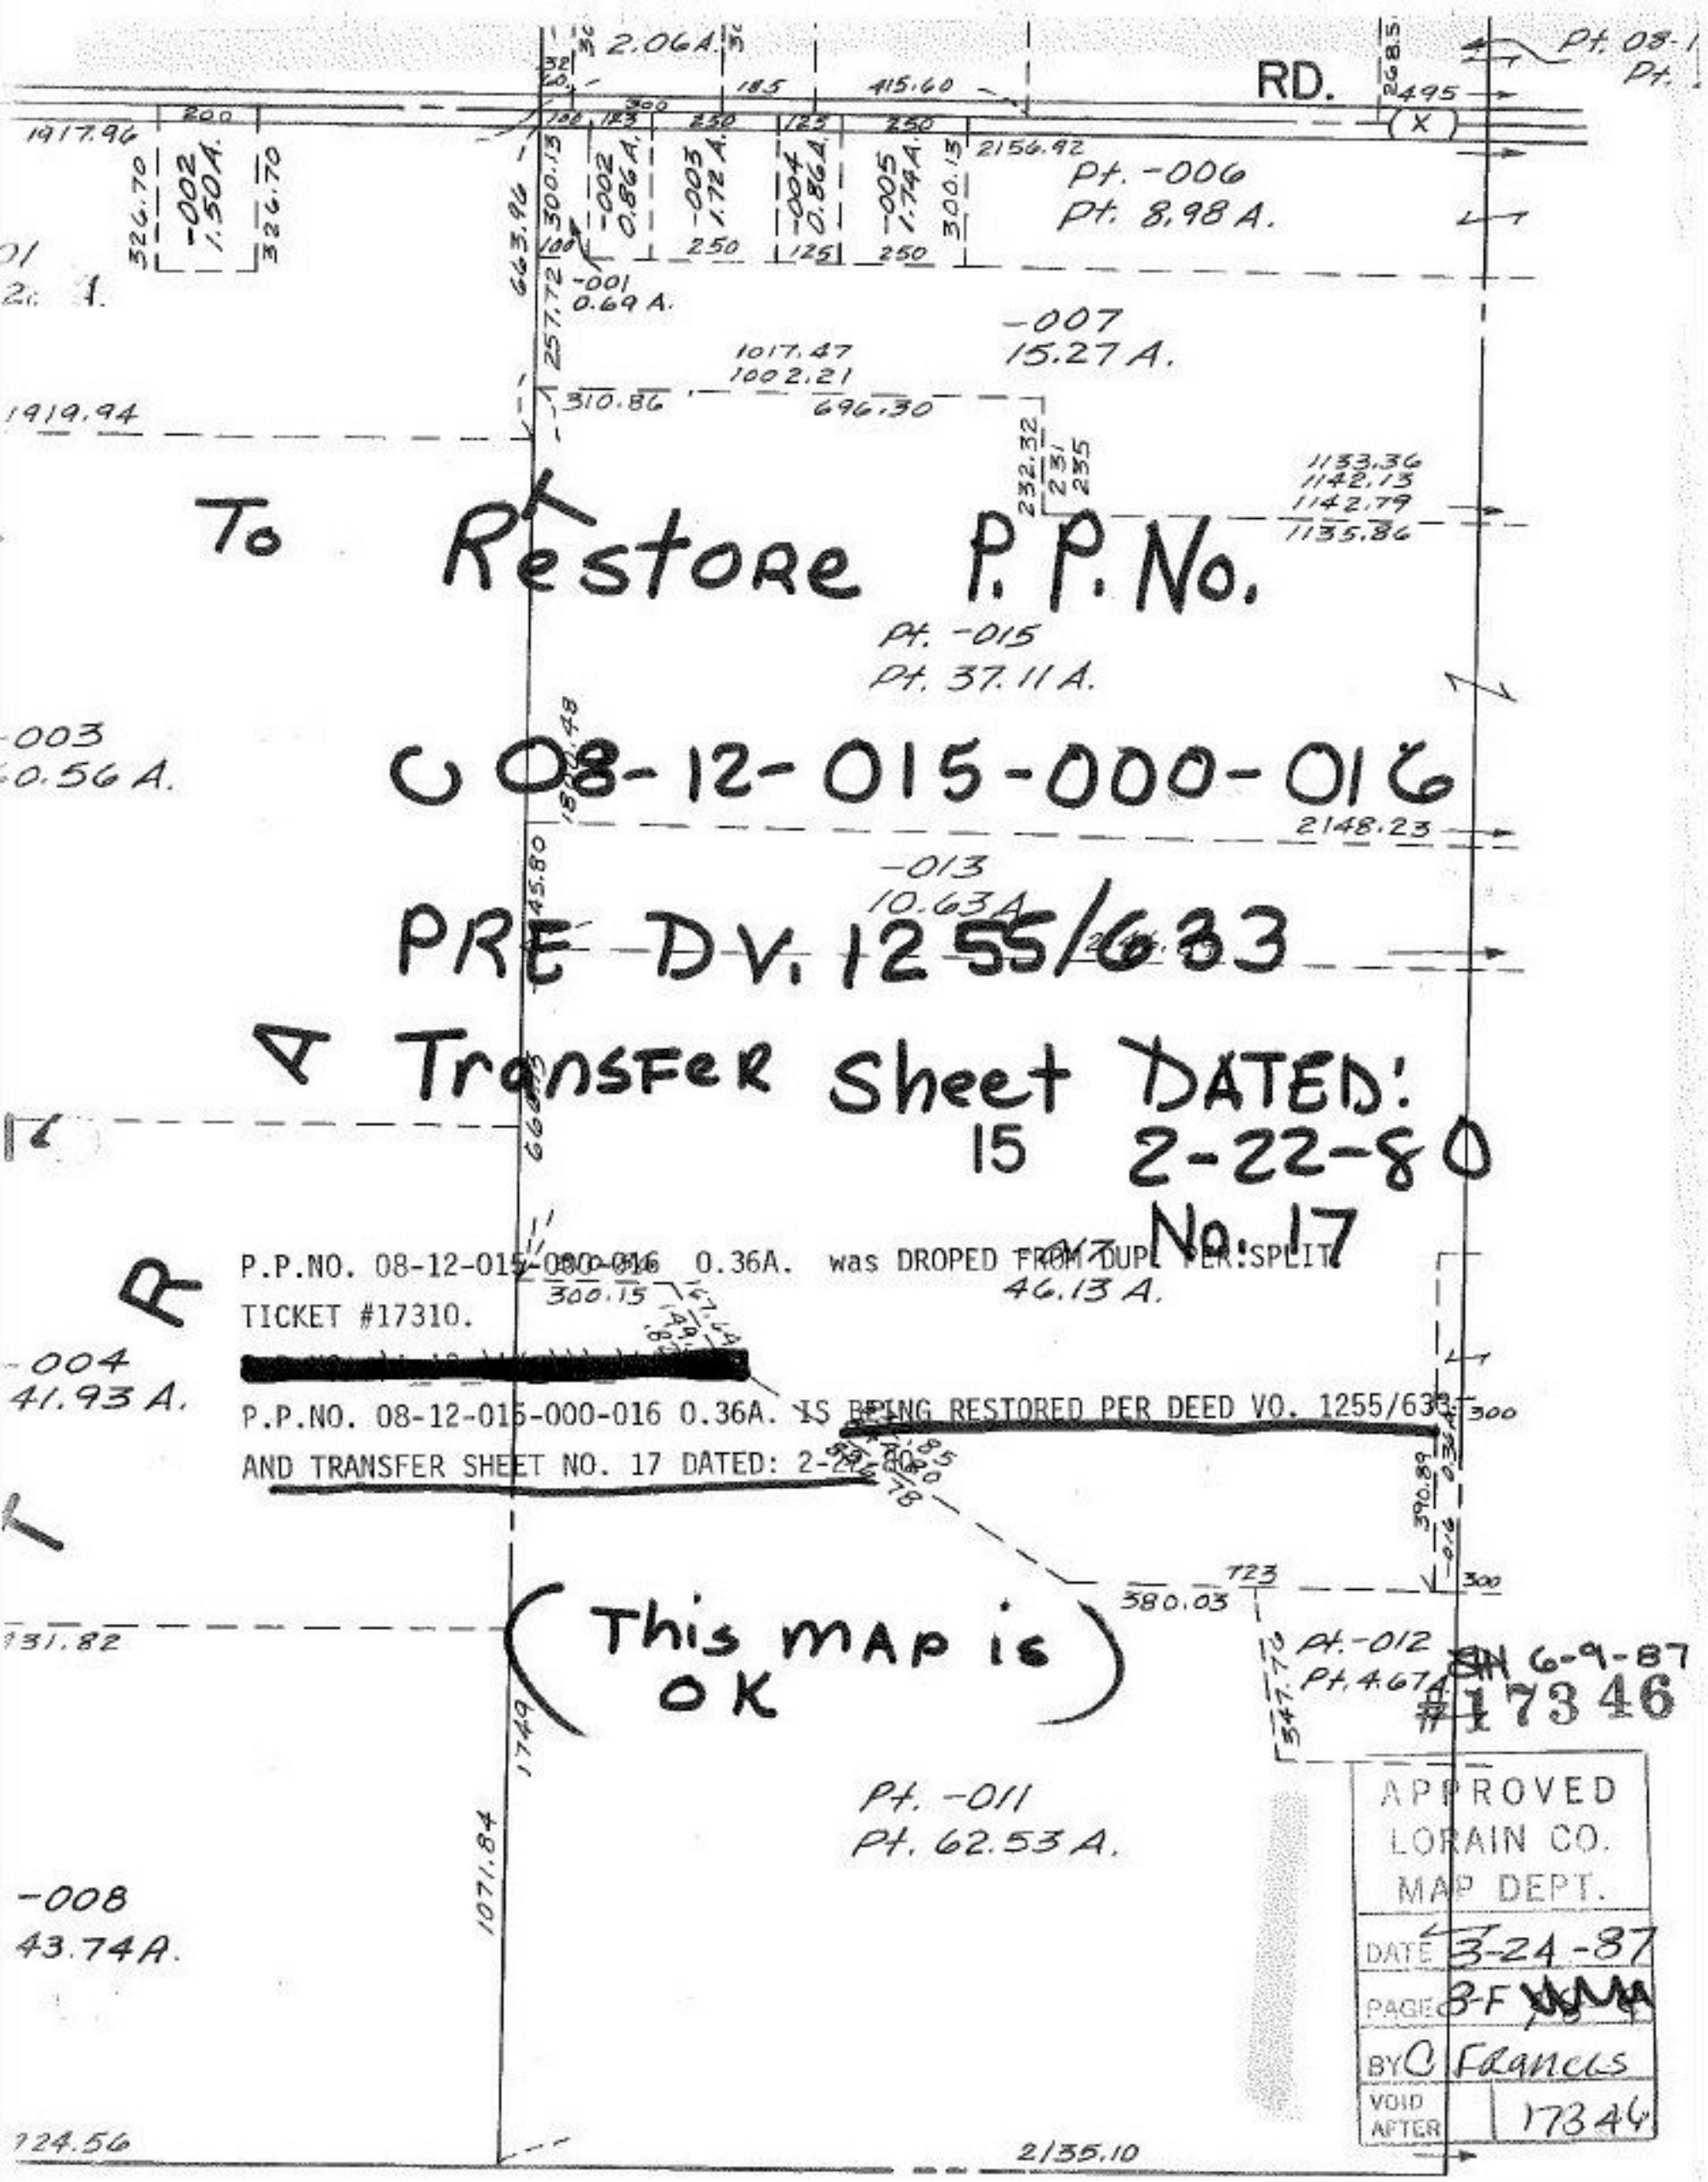

RD.
2.06A.
415.60
495
Pt. 08-1
Pt.
1917.96
326.70
-002
1.50A.
326.70
663.96
300.13
-002
0.86A.
-003
1.72A.
-004
0.86A.
-005
1.74A.
300.13
2156.92
Pt. -006
Pt. 8.98 A.
-001
0.69 A.
257.72
-007
15.27 A.
1017.47
1002.21
310.86
696.30
1919.94
232.32
231
235
1133.36
1142.13
1142.79
1135.86
To Restore P.P. No.
Pt. -015
Pt. 37.11 A.
-003
0.56 A.
C 08-12-015-000-016
2148.23
-013
10.63A.
PRE DV. 1255/633
Transfer Sheet DATED:
15 2-22-80
No. 17
46.13 A.
300.15
-004
41.93 A.
P.P.NO. 08-12-015-000-016 0.36A. was DROPED FROM DUPL PER SPLIT
TICKET #17310.
[redacted]
P.P.NO. 08-12-015-000-016 0.36A. IS BEING RESTORED PER DEED VO. 1255/633
AND TRANSFER SHEET NO. 17 DATED: 2-22-80
390.89
723
380.03
Pt. -012
Pt. 4.67A.
347.76
SH 6-9-87
#17346
(This map is OK)
1749
1071.84
Pt. -011
Pt. 62.53 A.
-008
43.74A.
724.56
2135.10
APPROVED
LORAIN CO.
MAP DEPT.
DATE 3-24-87
PAGE 3-F
BY C Francis
VOID AFTER 17346