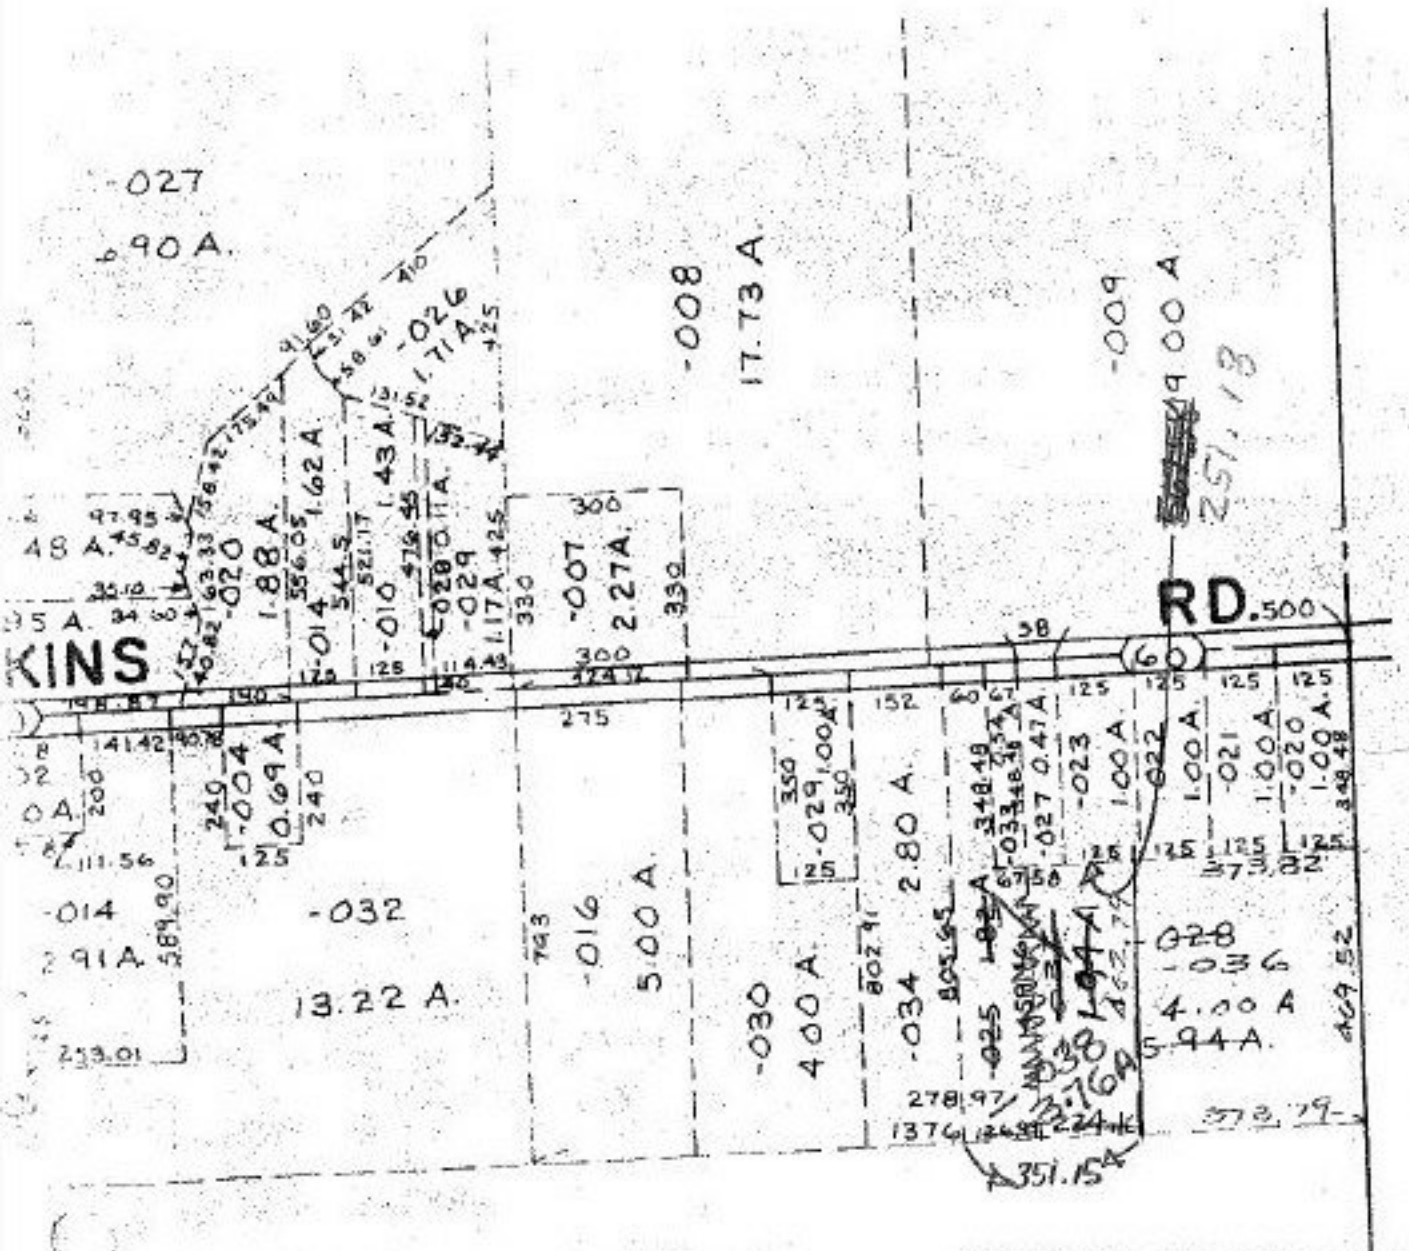


# COMBINATION 17349

72 -035
61.34 A.

-007
50.00 A.

-001
25.00 A

12-00-072-000
PRIOR DEED D 1172/904
SURVEYED BY: K.S.A.
1" = 1,250.00

APPROVED
LORAIN CO.
MAP DEPT.
DATE 3-27-87
PAGE 12-E
BY C. Francis
VOID AFTER 17349

#17277

APPROVED
LORAIN CO.
MAP DEPT.
DATE 2-19-87
PAGE 12-E
BY C.F. Francis
VOID AFTER 17277