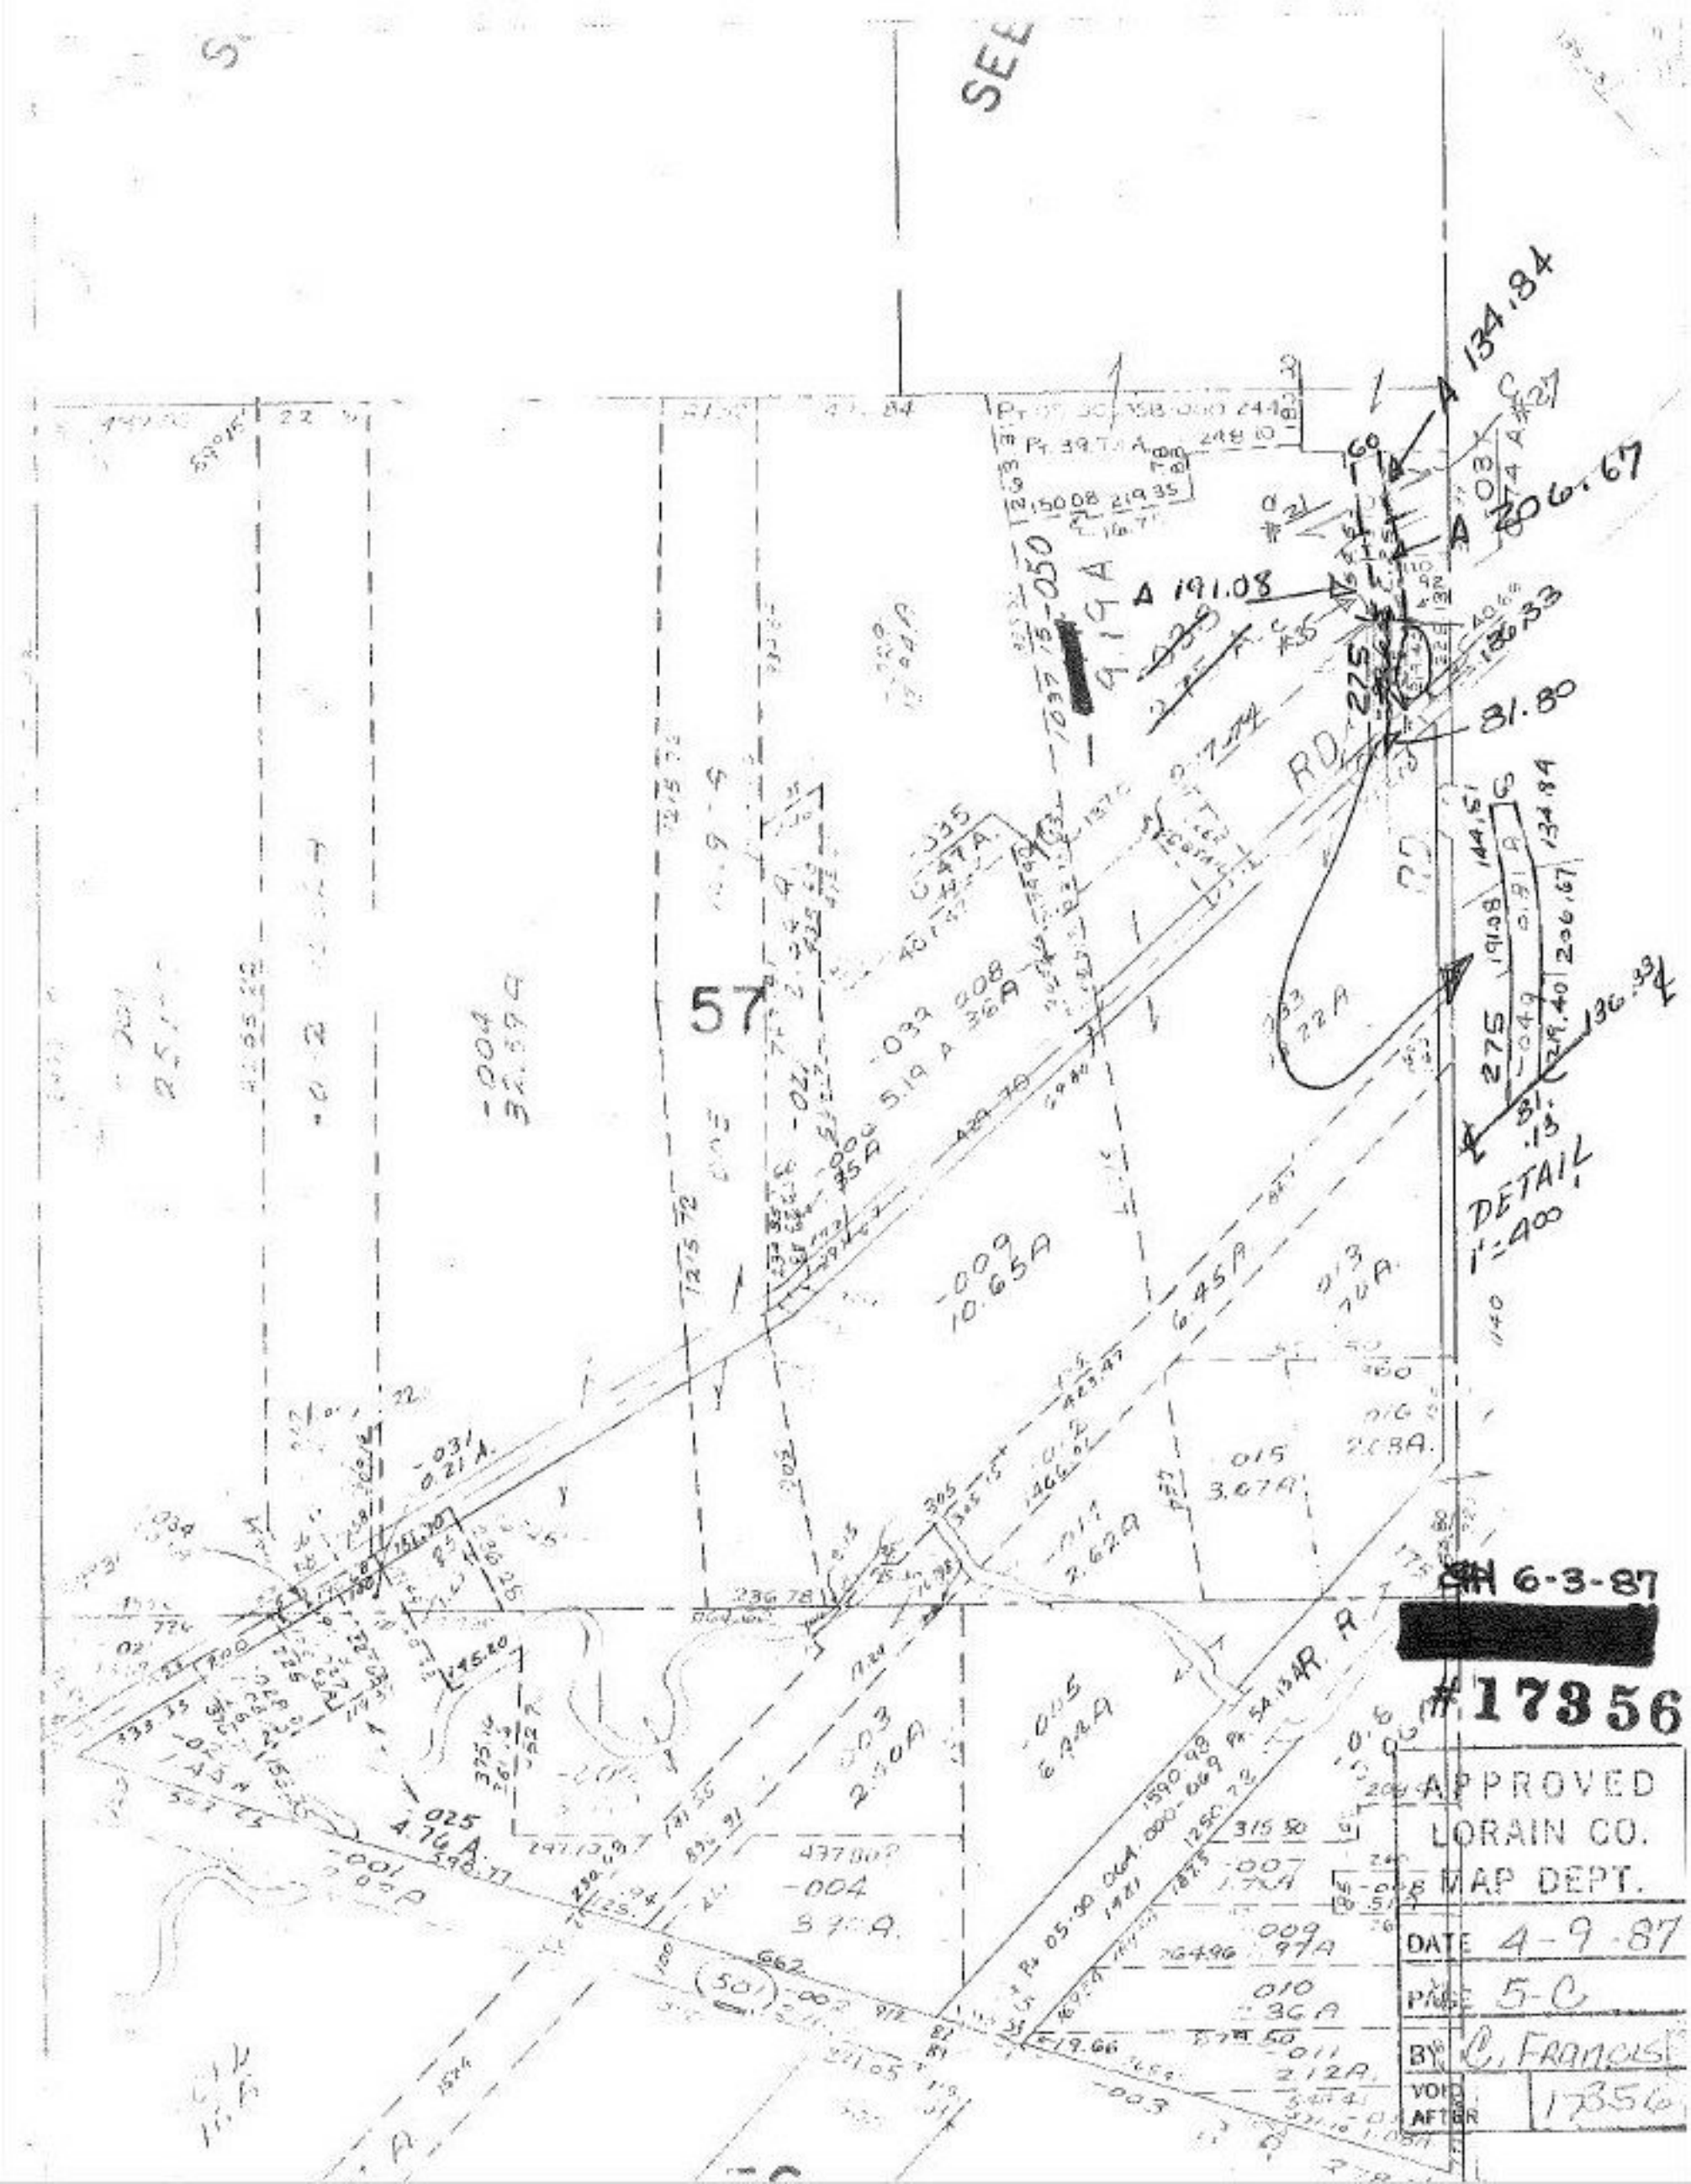

SH 6-3-87

[redacted]

#17356

APPROVED
LORAIN CO.
MAP DEPT.

DATE 4-9-87

PAGE 5-C

BY C. Francis

VOID AFTER 17356