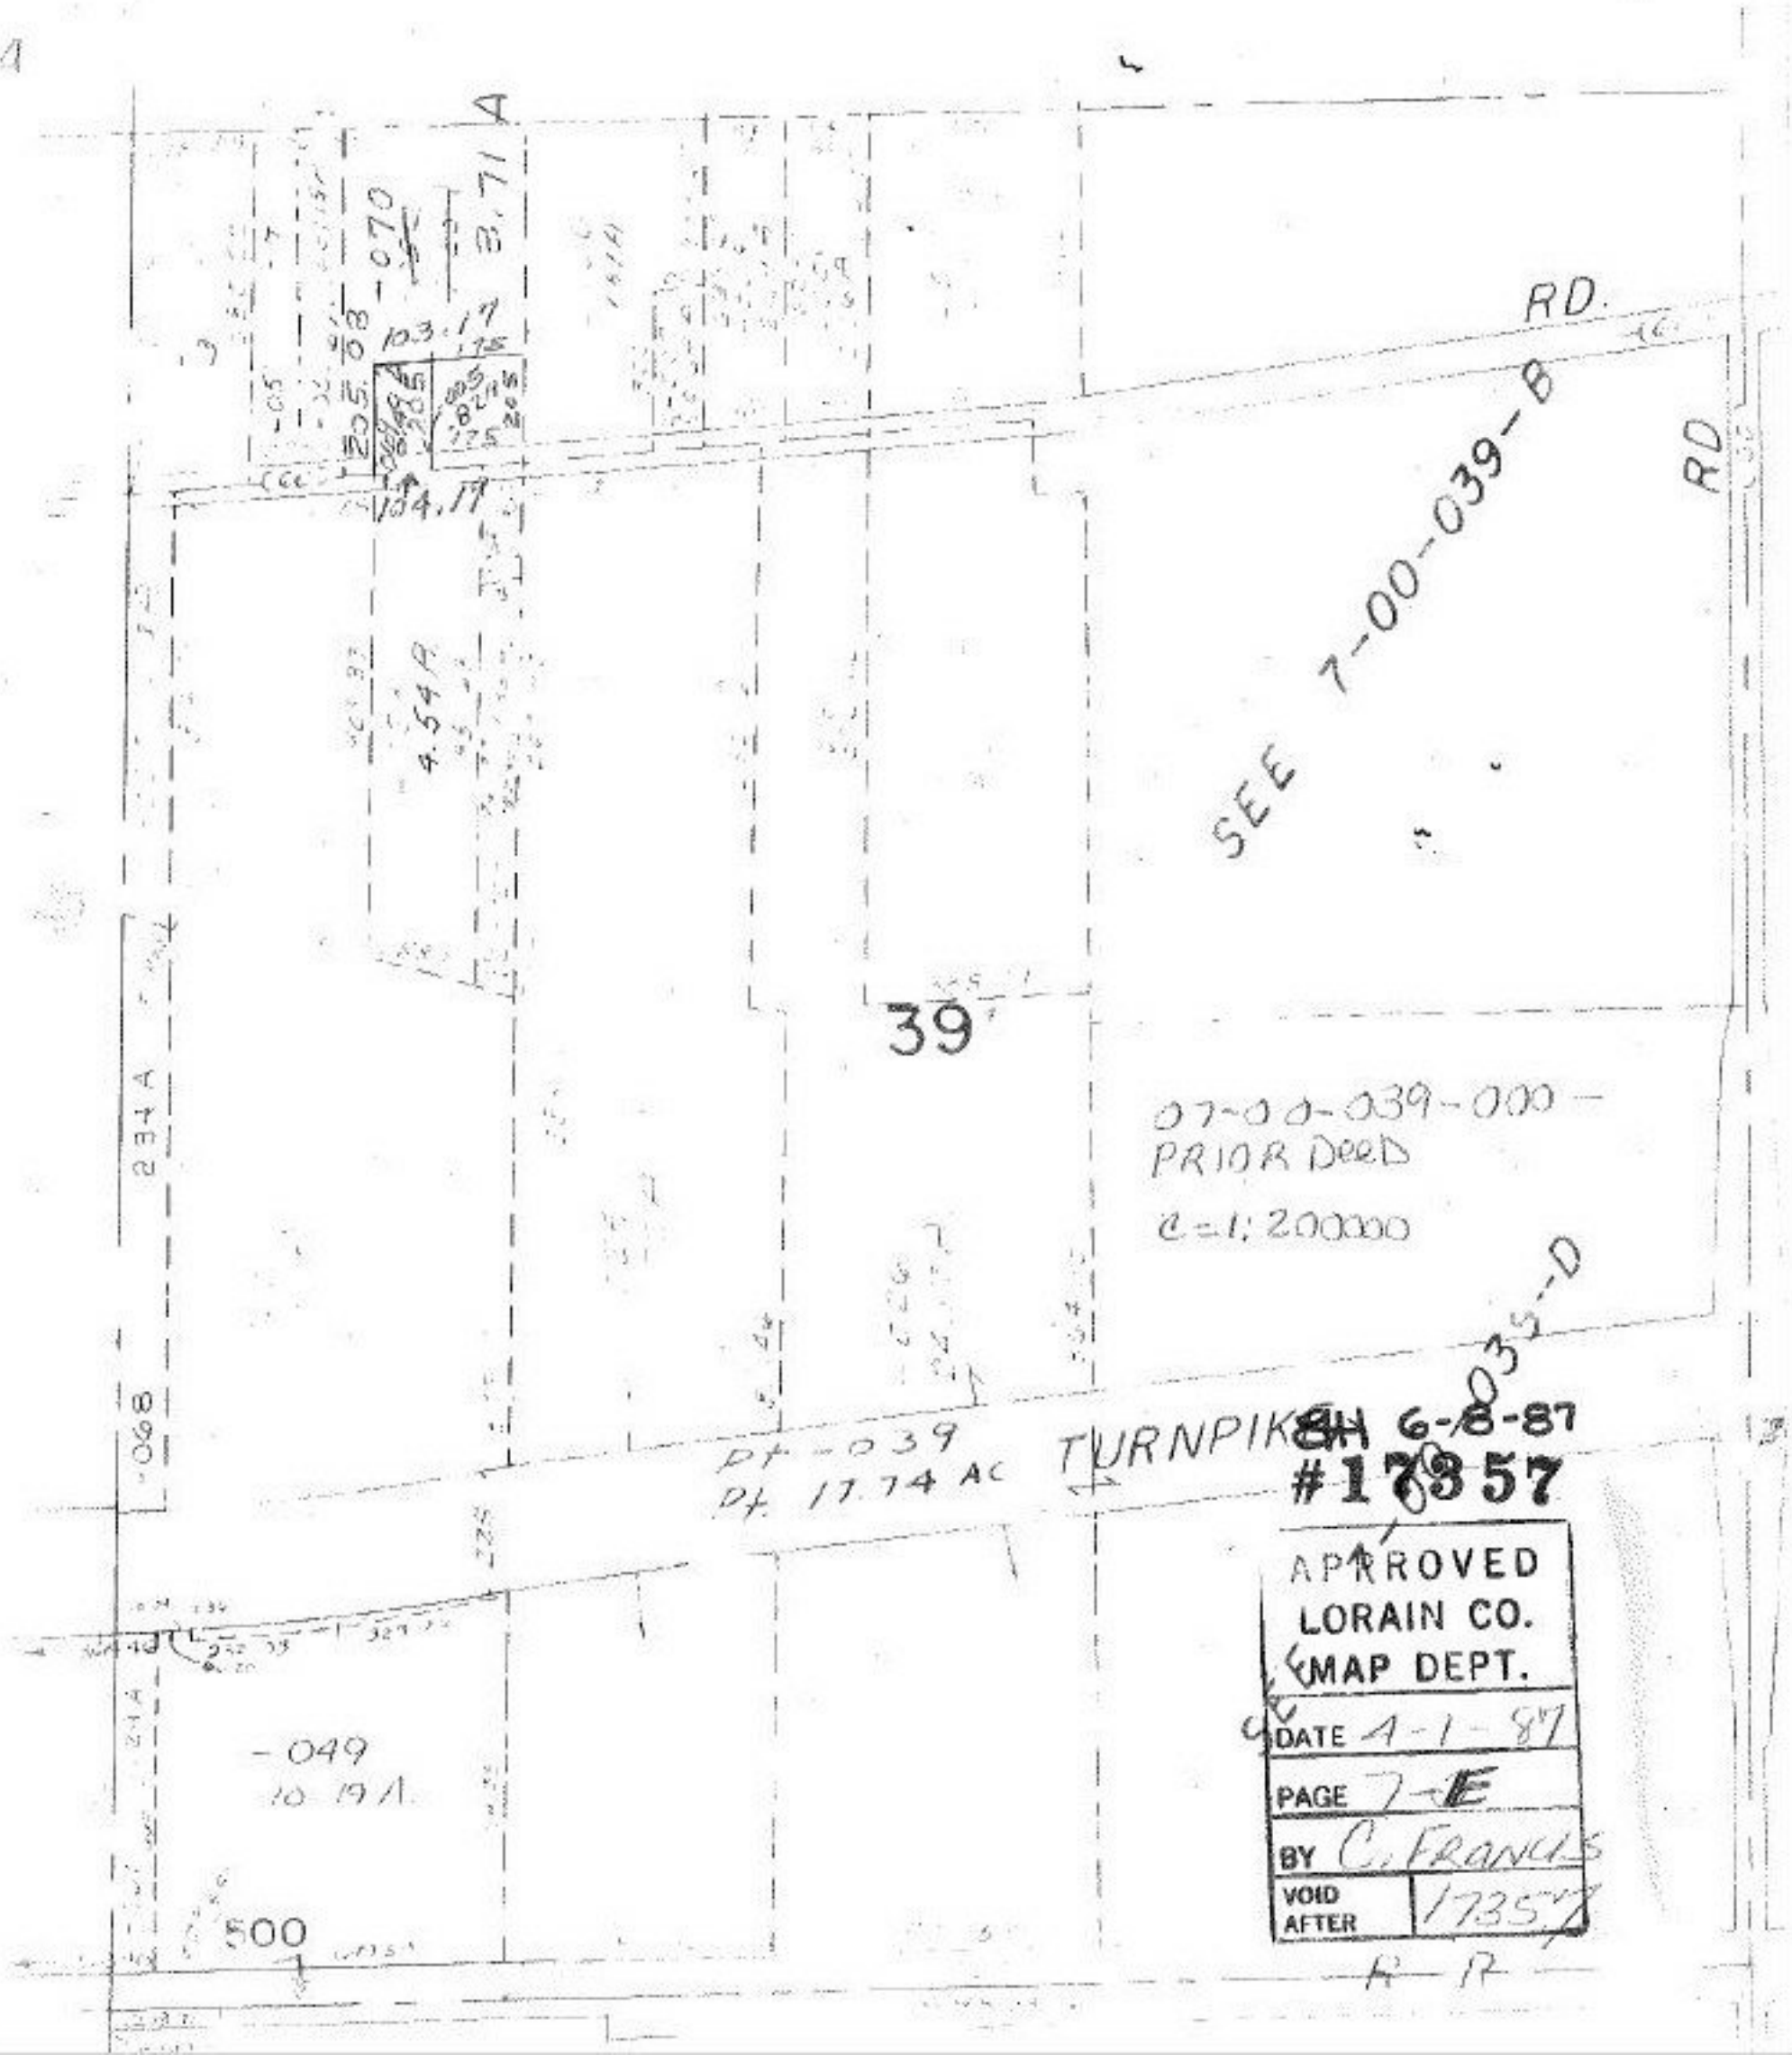

SH 6-8-87
#17357
APPROVED
LORAIN CO.
MAP DEPT.
DATE 4-1-87
PAGE 7-E
BY C. FRANCIS
VOID AFTER 17357