11-25-87

SEE 9-00-065-B

1736
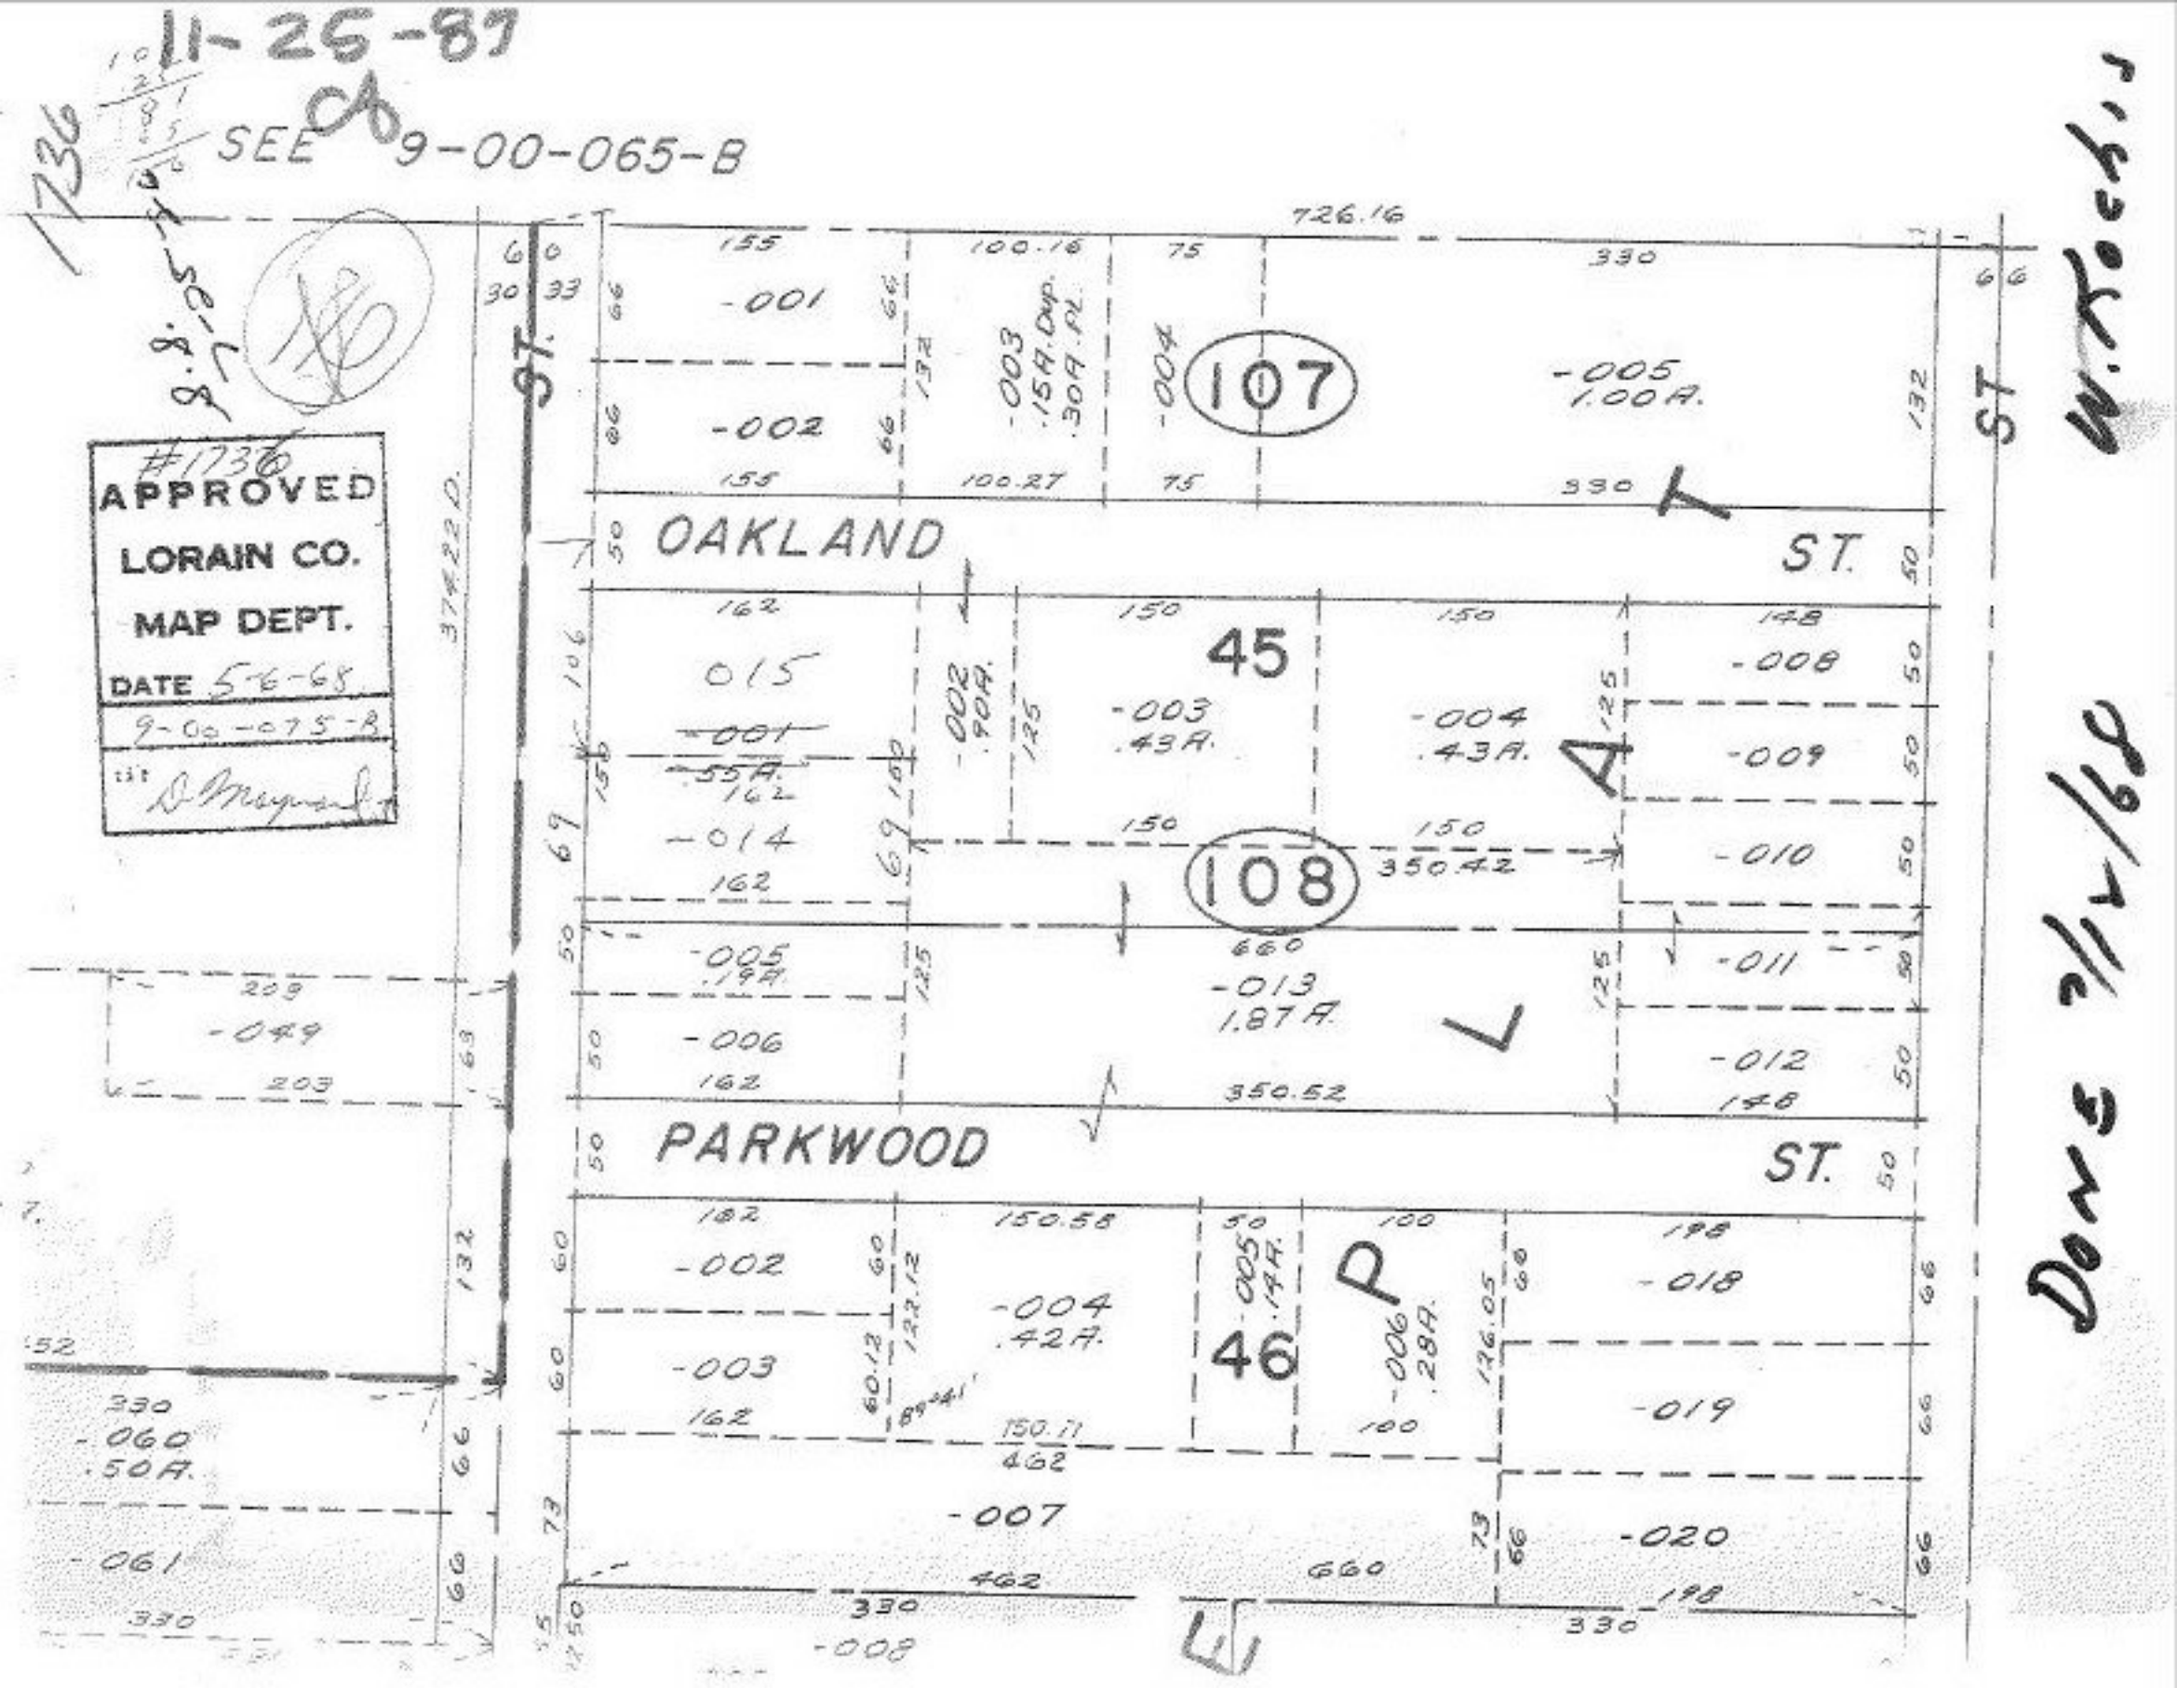
#1736
APPROVED
LORAIN CO.
MAP DEPT.
DATE 5-6-68
9-00-075-B