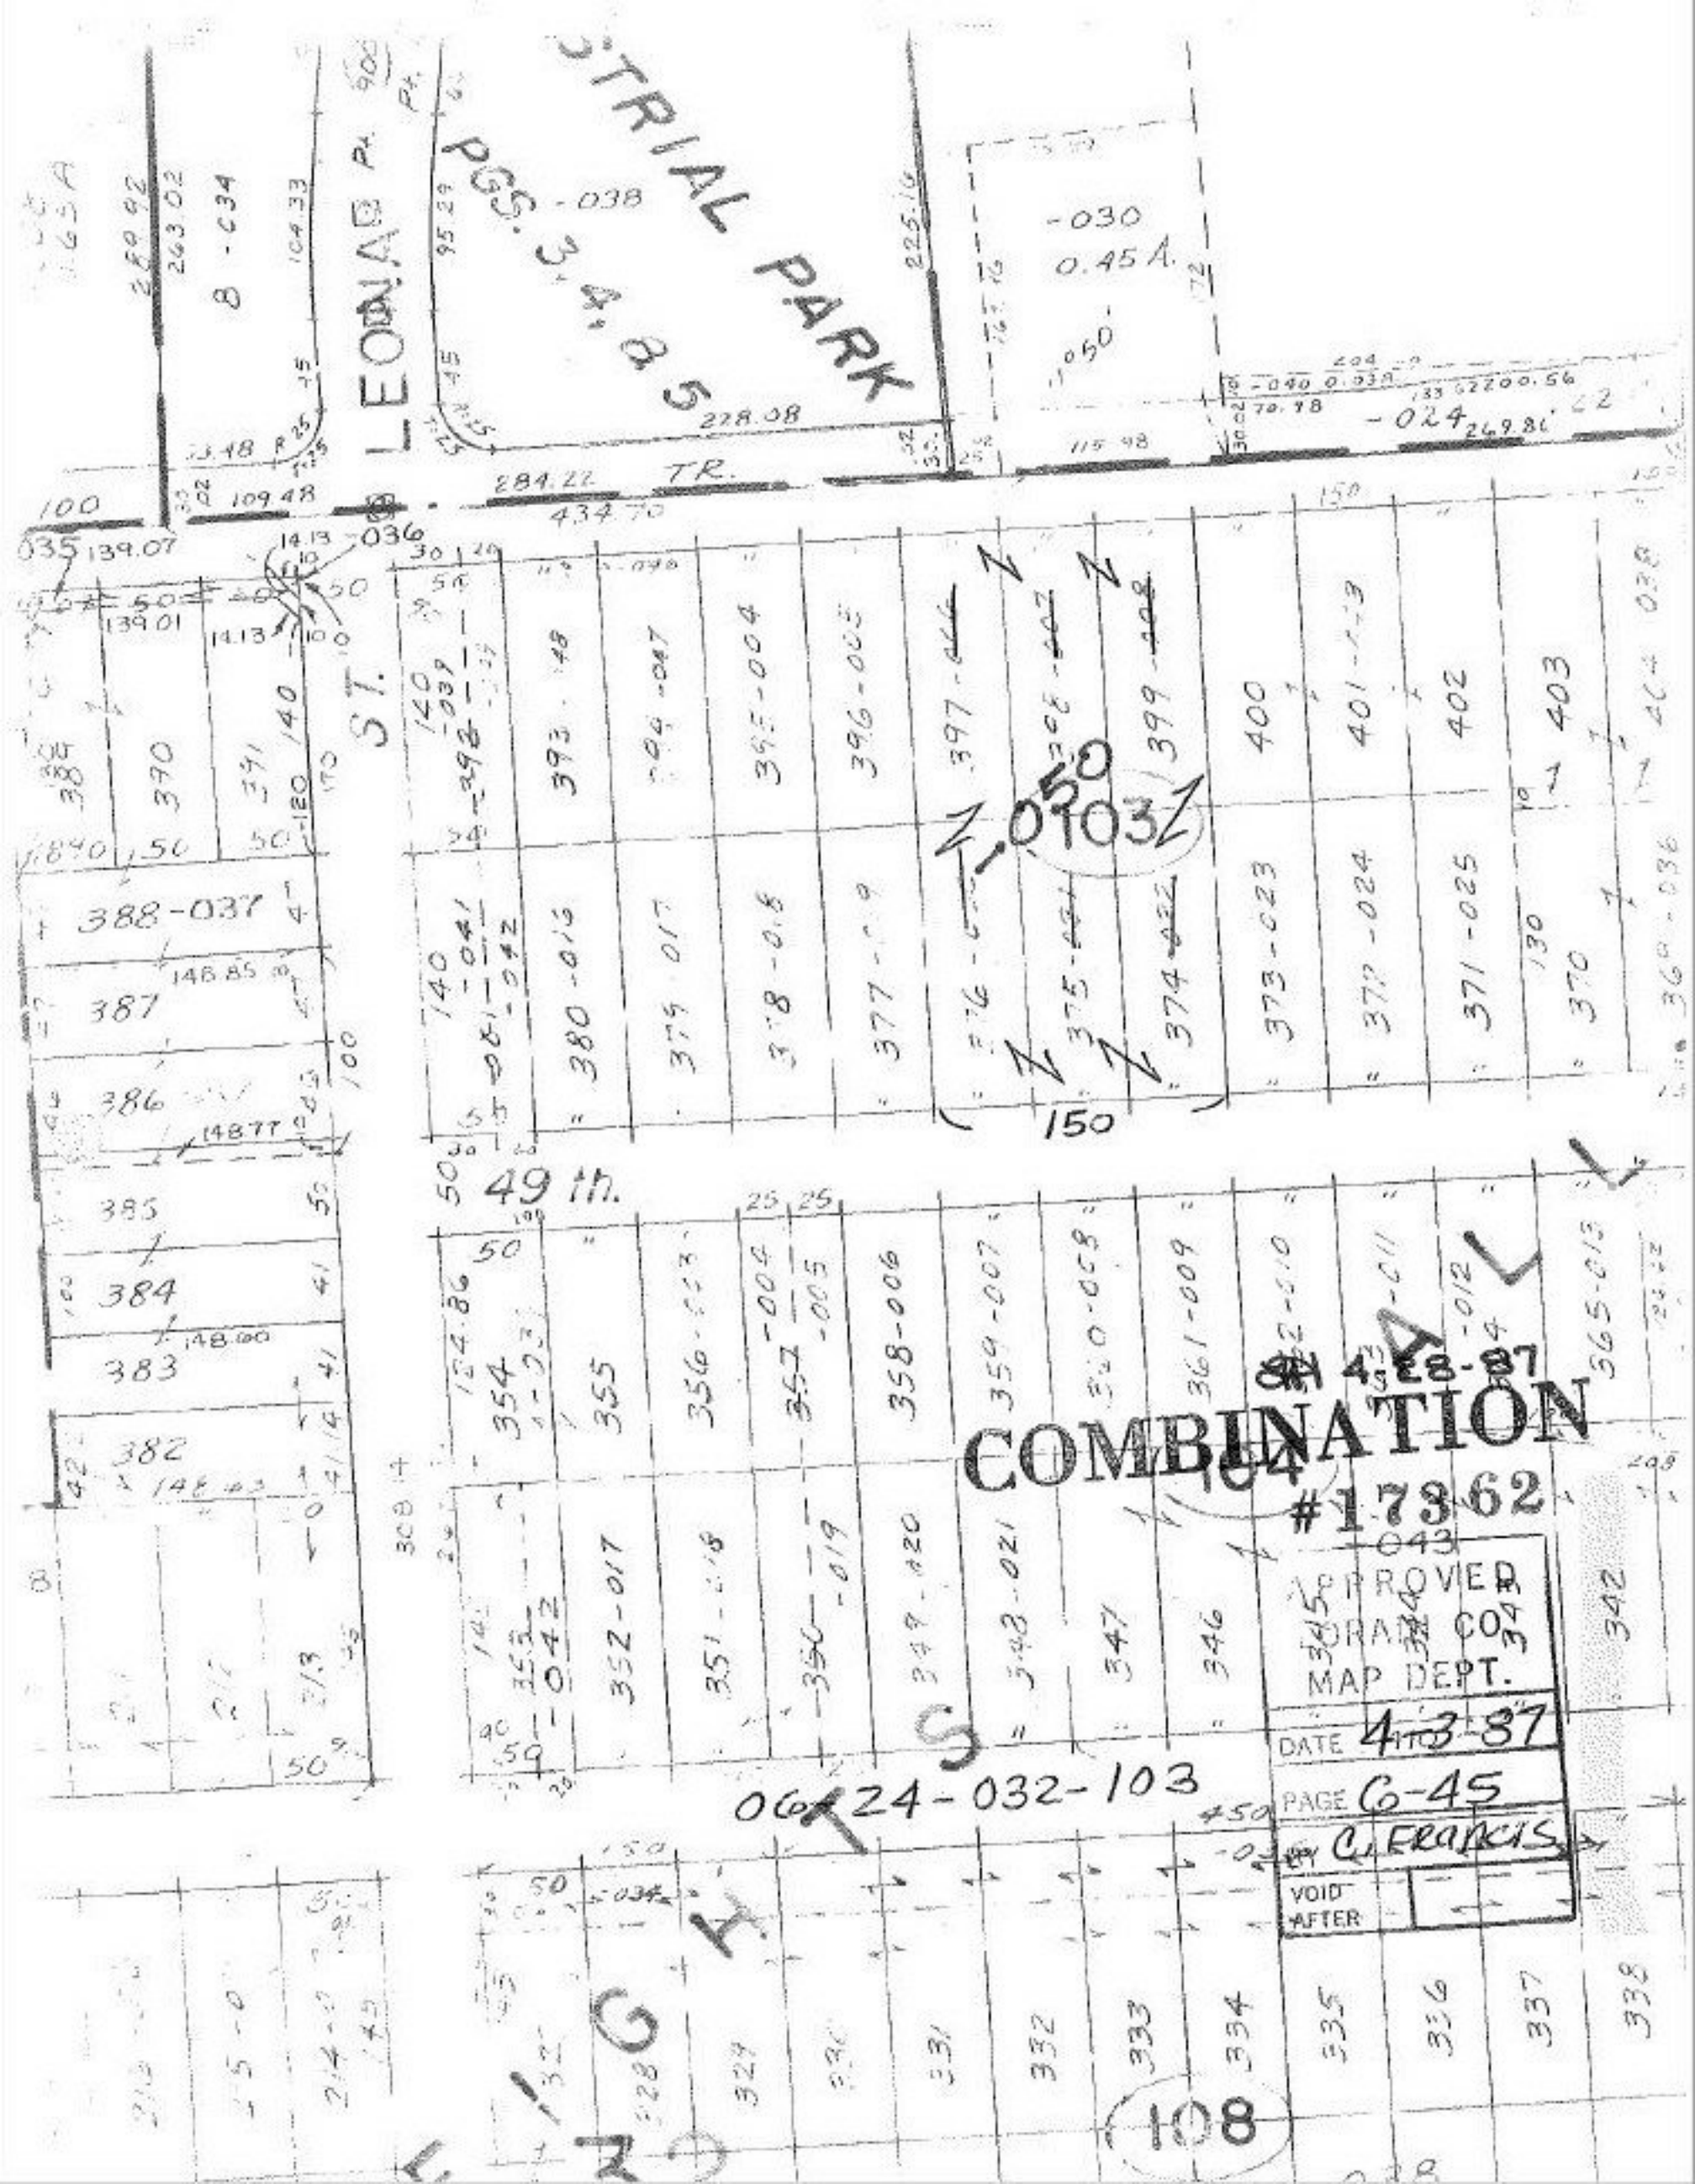

STRIAL PARK
PGS. 3, 4, & 5
LEONARD
ST.
49 th.
-030
0.45 A.
-024
-038
-036
-035
388-037
387
386
385
384
383
382
390
391
393
395-004
396-005
397
399
400
401
402
403
380-016
379-017
378-018
377
373-023
372-024
371-025
370
354
355
356
357
358-006
359-007
360-008
361-009
362-010
365-013
352-017
351-018
350-019
349-020
348-021
347
346
342
338
337
336
335
334
333
332
331
330
329
328
-050
-0103
150
104
108
06-24-032-103
SH 4-28-87
COMBINATION
#17362
APPROVED
ORAN CO.
MAP DEPT.
DATE 4-3-87
PAGE 6-45
BY C. FRANCIS
VOID AFTER