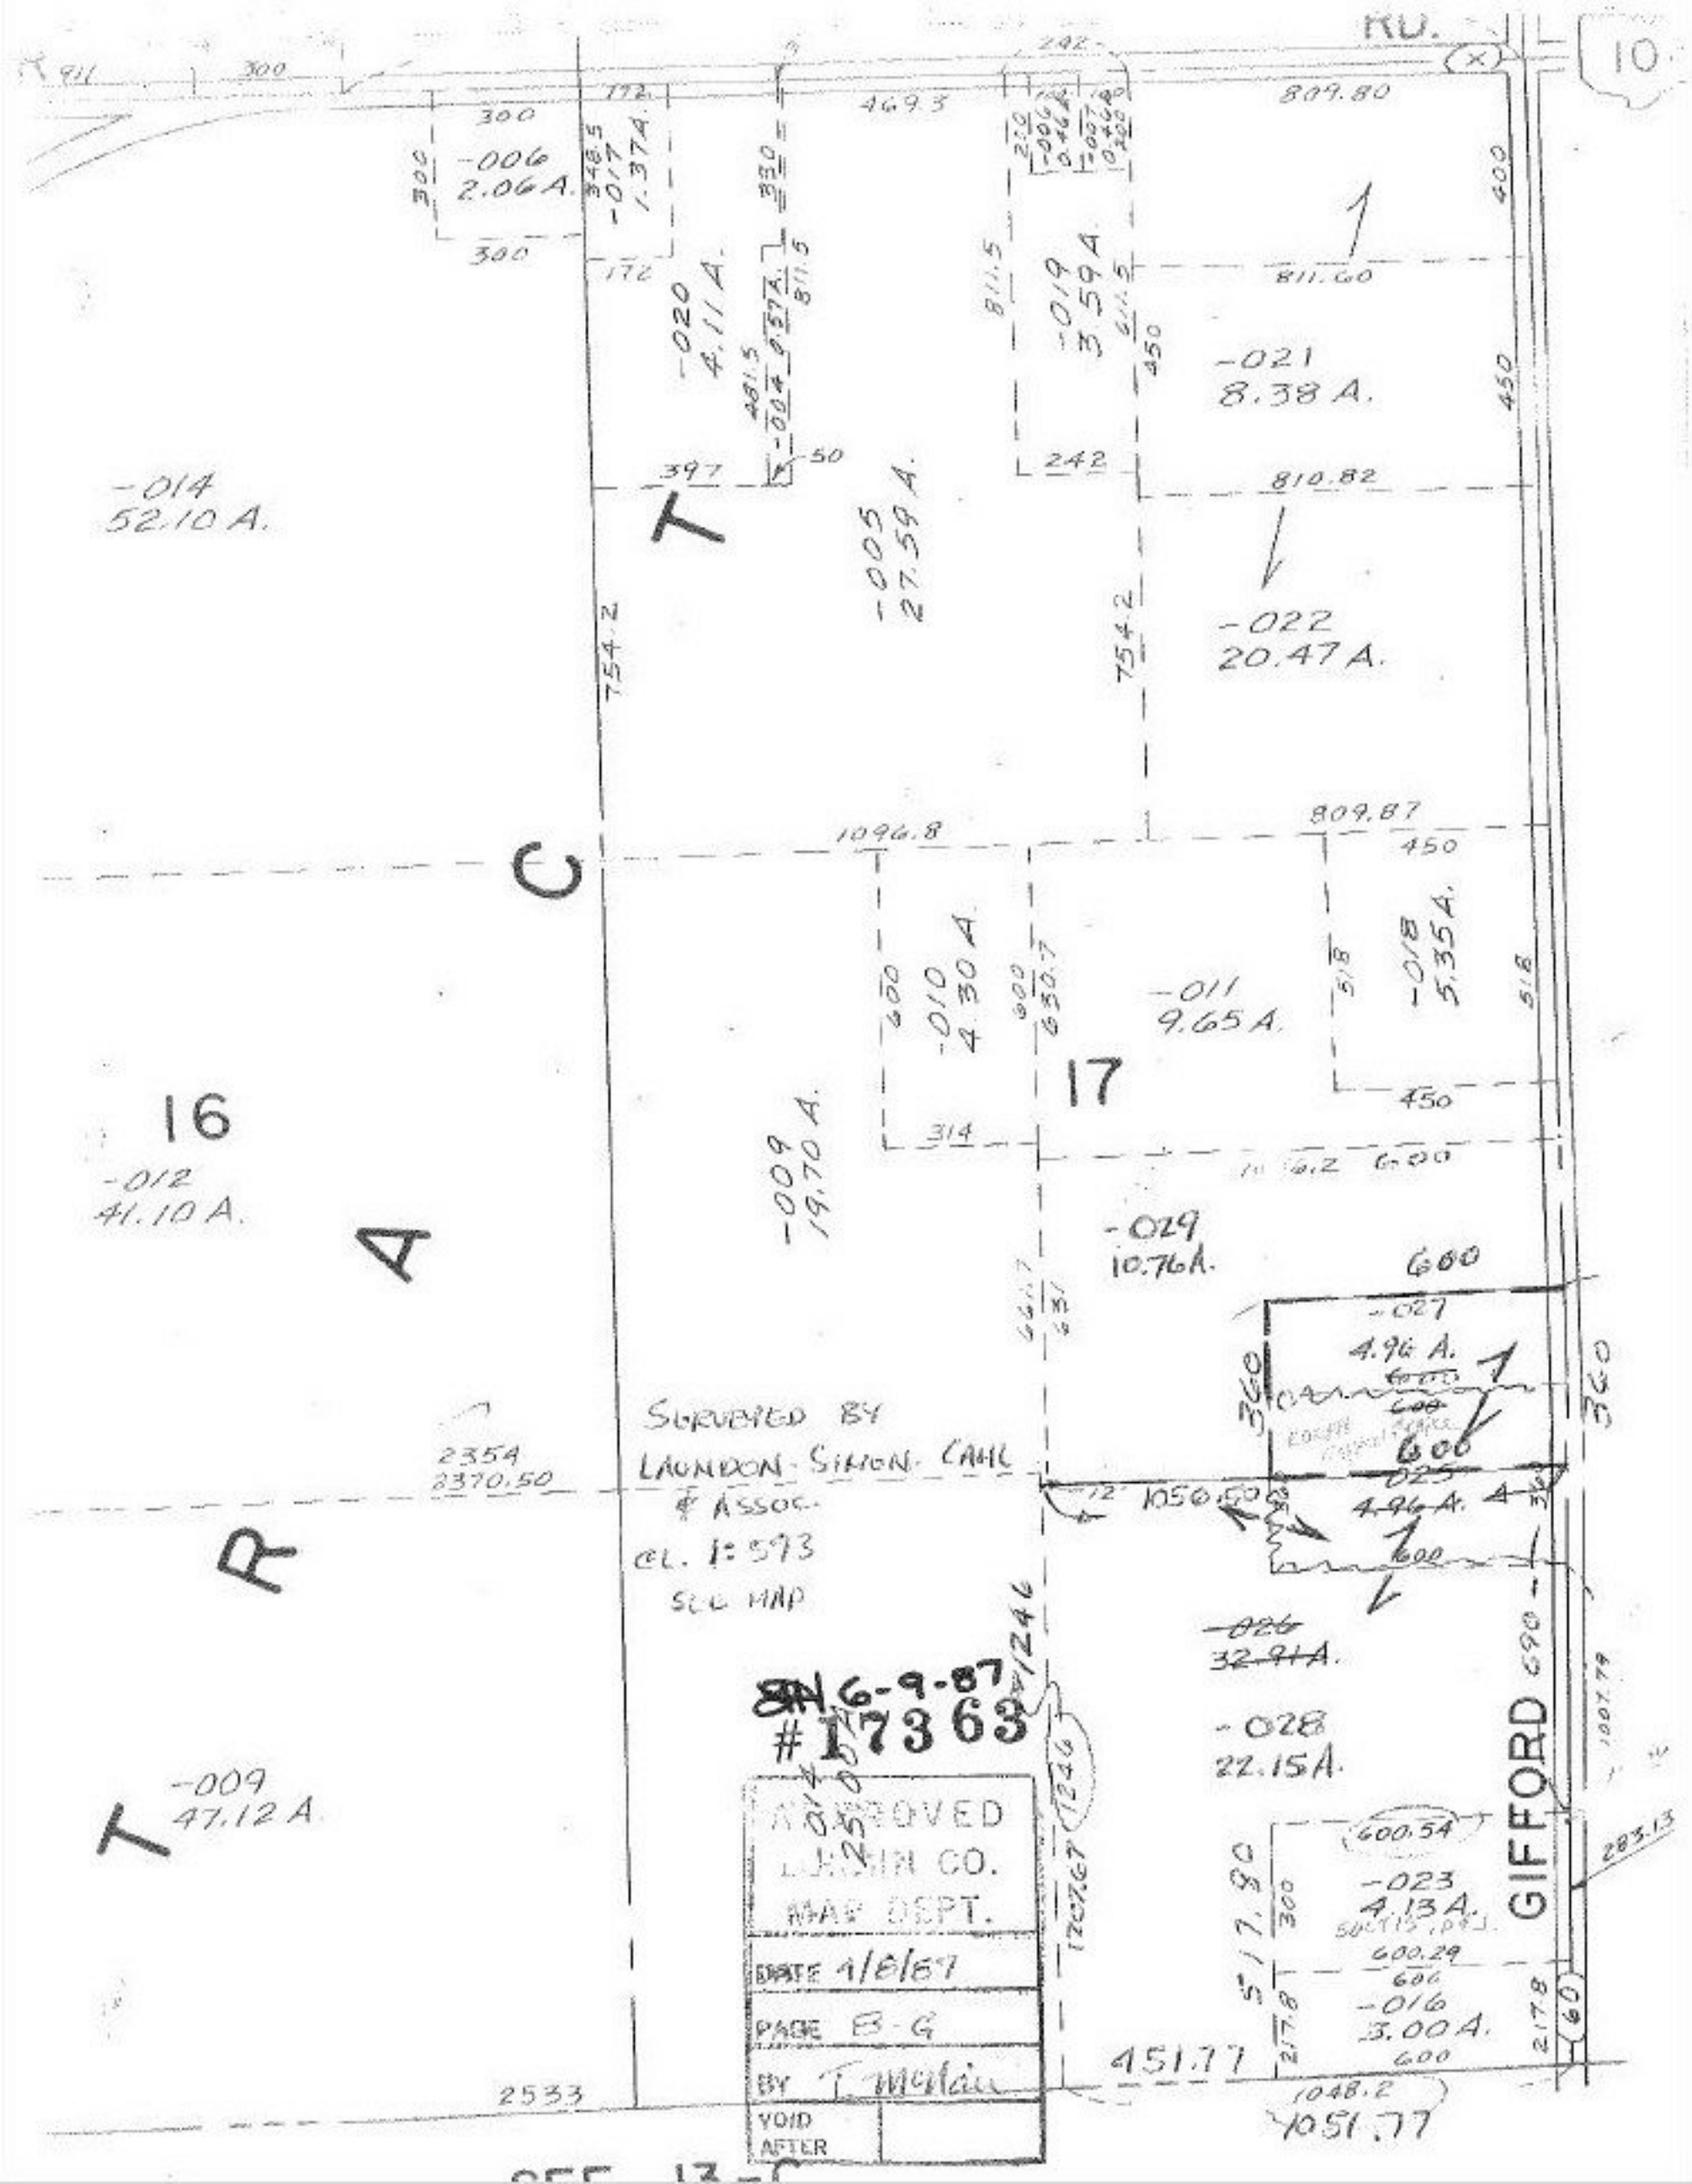
RU.
10
-006
2.06 A.
-017
1.37 A.
-020
4.11 A.
-019
3.59 A.
-021
8.38 A.
-014
52.10 A.
-005
27.59 A.
-022
20.47 A.
-010
4.30 A.
-011
9.65 A.
-018
5.35 A.
16
17
-012
41.10 A.
-009
19.70 A.
-029
10.76 A.
-027
4.96 A.
-025
4.96 A.
SURVEYED BY
LAUNDON-SIMON-CAHL
& ASSOC.
CL. 1:593
SEE MAP
-026
32.91 A.
-028
22.15 A.
-009
47.12 A.
-023
4.13 A.
-016
3.00 A.
GIFFORD
APPROVED
LANDIN CO.
MAP DEPT.
DATE 4/8/87
PAGE B-G
BY T. McGlin
VOID AFTER
SEN 6-9-87
#17363