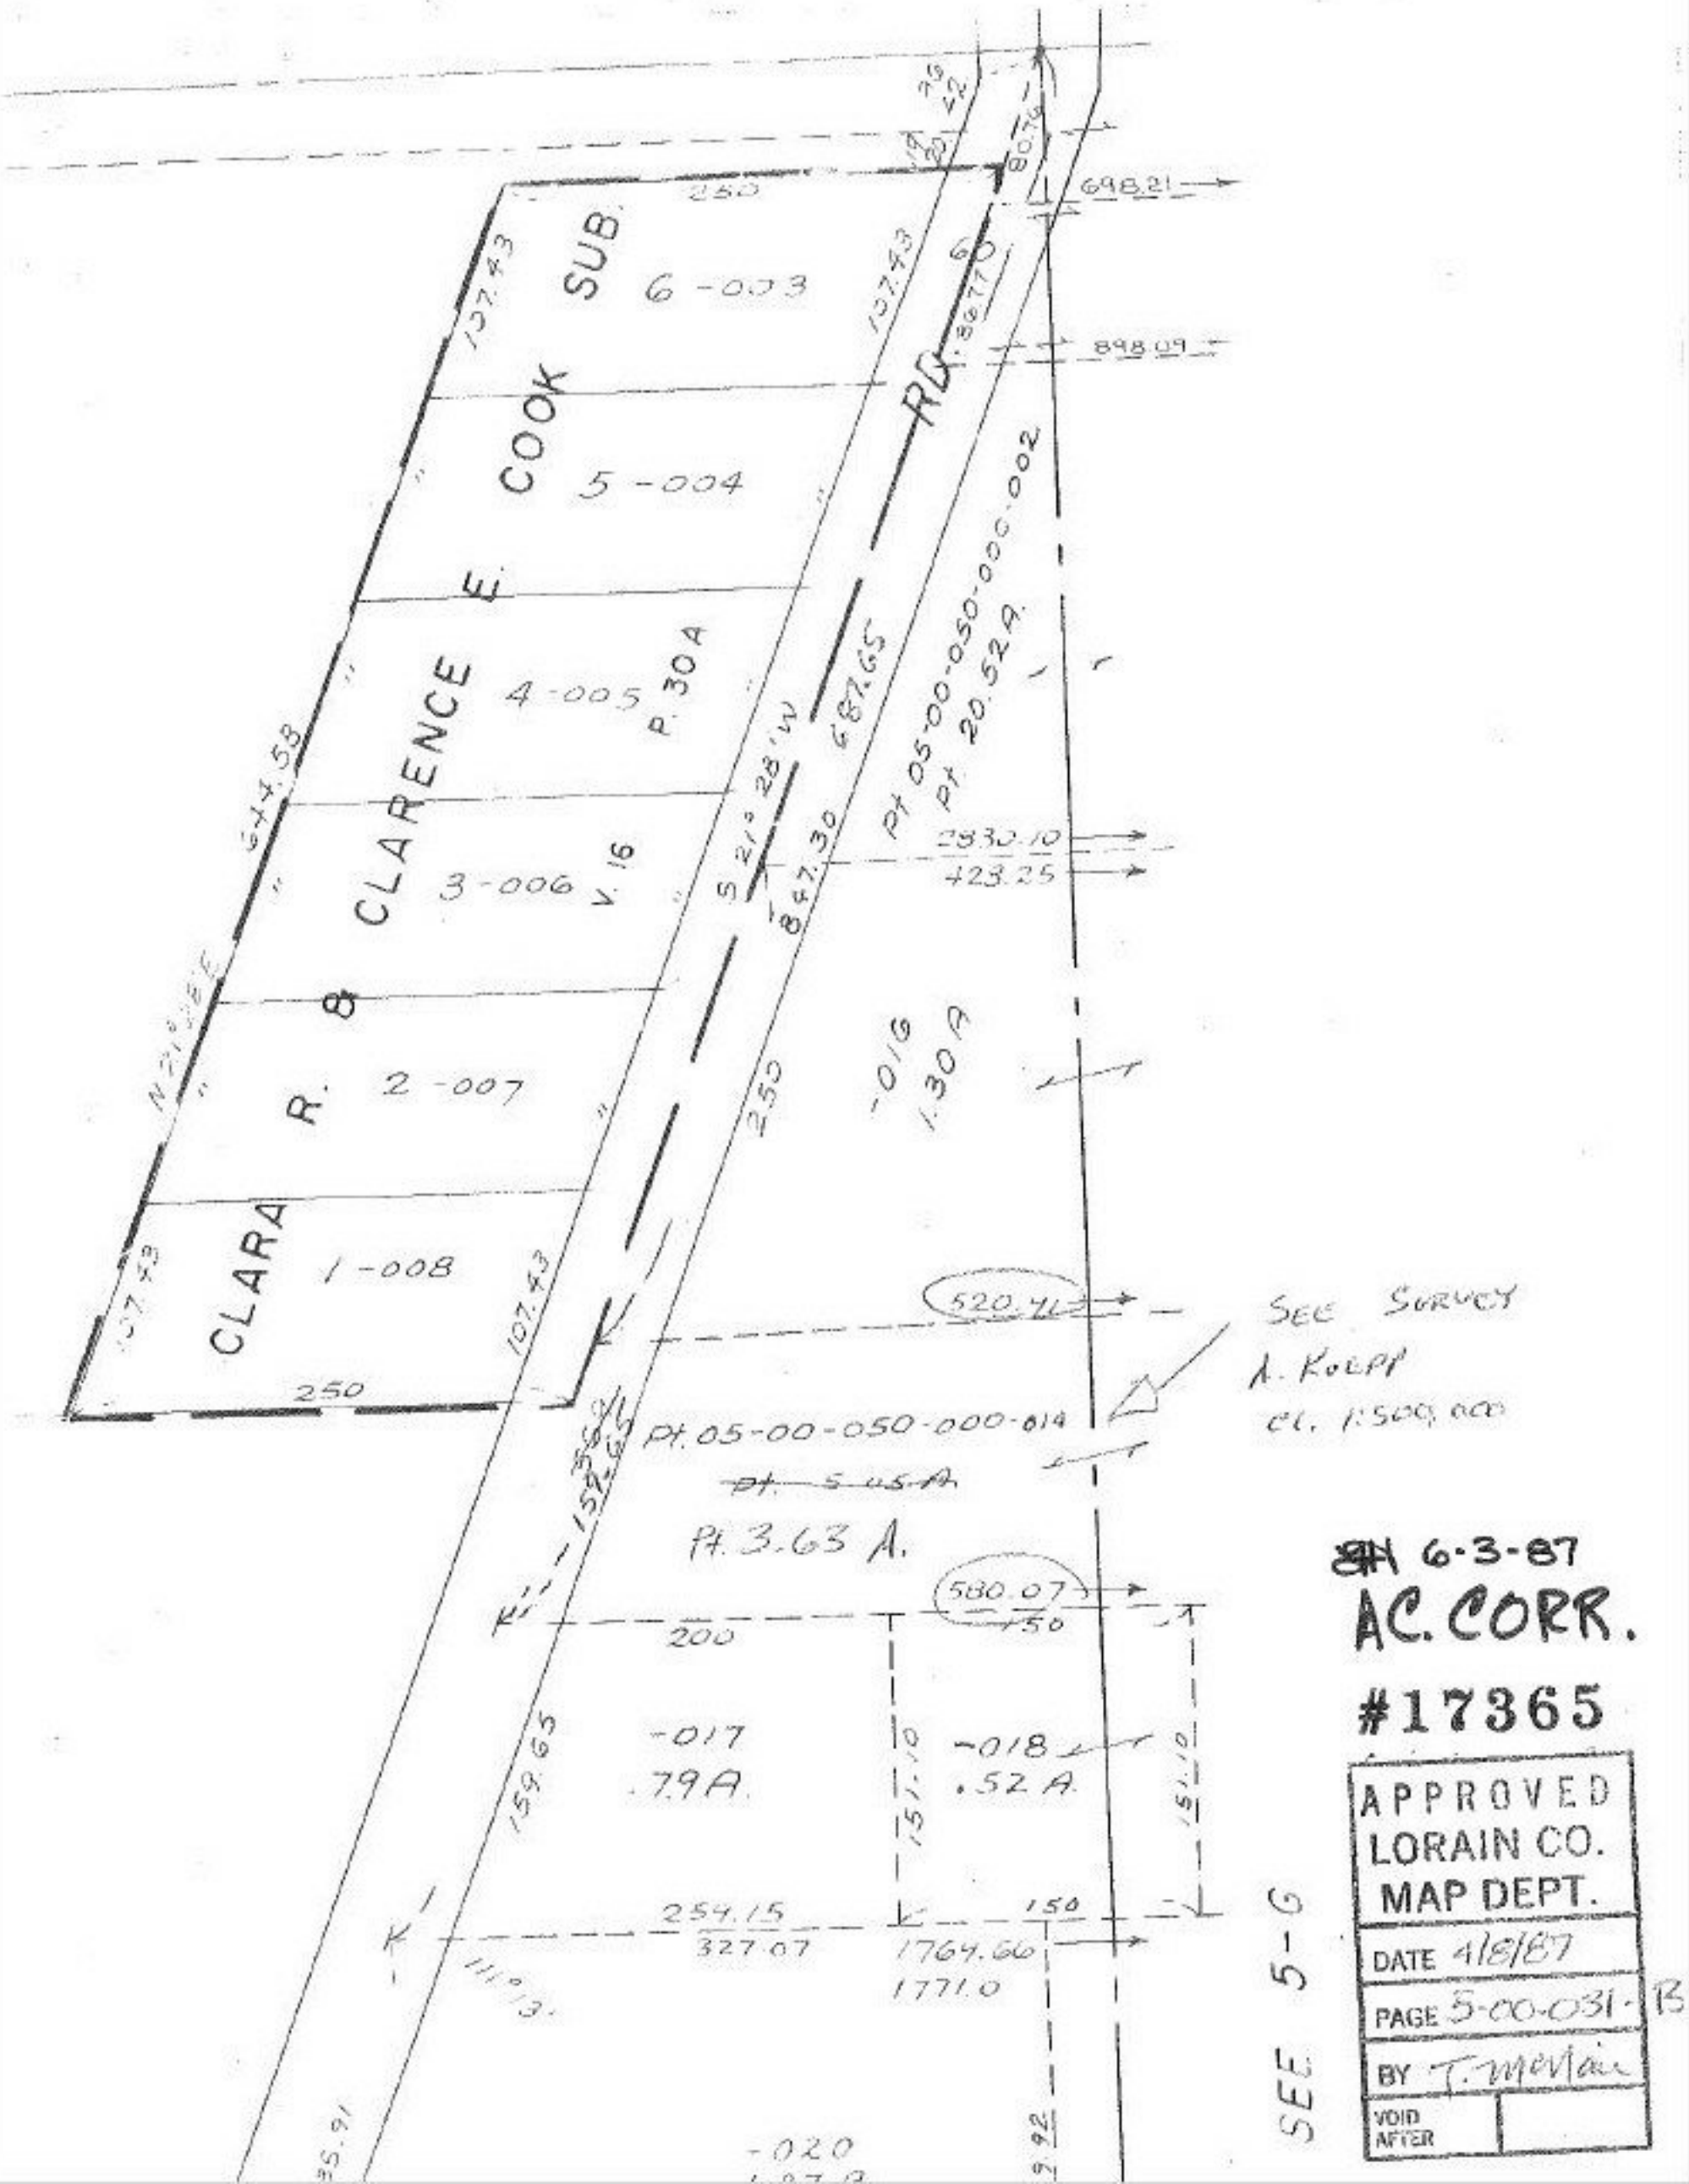

6-3-87

AC. CORR.

#17365

APPROVED
LORAIN CO.
MAP DEPT.

DATE 4/8/87

PAGE 5-00-031-B

BY T. McNair

VOID AFTER